



8163 Rochester Avenue
Rancho Cucamonga, CA 91730
P. +1 909-987-0909
PBK.com

March 11, 2024

TO : All Bidders
FROM : Bob Lavey
PROJECT : Nogales High School New Building and Aquatic Center
Project W2110000AR.41
DSA : 03-122782 / File 19-92
SUBJECT : Addendum 3

The following changes, omissions, and/or additions to the Technical Specifications and/or Drawings shall apply to proposals made for and to the execution of the various parts of the work affected thereby, and all other conditions shall remain the same.

Careful note of the Addendum shall be taken by all parties of interest so that the proper allowances may be made in strict accordance with the Addendum, and that all trades shall be fully advised in the performance of the work which will be required of them.

Bidder shall acknowledge receipt of this Addendum in the space provided on the Bid Form. Failure to do so may subject Bidder to disqualification.

In case of conflict between Drawings, Technical Specifications, and this Addendum, this Addendum shall govern.

3. PROJECT MANUAL

3.1 Addendum 1 - SECTION 08 80 00 - GLAZING

A. Item 2.7: Remove this item in its entirety and replace with the following

"2.7 SPANDREL GLAZING

- A. Provide Sealed Insulating Glass Units with the following exception per Item B.
- B. Interior Pane: Laminated safety glass with grey translucent plastic interlayer."

3.2 Addendum 2 - DRAWING TB2.1- TECHNOLOGY BLDG B - POOL FLR PLAN

- A. A symbol of letters AP with a triangle represents : EXTERIOR WIRELESS ACCESS POINT CONNECTION. CONTRACTOR SHALL PROVIDE AND INSTALL (2)CAT 6/6A CABLES ROUTED TO NEAREST IDF. PROVIDE WEATHERPROOF BOX AND CONDUIT AS NOTED FOR SURFACE MOUNTED OUTLETS. PROVIDE 10' SERVICE LOOP UPSTREAM OF TERMINATION POINT. WALL/ COLUMN MOUNTED DEVICES SHALL BE INSTALLED AT 10' A.F.F.

3.3 Addendum 2 - DRAWING A5.4 - OVERALL BUILDING SECTIONS

- A. Item 2.15: Delete this item in its entirety. Drawing A5.4 - Delta 1 has not changed and to remain.

3.4 SECTION 08 41 13 - ALUMINUM-FRAMED ENTRANCES AND STOREFRONTS

- A. Item 1.3.H: Revise the U-value to 0.36 or better.

- B. Item 1.3.I: Revise the SHGC value to 0.25 or better.

- C. Item 1.3.J: Add the following:

“Water Resistance: No water leakage when measured in accordance with ASTM E331 with a static test pressure of 8 PSF(383 Pa).”

- D. Item 2.3.A: Replace this item entirely with the following:

“Frames: 2 inch x 4-1/2 inch profile, flush glazing stop. Arcadia AFG-451T or equal.

3.5 SECTION 08 51 13 - ALUMINUM WINDOWS

- A. Delete this section in its entirety.

3.6 SECTION 28 31 00 - FIRE ALARM SYSTEM

- A. Item 2.3.B.1: Replace this item in its entirety with the following:

"The FACP shall include one (1) Signaling Line Circuit (SLC) that will power, supervise, monitor, and control a maximum of 159 analog addressable devices which may be made up of any combination of sensors and modules. Sub-points allow for more than 159 analog addressable software points. The SLC shall have the capability to be wired in an NFPA Style 4, 6, or 7 (Class A, B or X) configuration."

DRAWINGS

Architectural

3.7 DRAWING A2.2 - FIRST FLOOR PLAN - AREA A

- A. Floor Plan Notes: Add the following:

“11. When framed wall terminates or built alongside/behind a storefront window, finish with a painted drywall.

12. When casework terminates or built alongside/behind a storefront window, finish the abutting surface with plastic laminate to match.

- B. Apply these changes to all Floor Plan Notes in applicable sheets.

3.8 DRAWING A2.3 - FIRST FLOOR PLAN - AREA B

- A. Remove casework from scope of work in northeast corner of Room A140 to make room for electrical panels per the attached Drawing A2.3.

3.9 DRAWING A5.5 - ENLARGED WALL SECTIONS

- A. Replace this drawing in its entirety with the attached Drawing A5.5.
- B. Detail 18: Revise detail notes and add end condition.
- C. Detail 20: Revise low wall top condition and wall to floor transition.

Structural

3.10 DRAWING S0.11 - COREBRACE BRB DETAILS

- A. Detail 13: Added note for protection zones per the attached Drawing S0.11.

3.11 DRAWING S0.12 - COREBRACE BRB SCHEDULE

- A. Revised Corebrace Schedules per the attached Drawing S0.12.

3.12 DRAWING S2.2 - FOOR & SECOND FLOOR FRAMING PLAN - AREA B

- A. Replace this drawing in its entirety with the attached Drawing S2.2.
- B. Revise MDF-2 deck depressions at the northern balcony and the upper landing of the southern exterior stairway.

Mechanical

3.13 DRAWING MA2.1 - MECHANICAL FIRST FLOOR PLAN - AREA A

- A. Replace this drawing in its entirety with the attached Drawing MA2.1.
- B. Revised airflows at various outlets.
- C. Revised duct sizes in Athletic Trainer Room A127.
- D. Note 11 added regarding adding lockable covers for some thermostats.
- E. Note 12 added for dryer exhaust venting.

3.14 DRAWING MB3.1 - MECHANICAL FIRST FLOOR PLAN - AREA B

- A. Replace this drawing in its entirety with the attached Drawing MB3.1.
- B. Revised airflows at various outlets.

C. Note 9 added regarding adding lockable covers for some thermostats.

D. Note 8 added for dryer exhaust venting.

3.15 DRAWING MB3.3 - MECHANICAL SECOND FLOOR PLAN - AREA B

A. Replace this drawing in its entirety with the attached Drawing MB3.3.

B. Revised duct routing in Storage Room A202.

3.16 DRAWING M5.1 - MECHANICAL SCHEDULES

A. Replace this drawing in its entirety with the attached Drawing M5.1.

B. Revised Note 7 of packaged rooftop heat pump unit schedule.

C. Added Note 16 to packaged rooftop heat pump unit schedule.

D. Revised Note 14 on split system heat pump schedule.

E. Revised remarks column on split system heat pump schedule for indoor fan coils and outdoor heat pumps.

3.17 DRAWING M5.2 - MECHANICAL SCHEDULES

A. Replace this drawing in its entirety with the attached Drawing M5.2.

B. Revised Note 15 on split system AC and CU Schedule.

C. Revised Note 5 on fan schedule.

3.18 DRAWING M6.1 - MECHANICAL DETAILS

A. Replace this drawing in its entirety with the attached Drawing M6.1.

B. Added note on power exhaust and economizer Detail 18 on M6.1.

C. Revised Detail 3 on M6.1.

Plumbing

3.19 DRAWINGS P1.1 - PLUMBING SITE PLAN

A. Replace this drawing in its entirety with the attached Drawing P1.1.

B. Gas isolation valves added to each branch in the construction zone.

3 .20 DRAWING P2.2.2 - PLUMBING 1ST FLR PLN - AREA A - WATER AND GAS

- A. Replace this drawing in its entirety with the attached Drawing P2.2.2.
- B. SH-4 changed to SH-1A in Boys Restroom A124.

3 .21 DRAWING P2.3.1 - PLUMBING 1ST FLR PLN - AREA B - WASTE AND VENT

- A. Added keynote 19 per the attached Drawing P2.3.1.
- B. Add 1" vent from gas pressure regulator up through roof. Route to roof similar to water heater vent. Terminate vent through roof similar to Detail 6/P6.2. Locate minimum of 10' away from outside air intake or 3'-0" above.

3 .22 DRAWING P2.3.2 - PLUMBING 1ST FLR PLN - AREA B - WASTE AND VENT

- A. Replace this drawing in its entirety with the attached Drawing P2.3.2.
- B. Gas line increased in size from 1" to 1-1/2", followed by an increase from 1/2" to 3/4" for the line going to the dryers.
- C. SH-4 changed to SH-1A in Girls Restroom A143.

3 .23 DRAWING P3.1 - ENLARGED PLUMBING PLANS

- A. Replace this drawing in its entirety with the attached Drawing P3.1.
- B. Add 3/4" condensate drain line from RT-14 to sink. Route 3/4" condensate drain down in wall, elbow out and extend to the tailpiece of the sink.
- C. Add 1" vent from gas pressure regulator up through roof. Terminate vent through roof similar to water heater flue routing. Terminate similar to Detail 6/P6.2. Locate minimum of 10' away from outside air intake or 3'-0" above.

3 .24 DRAWING P5.1 - PLUMBING SCHEDULES

- A. Replace this drawing in its entirety with the attached Drawing P5.1.
- B. Revise Plumbing Fixture Schedule.

Electrical

3 .25 DRAWING E1.1 - ELECTRICAL SITE PLN

- A. Replace this drawing in its entirety with the attached Drawing E1.1.
- B. Revise to label relocated switchboard on demo plan per the attached Drawing E1.1.
- C. Added pullbox sizing per the attached Drawing E1.1.

D. Revised demo Keynote 2 per the attached Drawing E1.1.

3 .26 DRAWING EA2.2 - ELECTRICAL -1ST FLR PLN -AREA B

- A. Replace this drawing in its entirety with the attached Drawing EA2.2.
- B. Revise to show future Musco equipment in Team Storage Room per the attached Drawing EA2.2.
- C. Added receptacles to the Storage Rooms per the attached Drawing EA2.2.
- D. Added conduit and wire sizing to Storage Room per the attached Drawing EA2.2.
- E. Added note for wall mounted pullboxes per the attached Drawing EA2.2.
- F. Added notes for spare conduits to future Musco poles per the attached Drawing EA2.2.
- G. Added pullbox sizing per the attached Drawing EA2.2.

3 .27 DRAWING EA2.3 - ELECTRICAL -2ND FLR PLN

- A. Replace this drawing in its entirety with the attached Drawing EA2.3.
- B. Revise to show circuit for elevator disconnect per the attached Drawing EA2.3.

3 .28 DRAWING EA4.2 - ELECTRICAL -ROOF PLAN -AREA B

- A. Replace this drawing in its entirety with the attached Drawing EA4.2.
- B. Add roof receptacle and callout per the attached Drawing EA4.2.

3 .29 DRAWING EA4.3 - ELECTRICAL -2ND FLOOR ROOF PLAN

- A. Replace this drawing in its entirety with the attached Drawing EA4.3.
- B. Add roof receptacle and Keynote 2 per the attached Drawing EA4.3.
- C. Add detail for roof receptacle mounting per the attached Drawing EA4.3.

3 .30 DRAWING EB2.1 - ELECTRICAL - POOL FLR PLN

- A. Added notes for spare conduits to future Musco poles per the attached Drawing EB2.1.
- B. Added pullbox sizing per the attached Drawing EB2.1.

3 .31 DRAWING E5.1 - ELECTRICAL SINGLE LINE DIAGRAM

- A. Replace this drawing in its entirety with the attached Drawing E5.1.
- B. Revise Keynote 6 per the attached Drawing E5.1.

3 .32 DRAWING E5.2 - ELECTRICAL PANEL SCHEDULES

- A. Add circuits for convenience receptacles from panel L1B per the attached Drawing E5.2.

Fire Alarm

3 .33 DRAWING FA0.0 - FIRE ALARM LEGENDS AND GENERAL NOTES

- A. Changed wire type from stranded to twisted per the attached Drawing FA0.0.

3 .34 DRAWING FA1.1 - FIRE ALARM SITE PLAN

- A. Added conduit routing to pull boxes per the attached Drawing FA1.1.

3 .35 DRAWING FA5.1 - FIRE ALARM PANEL SCHEDULES & CALCS

- A. Updated riser diagram and panel calculations per the attached Drawing FA5.1.

3 .36 DRAWING FA6.1 - FIRE ALARM DETAILS

- A. Added seismic Detail 10 per the attached Drawing FA6.1.

3 .37 DRAWING FAA2.2 - FIRE ALARM - 1ST FLR PLN - AREA B

- A. Added conduit path to Administration Building and existing PIV valves per the attached Drawing FAA2.2.

Technology

3 .38 DRAWING T1.1 – TECHNOLOGY SITE PLAN

- A. Replace this drawing in its entirety with the attached Drawing T1.1.
- B. Revise point of connections between new conduits and existing per the attached Drawing T1.1.
- C. Add information for the existing MDF, existing conduits and junction boxes locations per the attached Drawing T1.1.

Addendum 3
Nogales High School New Building and Aquatic Center
Project W2110000AR.41
DSA 03-122782 / File 19-92
March 11, 2024
Page 8

Swimming Pool

3.39 DRAWING SP.3 - SWIMMING POOL UNDERWATER LIGHT / TIMING SYSTEM PLAN

- A. Remove the non-illuminated facility identification panel with artwork from the scope of work.
- B. Please provide (2) DC-1500 shot clocks for water polo.

END OF ADDENDUM 3

Submitted by,



BOB LAVEY
AIA, LEED AP
Managing Partner, Architect




RL:PF:hb\P4W2110000ARx3-add

Attachments: A2.3, A5.5, S0.11, S0.12, S2.2, MA2.1, MB3.1, MB3.3, M5.1, M5.2, M6.1, P1.1, P2.2.2, P2.3.1, P2.3.2, P3.1, P5.1, E1.1, EA2.2, EA2.3, EA4.2, EA4.3, EB2.1, E5.1, E5.2, E5.3, FA0.0, FA1.1, FA5.1, FA6.1, FAA2.2, T1.1,




RANCHO CUCAMONGA
8163 Rochester Avenue, Suite 100
Rancho Cucamonga, CA 91730
909-987-0909 P

**NOGALES HIGH SCHOOL
NEW BUILDING & AQUATIC CENTER**
ROWLAND UNIFIED SCHOOL DISTRICT
401 NOGALES ST., LA PUENTE, CA 91744

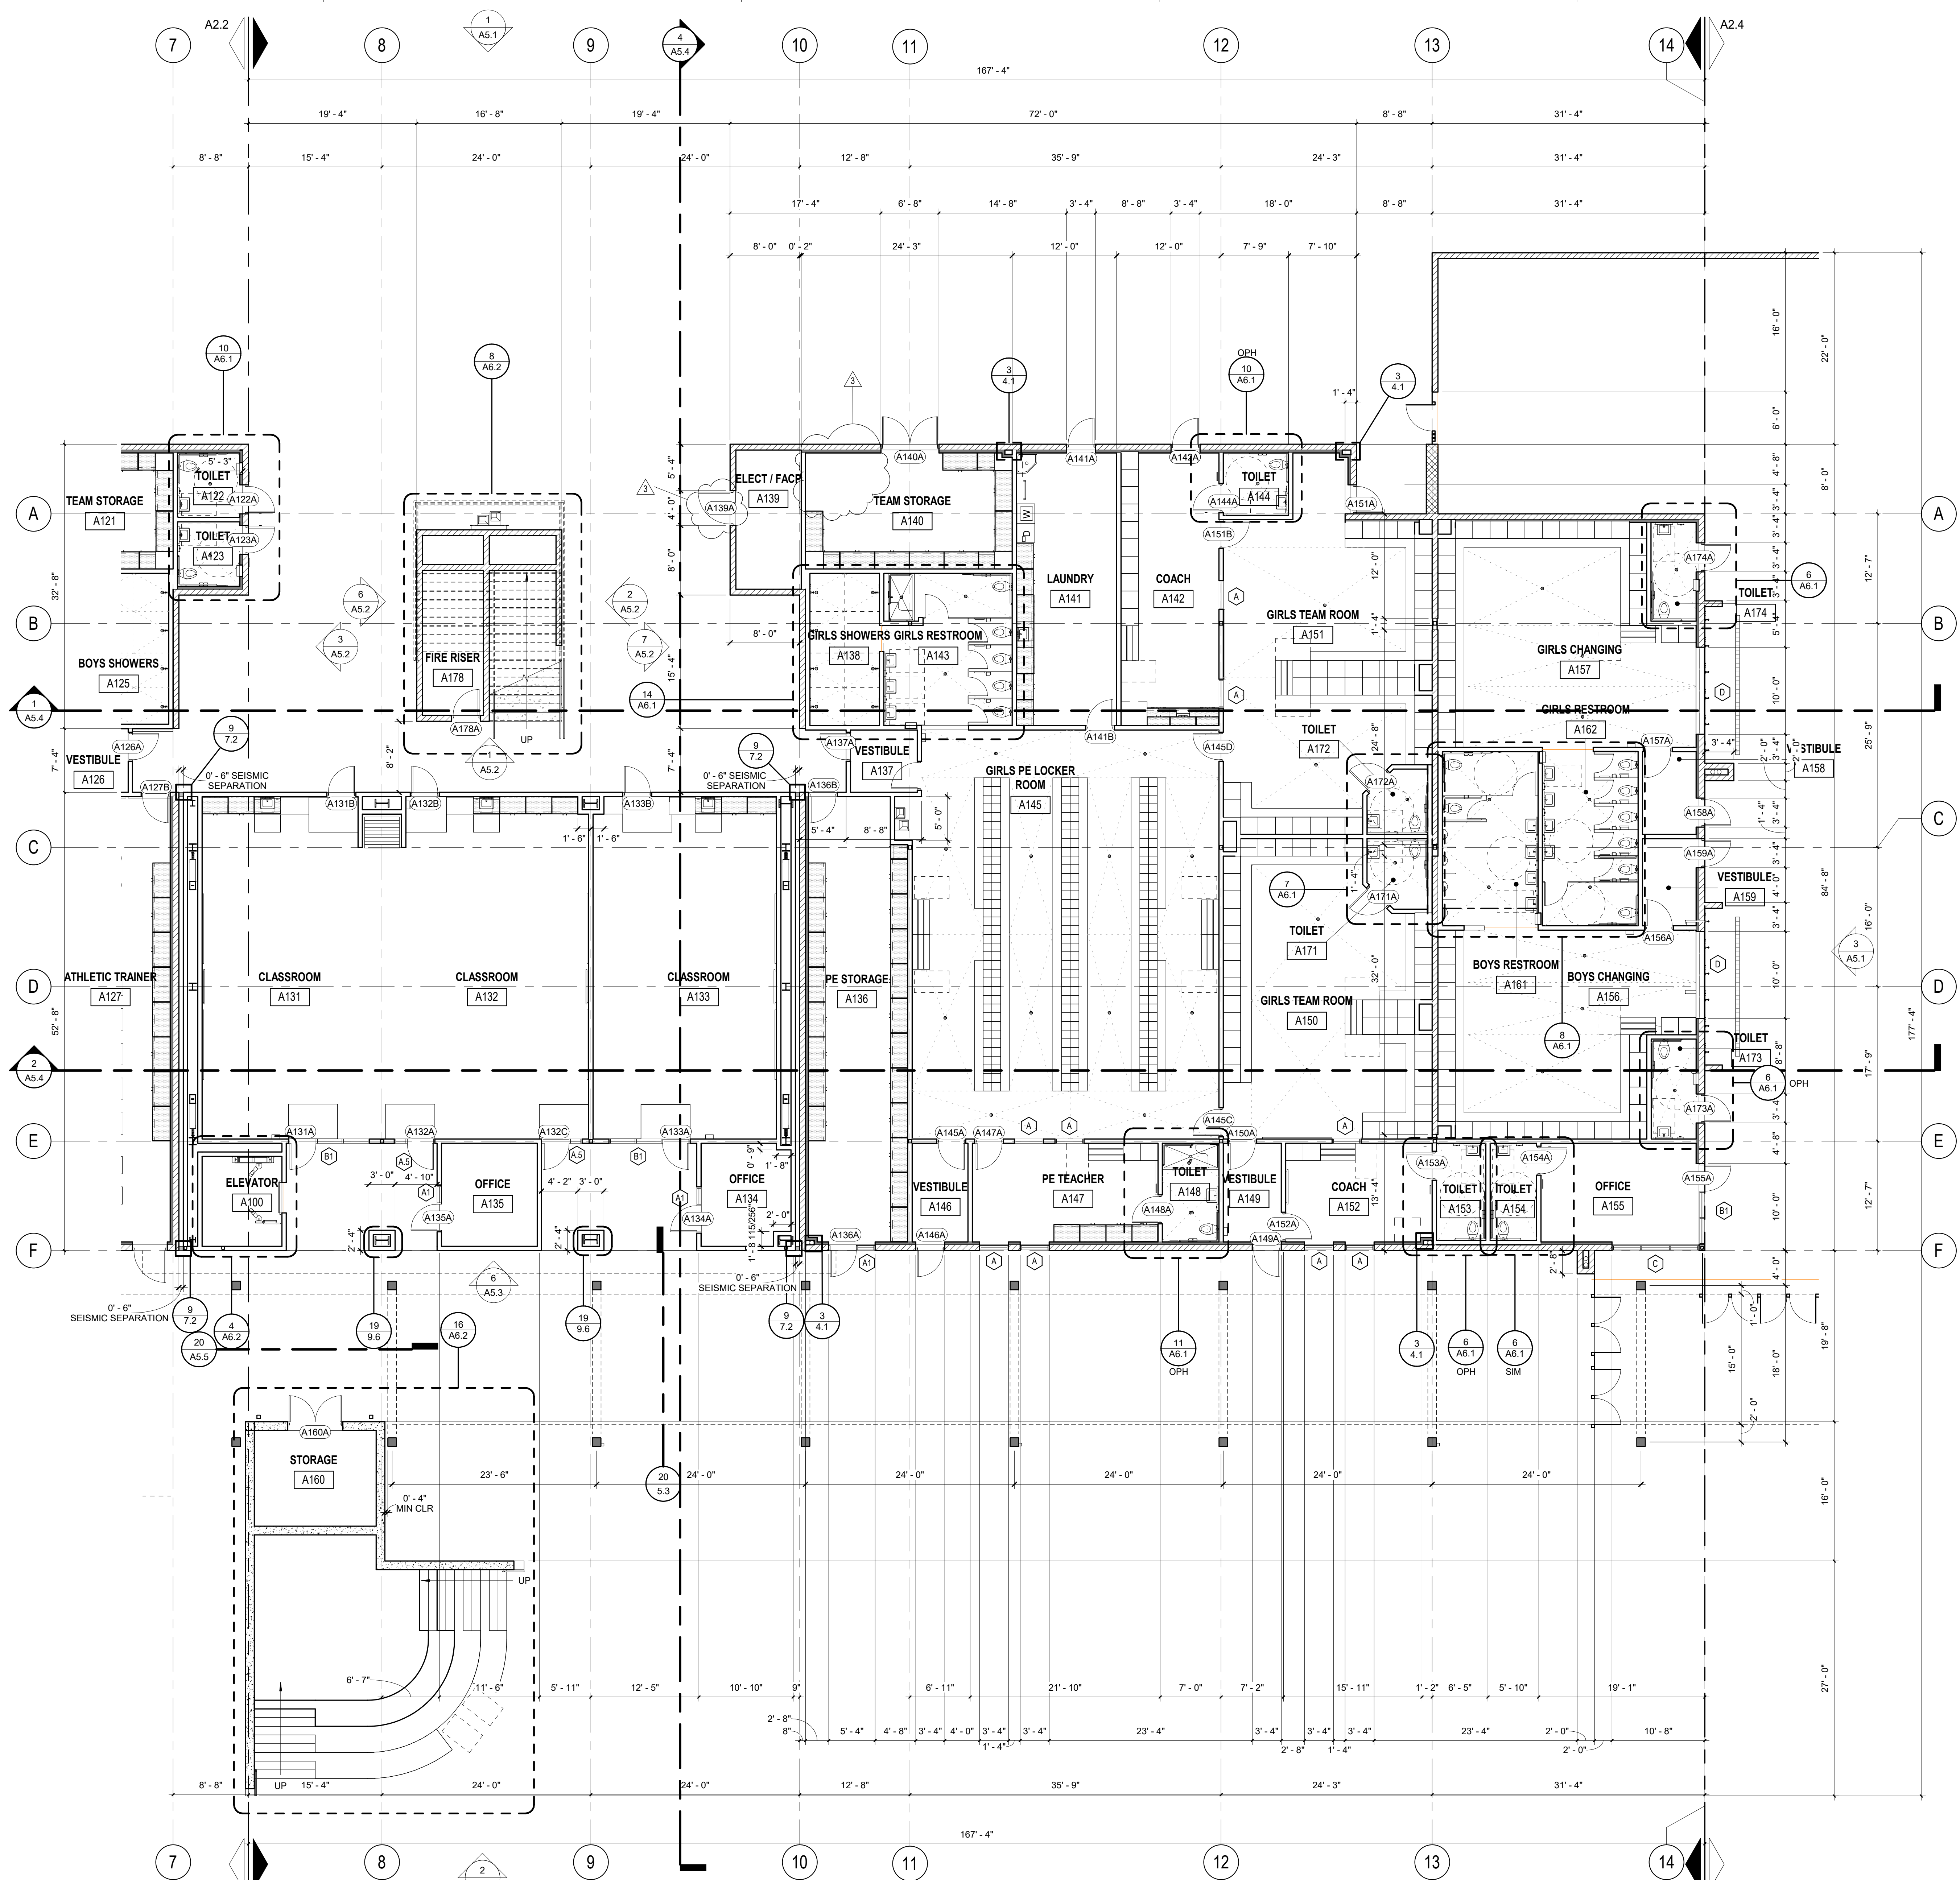

- GENERAL NOTES:**
- REF TO ROOM FINISH SCHEDULE FOR INTERIOR WALL FINISHES.
 - DIMENSIONS FOR CMU ARE FROM FACE OF MASONRY.
 - DIMENSIONS FOR MTL STUDS ARE FROM FACE OF STUDS UNLESS HSS COLUMN IS INSIDE THE WALL. IN THAT CASE THE DIMENSION WILL BE FROM THE CENTER OF THE COLUMN.
 - ALL INTERIOR STUD WALLS SHALL HAVE BATT INSULATION FULL HEIGHT.
 - ALL EXTERIOR CMU WALLS WITH FURRING SHALL HAVE RIGID INSULATION FULL HEIGHT.
 - REFER TO EXTERIOR ELEVATIONS FOR EXTERIOR WALL FINISHES.
 - REFER TO A7. SERIES (INTERIOR PLANS AND ELEVATIONS) FOR MORE INFORMATION ON WALL FINISHES, CASEWORK, LOCKERS AND MISC. EQUIPMENT.
 - REFER TO DETAIL SHEETS 8.1 FOR WINDOW DETAILS.
 - REFER TO A6. SERIES (ENLARGED PLAN) FOR MORE INFORMATION ON RESTROOMS AND STAIRS. ALL RESTROOM DIMENSIONS ARE TO FACE OF FINISH.
 - DEPRESS CONCRETE SLAB AS FOLLOWS:
A. FIRST FLOOR RESTROOM, TOILET, SHOWER = 2 1/2" DEEP
B. SECOND FLOOR RESTROOM = 2" DEEP
C. SECOND FLOOR DANCE ROOM = 1 1/2" DEEP
D. SECOND FLOOR BALCONY = 3" DEEP

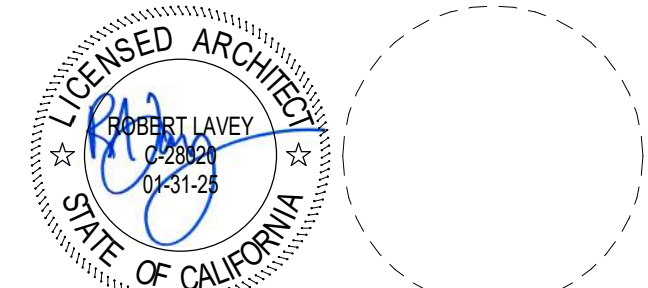

CONSULTANT

FLOOR PLAN NOTES		1/8" = 1'-0"
	6" METAL STUD INTERIOR WALL REF WALL TYPE A DWG 9.1. AT EXTERIOR WALLS REF WALL TYPE B DWG 9.1. AT INTERIOR TOILET ROOM WALLS REF TYPE G AND AT DOUBLE SIDED INTERIOR TOILET ROOM WALLS TYPE Q DWG 9.1 AT SECOND FLOOR EXTERIOR WALL REF DETAILS ON SHEET 9.5	
	PAINTED 16" CMU EXTERIOR WALL, PAINT WHERE EXPOSED. REF WALL TYPE E DWG 9.1	
	PAINTED 12" CMU EXTERIOR WALL, PAINT WHERE EXPOSED. REF WALL TYPE E DWG 9.1	
	PAINTED 8" CMU INTERIOR WALL, PAINT WHERE EXPOSED. REF WALL TYPE E DWG 9.1	
	PAINTED 8" CMU EXTERIOR & PLASTER / INTERIOR WALL WITH 2.5" METAL STUD WALL FURRING. REF WALL TYPE E DWG 9.1	
	PAINTED 8" CMU EXTERIOR / INTERIOR WALL WITH 4" METAL STUD WALL FURRING AT TOILET ROOMS. REF WALL TYPE G DWG 9.1	
	12" C.I.P. CONCRETE WALL REF WALL TYPE H DWG 9.1	

NO	DATE	BY	DESCRIPTION
1	01/25/24	PBK	ADDENDUM 1
3	03/05/24	PBK	ADDENDUM 3

DRAWN:	CHECKED:
PDF	SA


DATE: 11/22/2023 SCALE: 1/8" = 1'-0"
PROJECT NUMBER: 2110000

**FIRST FLOOR PLAN
- AREA B**


DRAWING NUMBER: **A2.3**

FIRST FLOOR PLAN - AREA B 1/8" = 1'-0" 1


WALL LEGEND 1/8" = 1'-0"

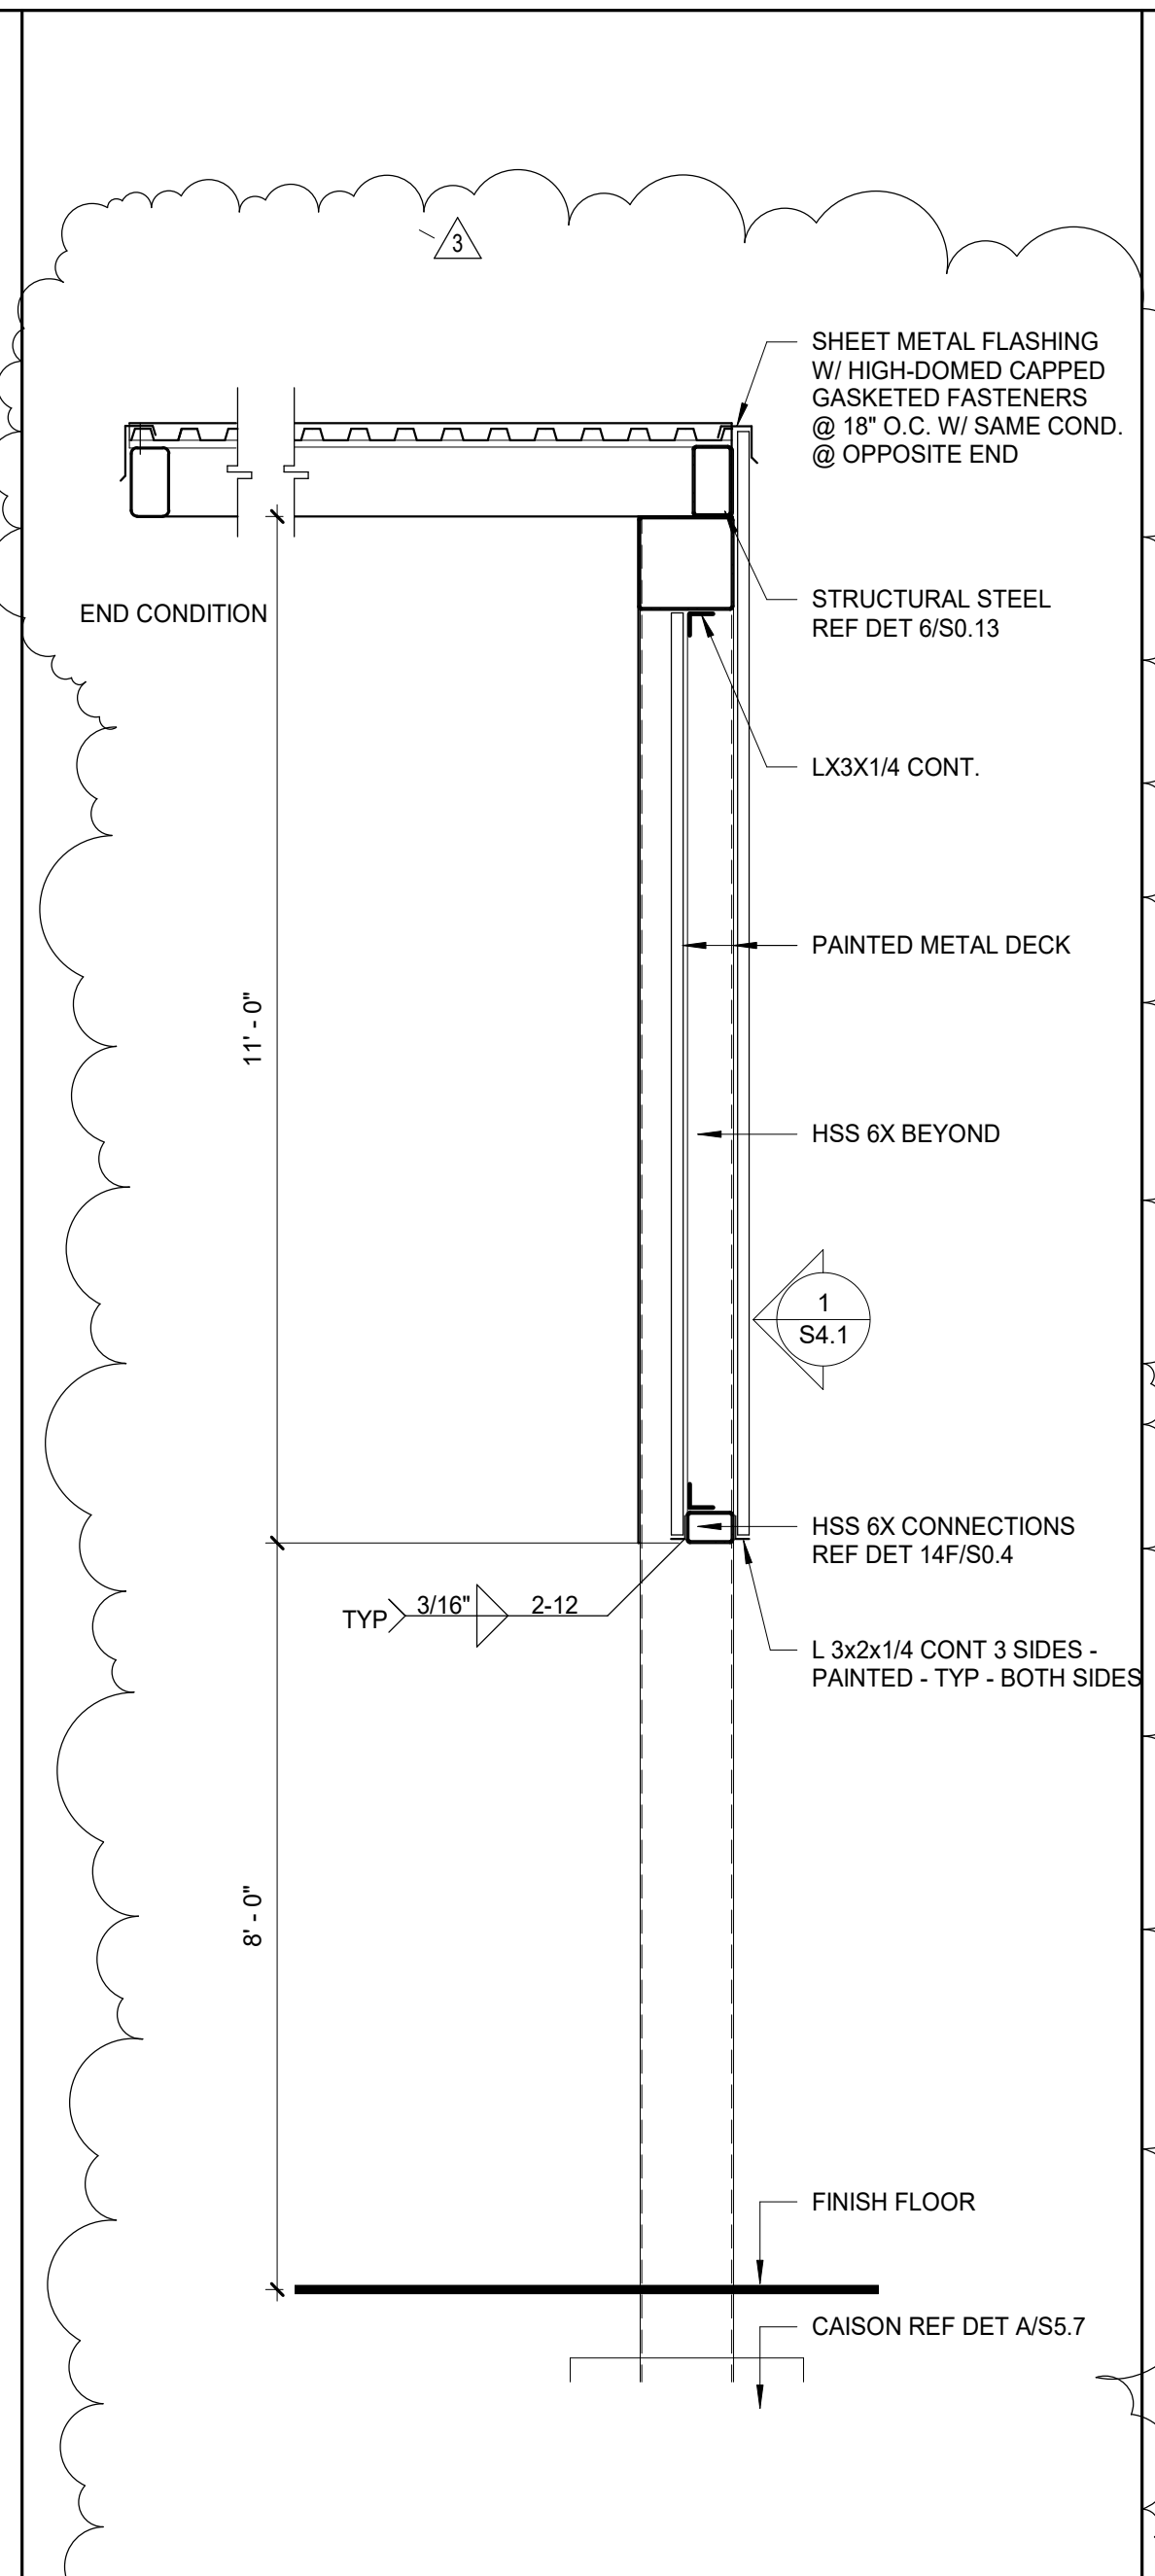


COVERED WALKWAY END 1/2" = 1'-0" 18

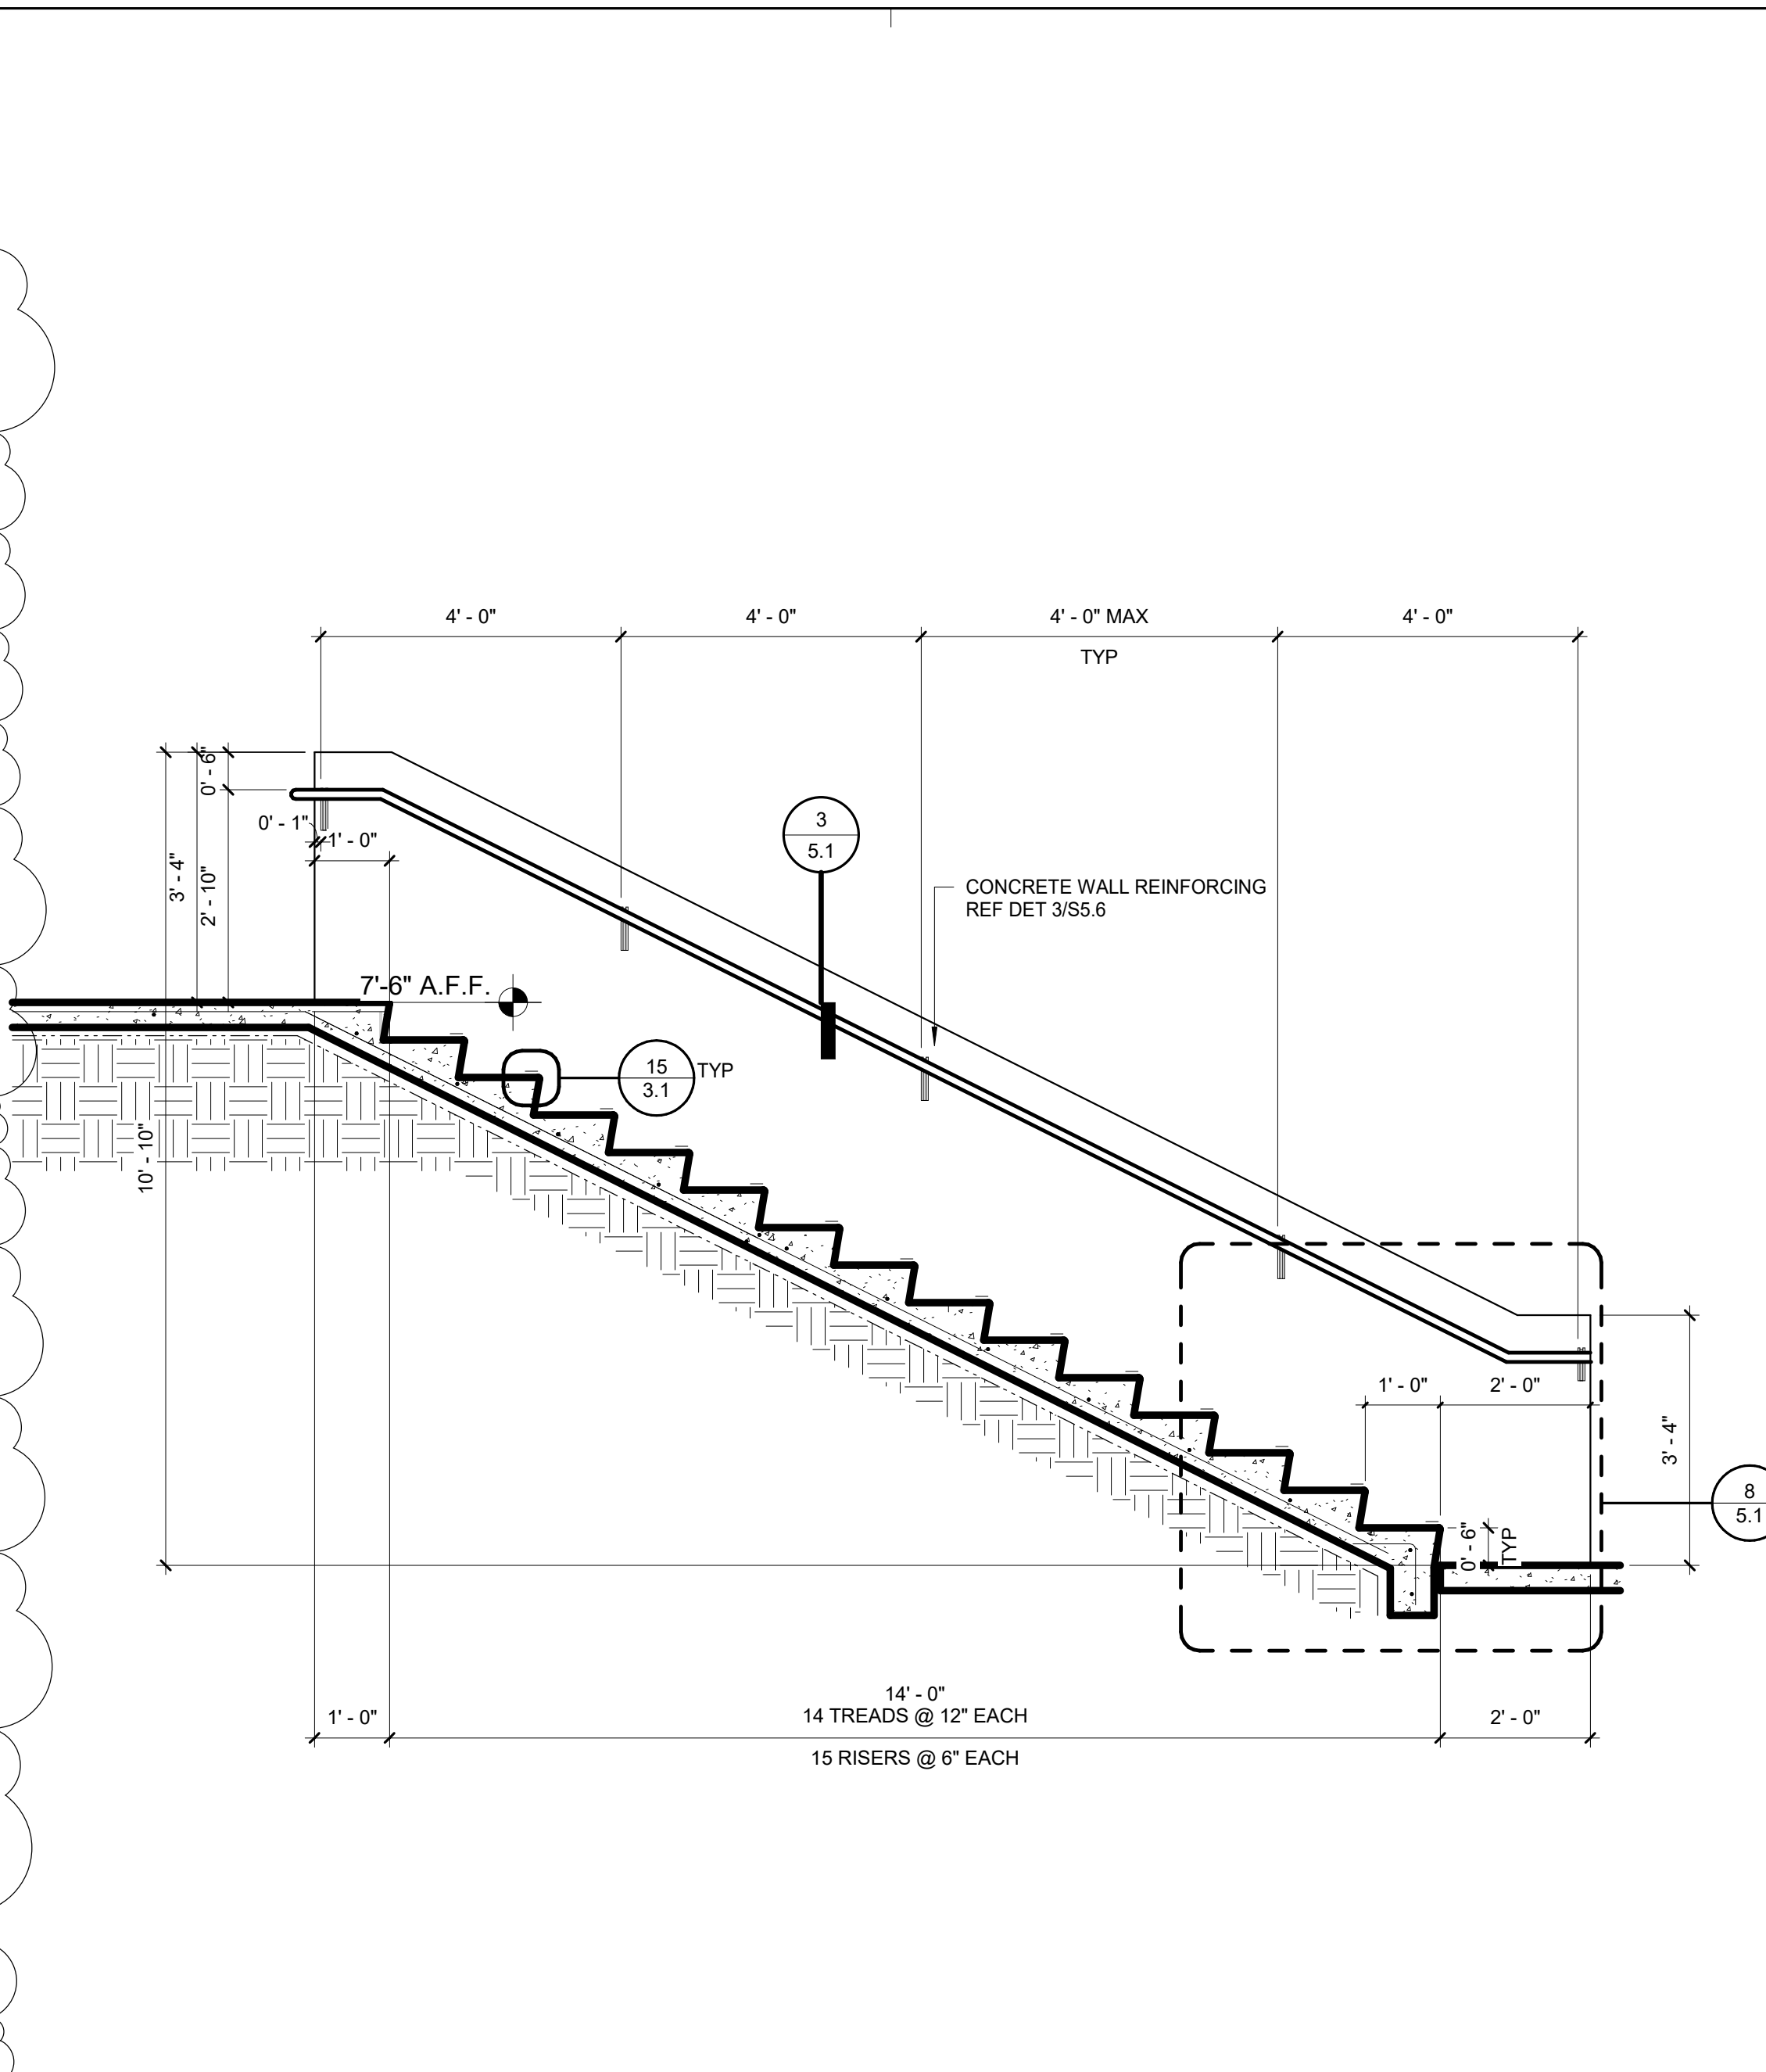


CONCRETE STAIR SECTION 1/2" = 1'-0" 10

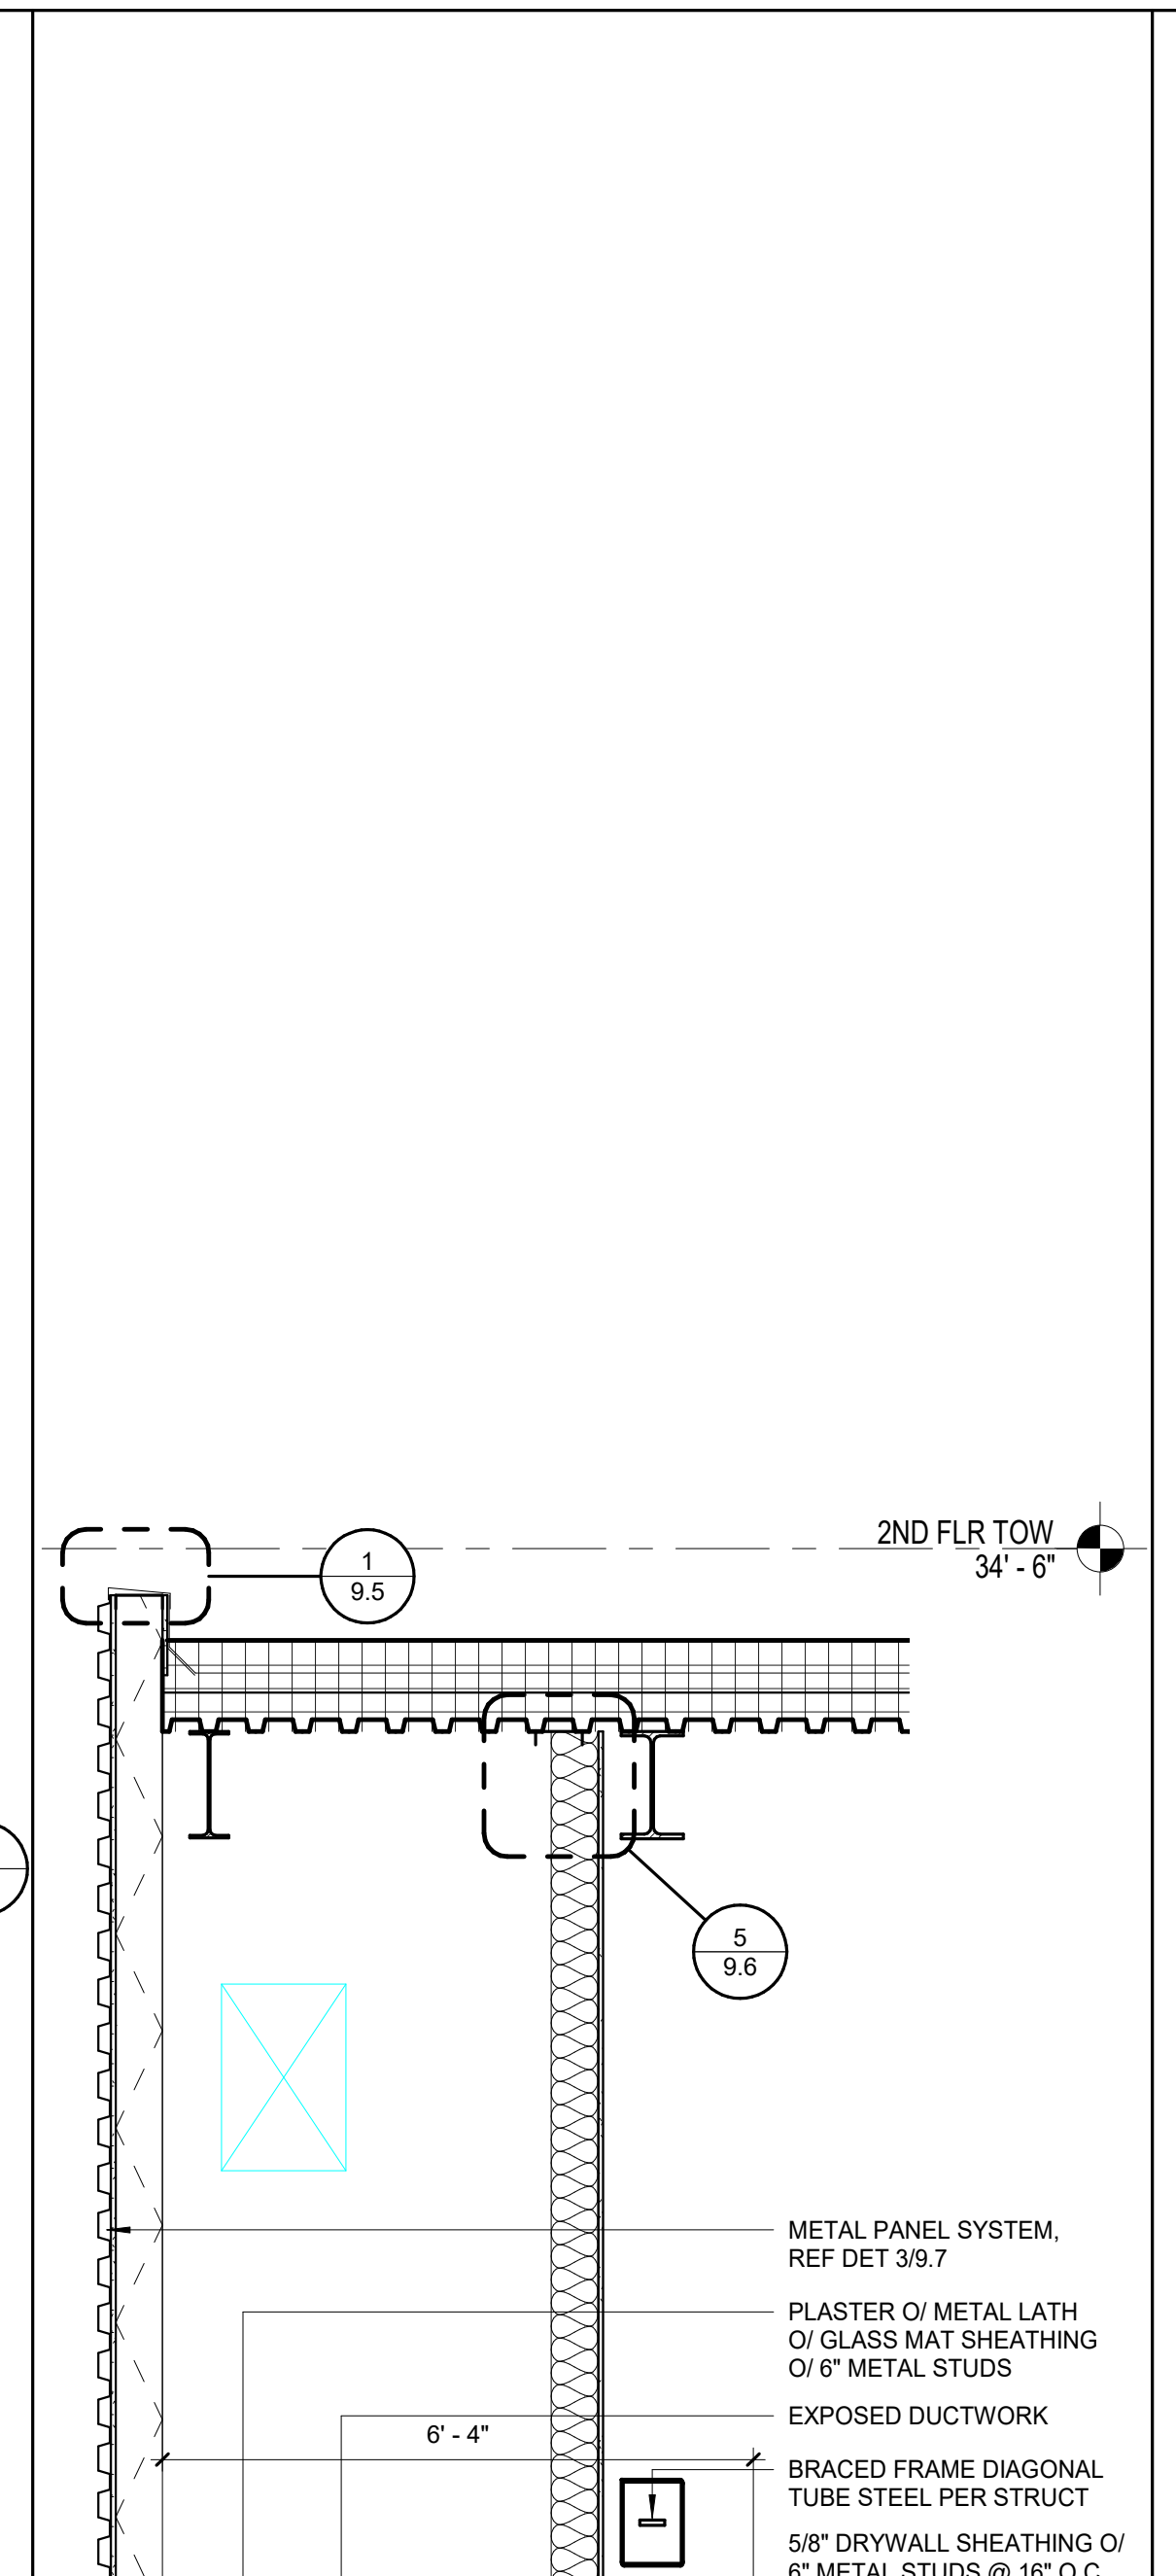


WALL SECTION 1 1/2" = 1'-0" 2

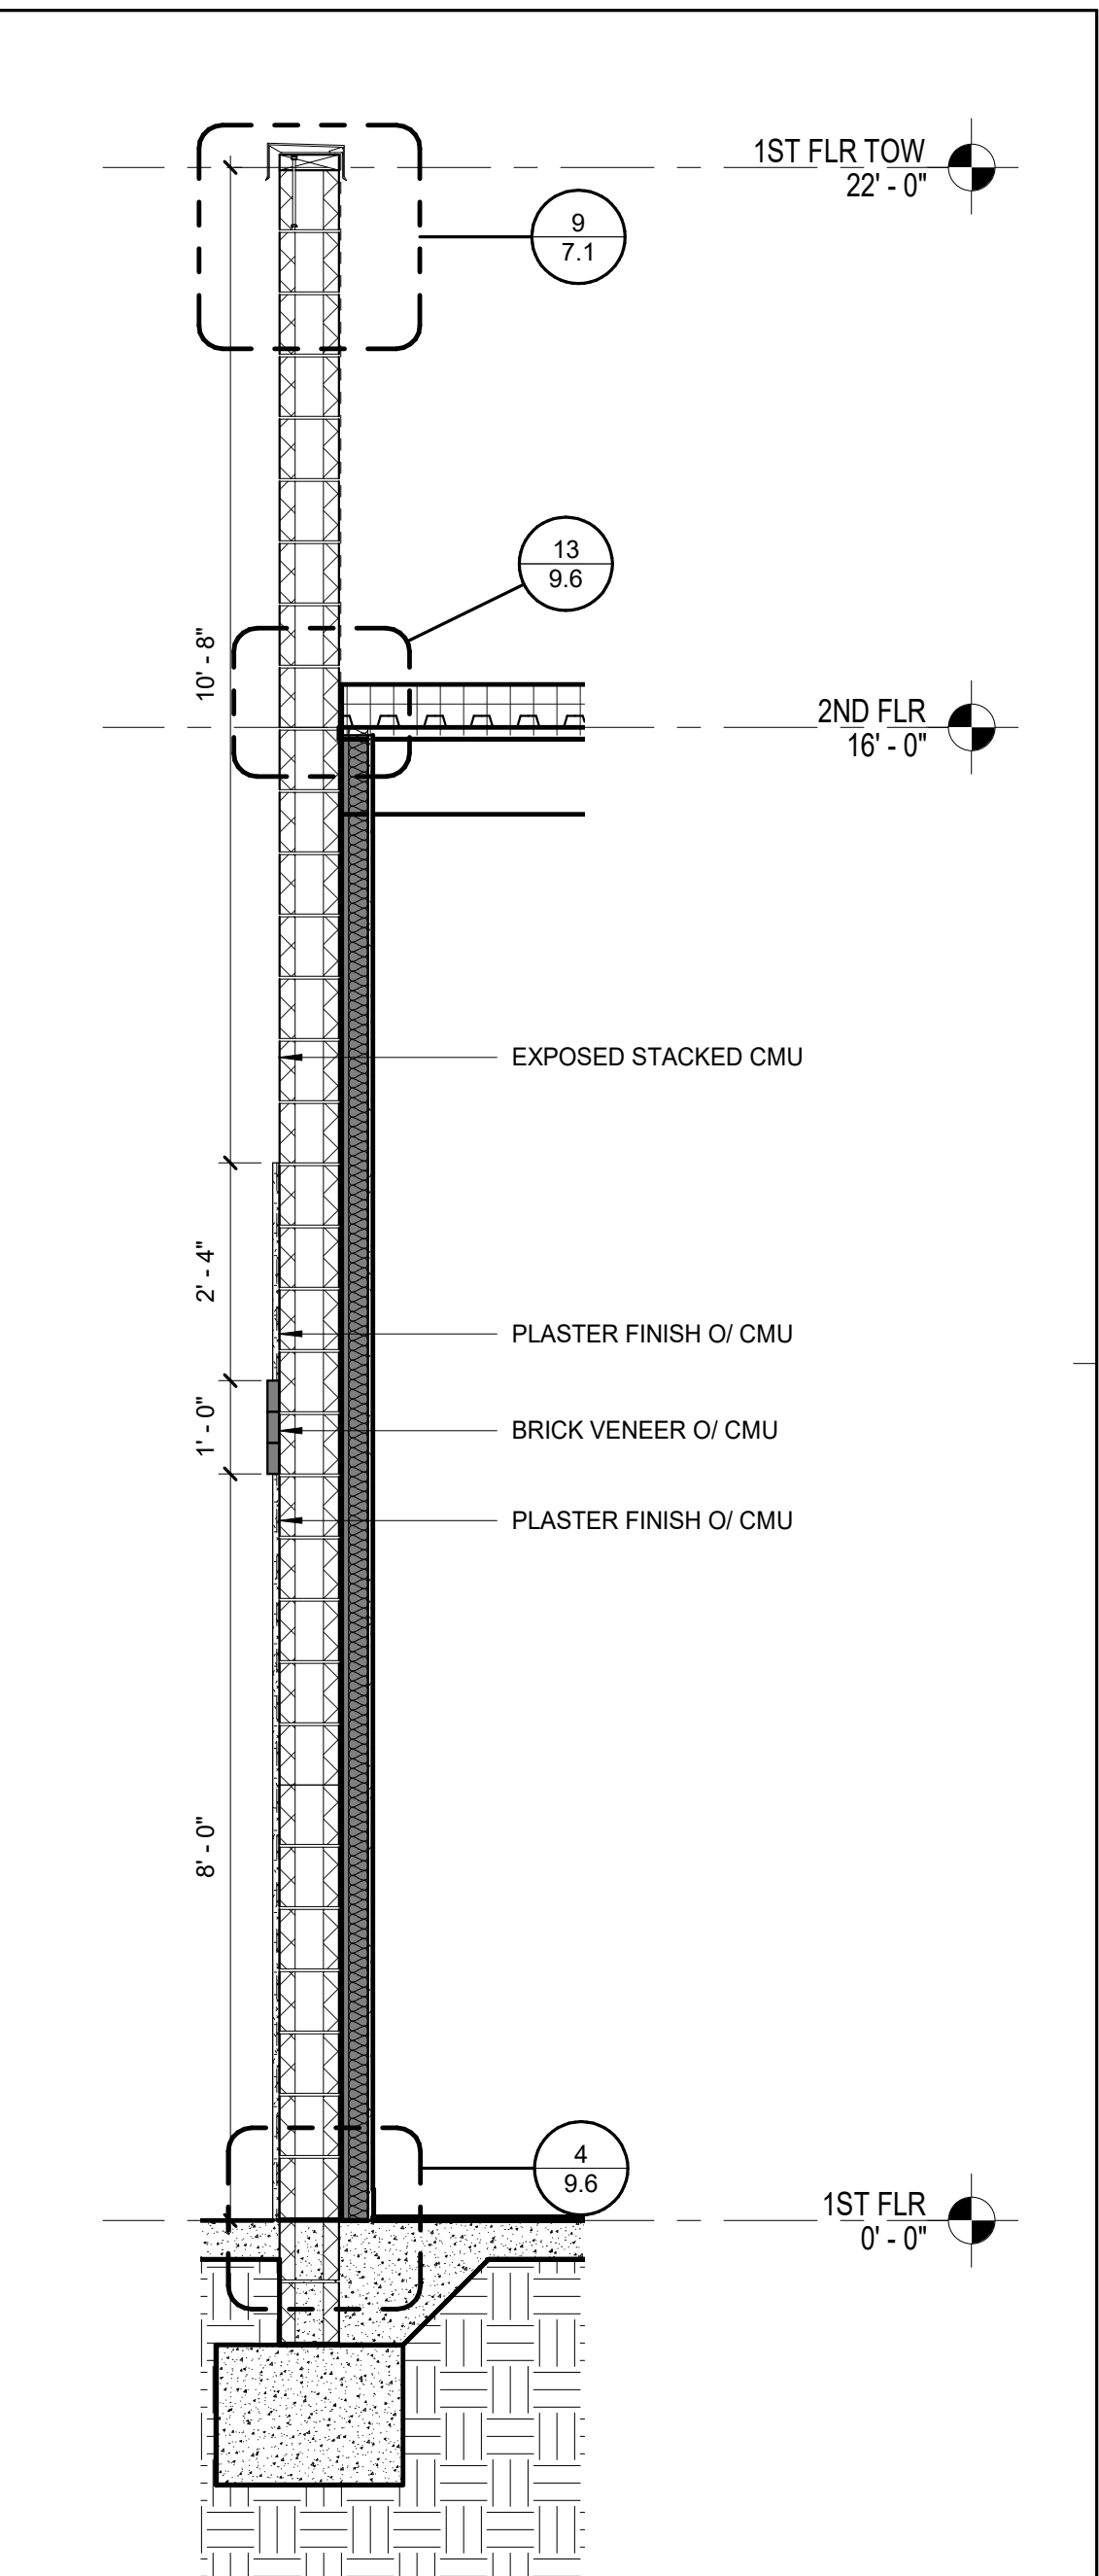


WALL SECTION 2 1/2" = 1'-0" 4

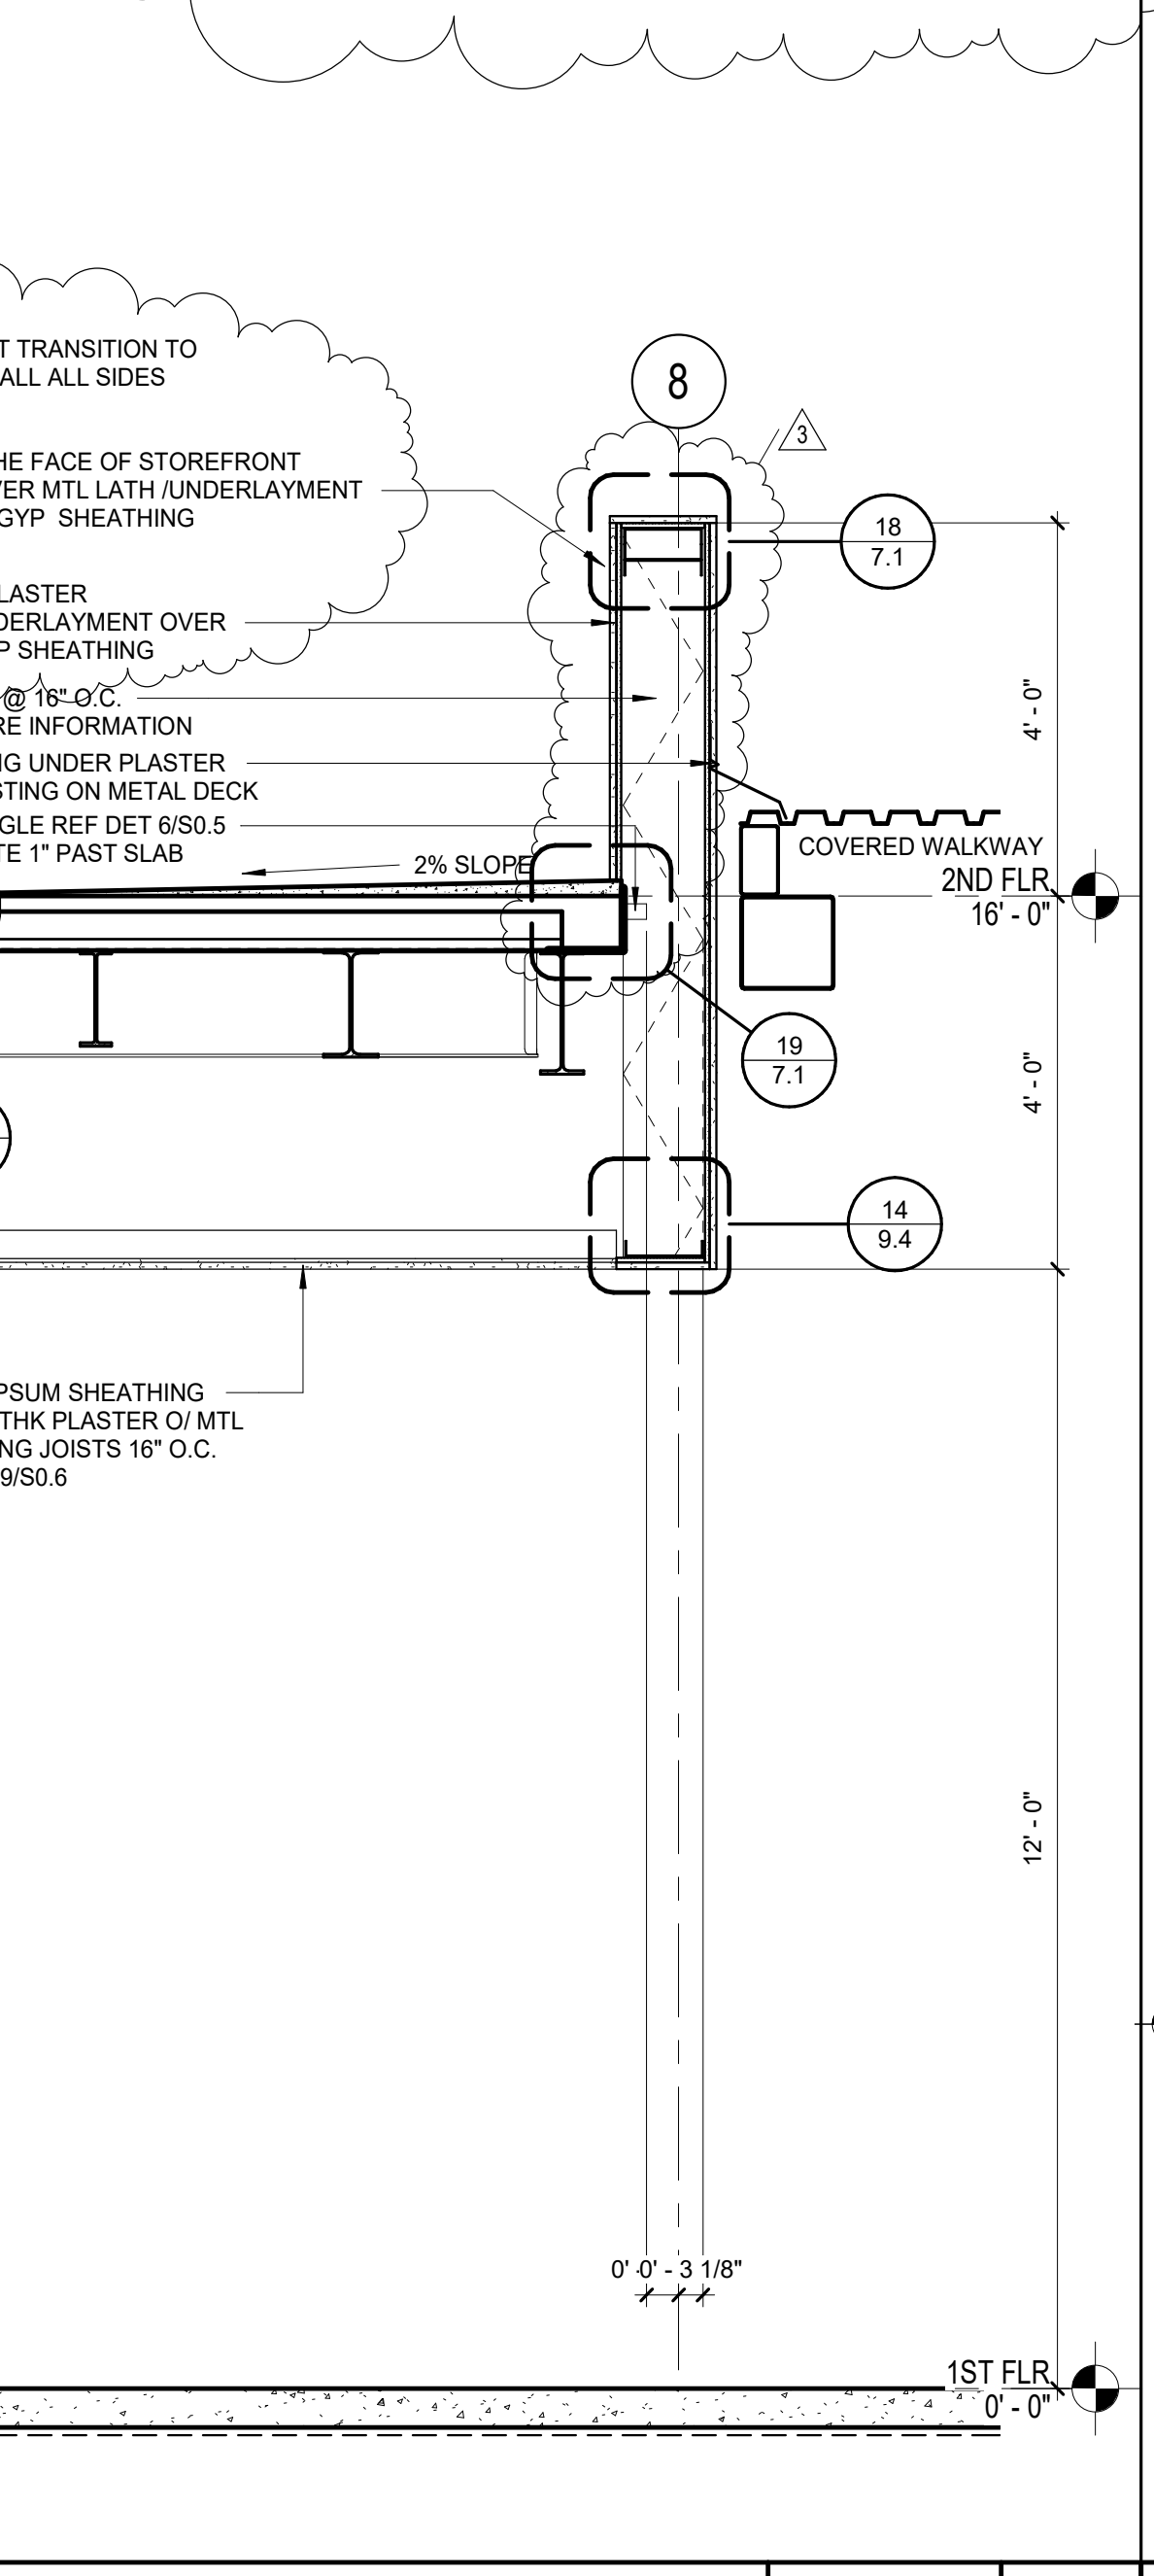


BRIDGE SECTION 1/2" = 1'-0" 20

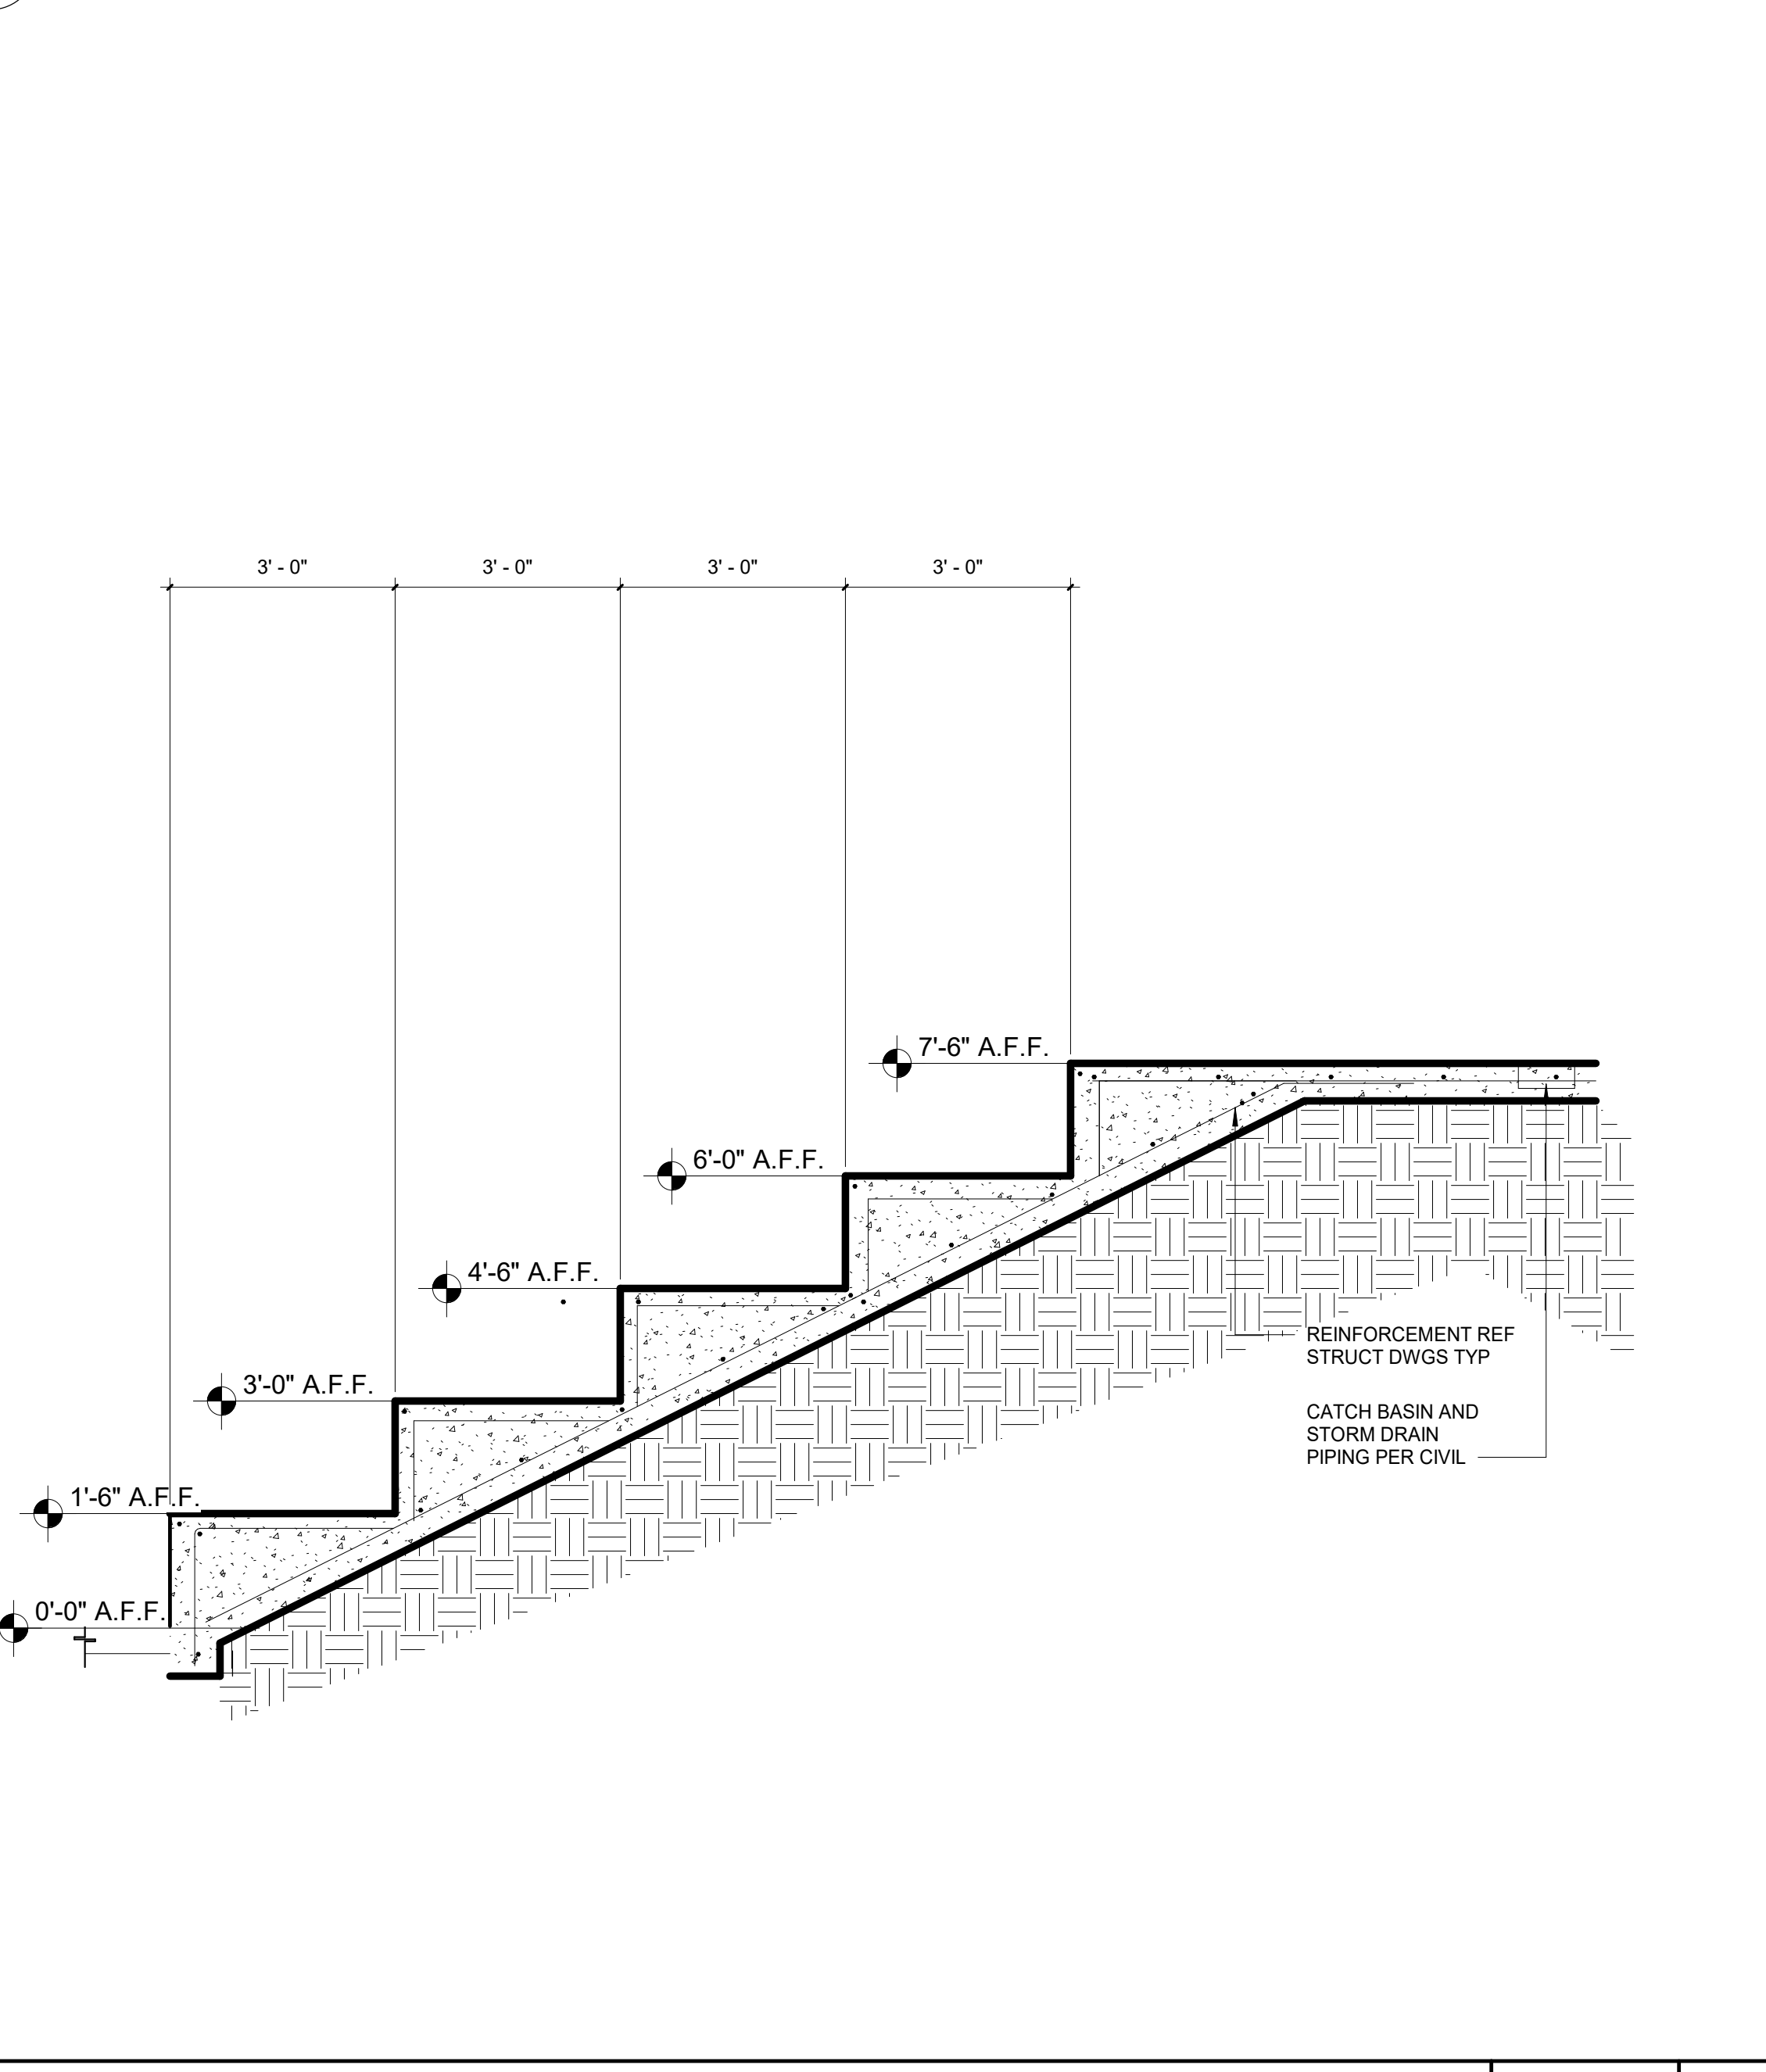


AMPHISTAIR BI SECTION 1/2" = 1'-0" 12

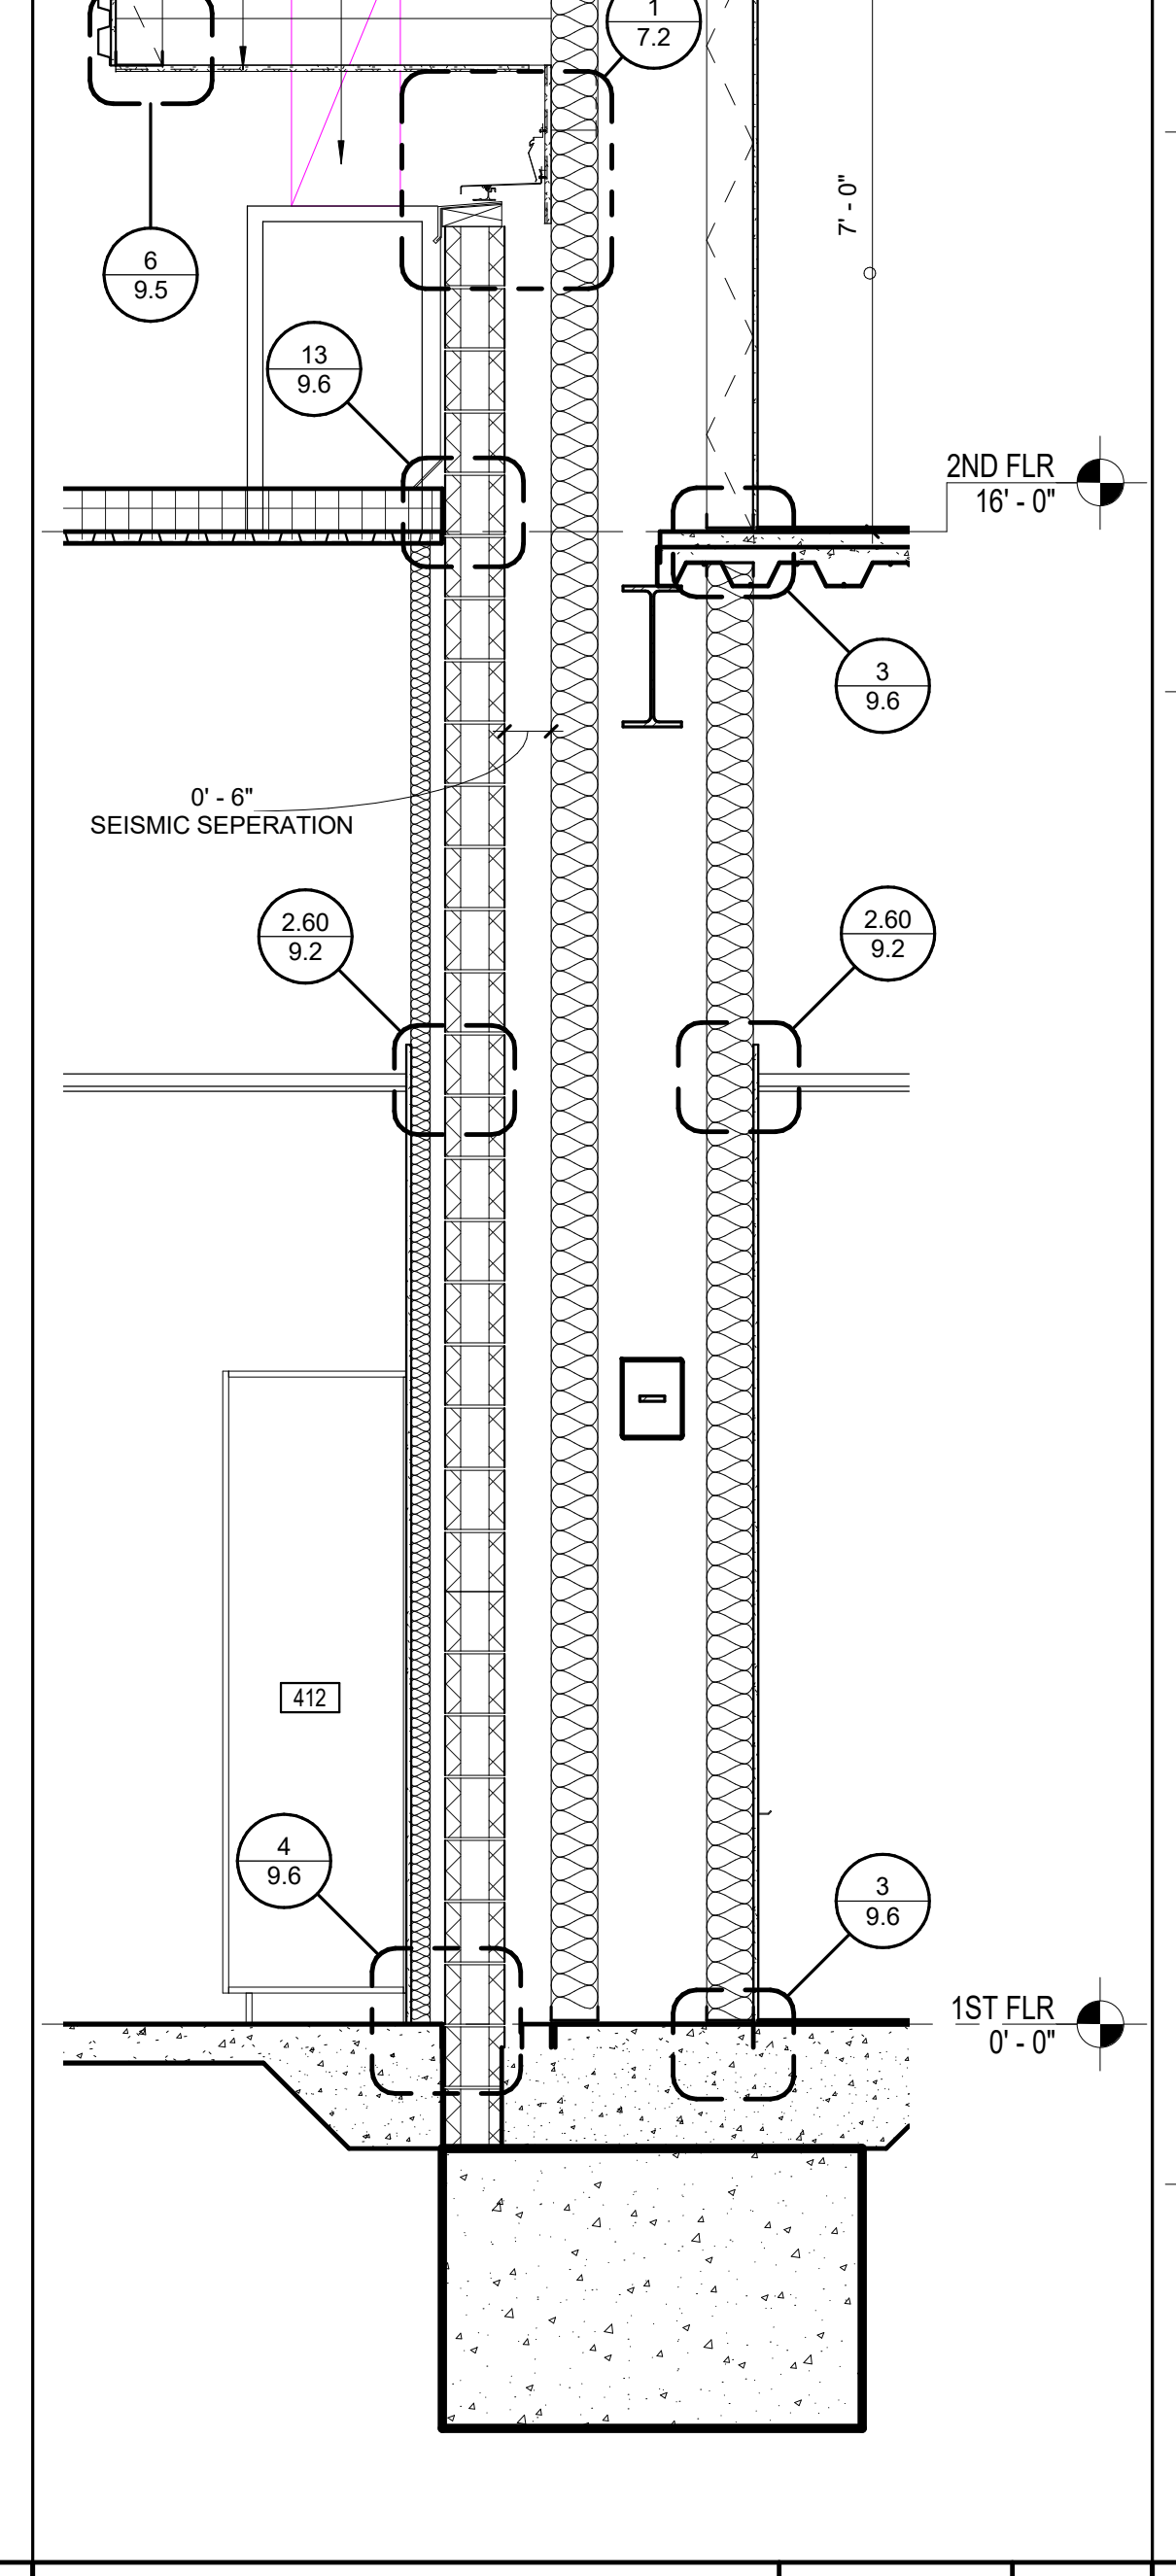

WALL SECTION 3 1/2" = 1'-0" 8

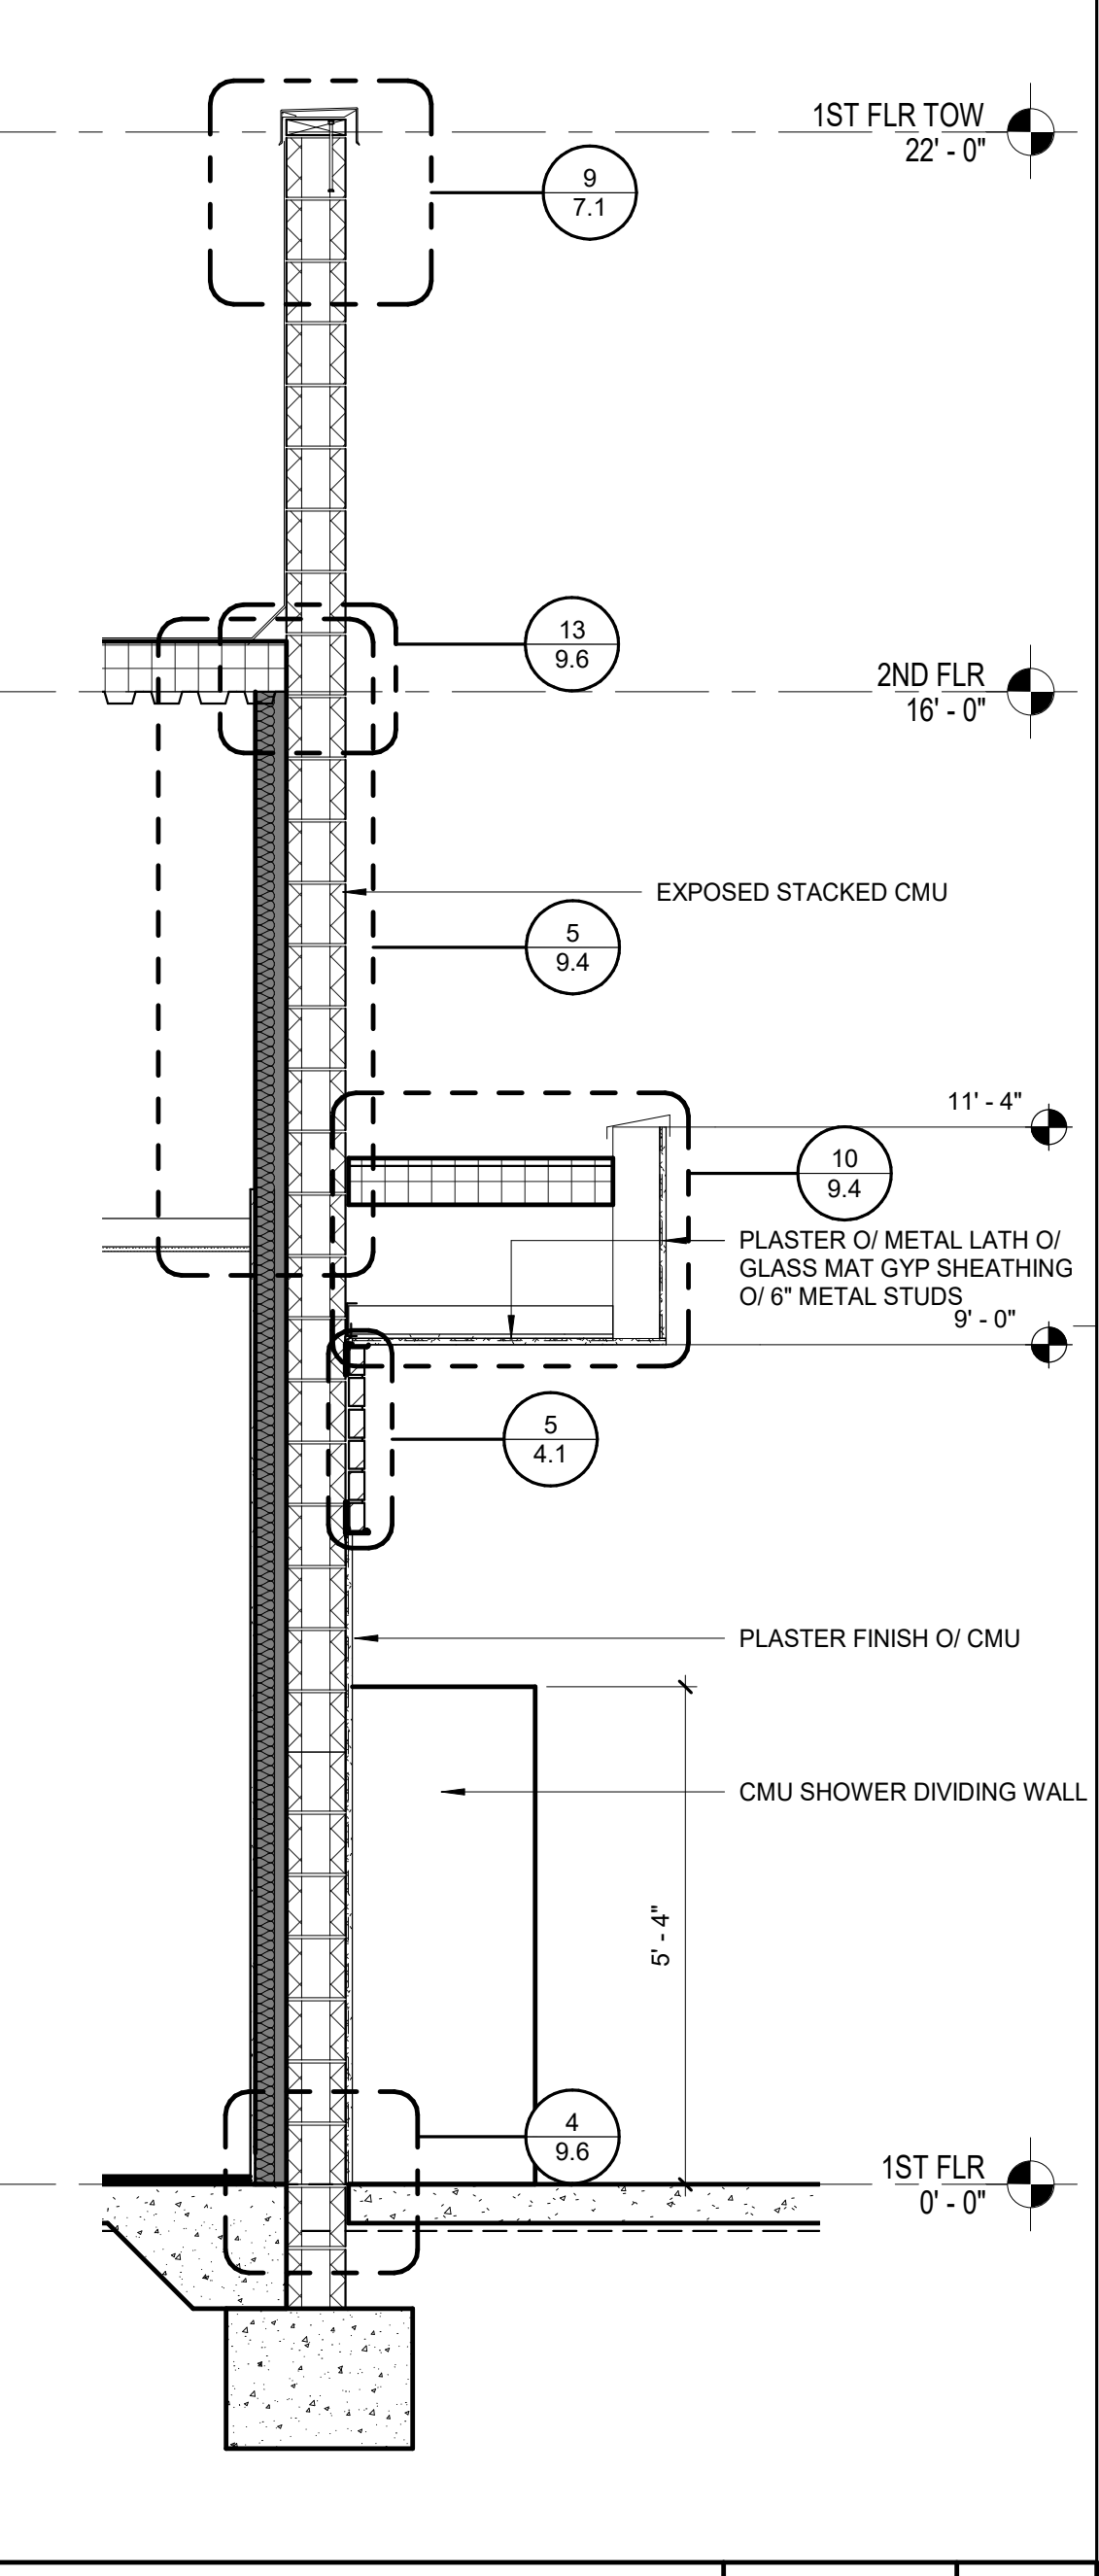

WALL SECTION 4 1/2" = 1'-0" 4

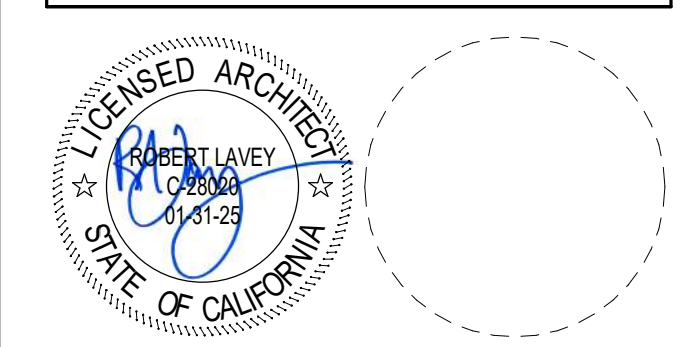

CONSULTANT


NO	DATE	BY	DESCRIPTION
1	01/25/24	PBK	ADDENDUM 1
3	03/05/24	PBK	ADDENDUM 3
REVISIONS			

DRAWN: PDF	CHECKED: SA
DATE: 11/22/2023	SCALE: 1/2" = 1'-0"
PROJECT NUMBER: 2110000	




RANCHO CUCAMONGA
8163 Rochester Avenue, Suite 100
Rancho Cucamonga, CA 91730
909-987-0909 P

**NOGALES HIGH SCHOOL
NEW BUILDING & AQUATIC CENTER**
ROWLAND UNIFIED SCHOOL DISTRICT
401 NOGALES ST., LA PUENTE, CA 91744

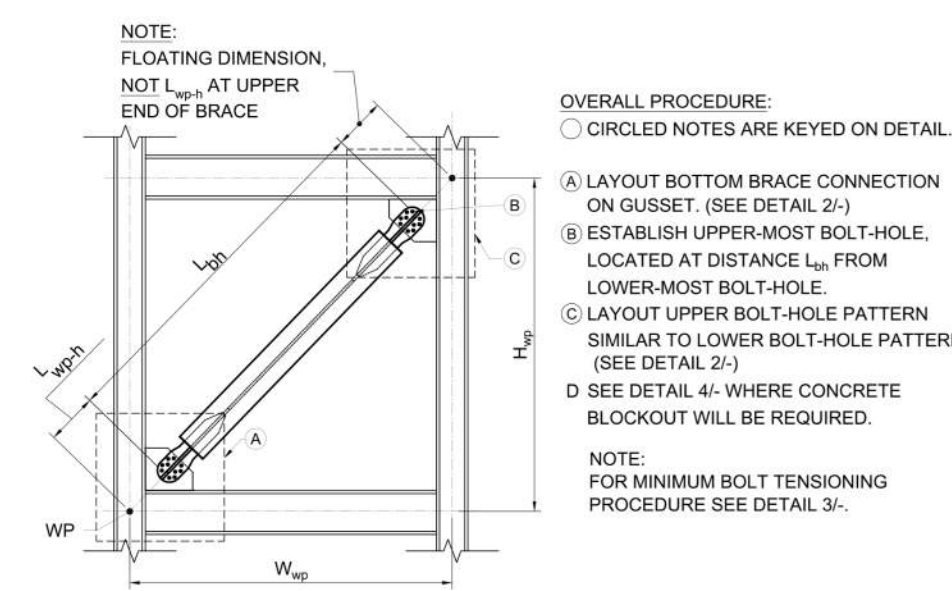

BOLTED GUSSET OVERALL LAYOUT PROCEDURE
SCALE: NTS 1

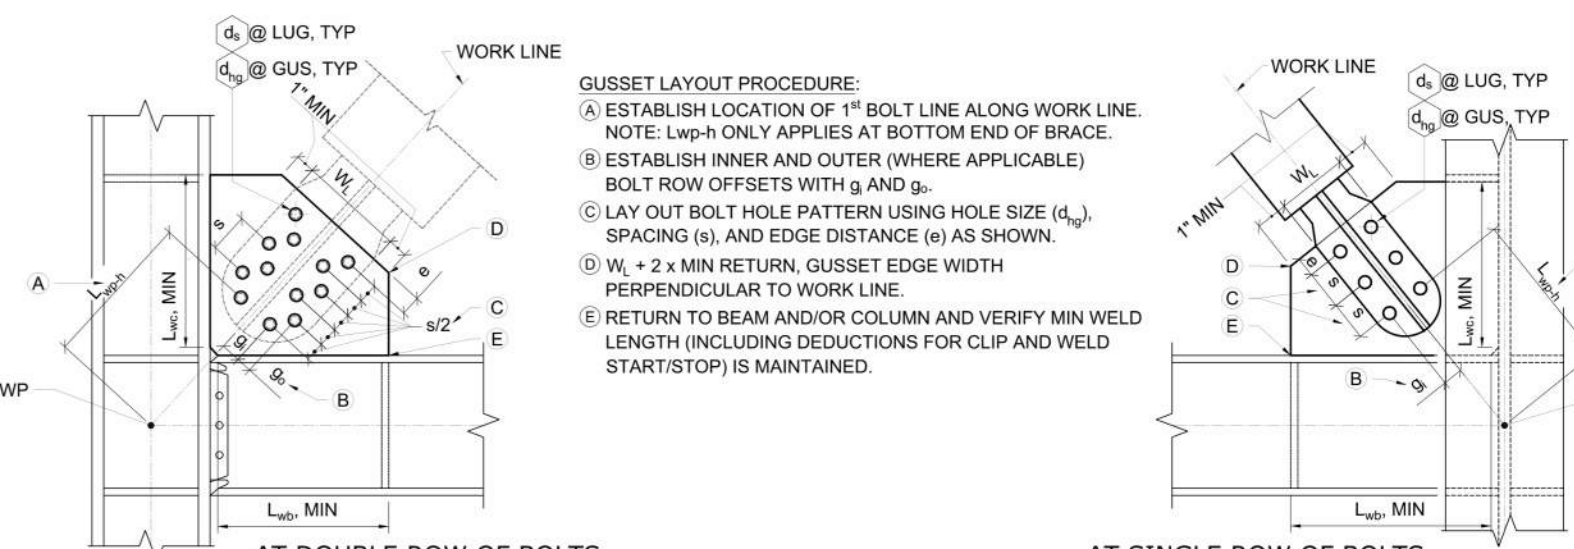


BOLTED GUSSET LAYOUT PROCEDURE
SCALE: NTS 2


MINIMUM BOLT TENSIONING PROCEDURE
Bolt tensioning shall be performed to achieve the appropriate bolt tension as set forth in the erector's approved procedures. As a minimum, the following items shall be adhered to:

- Starting with the most rigid part of the connection (Row 1) and continuing to the least rigid part of the connection (Row 4), bring all bolts to snug-tight condition.
- Recheck snug-tight condition of bolts in rows 1 and 2, re-tighten as necessary.
- Torque bolts in Row 3 to appropriate level of tension using approved procedure.
- Re-check snug tight condition of bolt in row 3.
- Continue alternating check of snug tight condition of next-to-nearest row and torquing nearest row of exterior bolts as set forth in steps D & E until end of brace is reached and all bolts are at appropriate level of torque.
- Repeat similar procedure at top end of brace.


- GENERAL NOTES:**
- Refer to all applicable code books and regulations for connection details to be installed.
 - In the absence of code, provide minimum standards under all load conditions.
 - When a portion of a brace is required to be installed in the column, provide treatment similar to that of a gusset. Where required by AISC Specifications, provide member between bolt head & gusset.
 - Bolts must be long enough to be inserted to fit with the specified hole of the plate.
 - Minimum clearance of 1/8" between bolt and hole.
 - Do not reuse bolts, nuts, or washers.

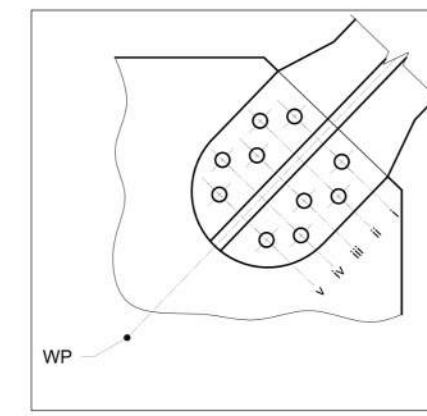


MINIMUM BOLT TENSIONING PROCEDURE
SCALE: NTS 3

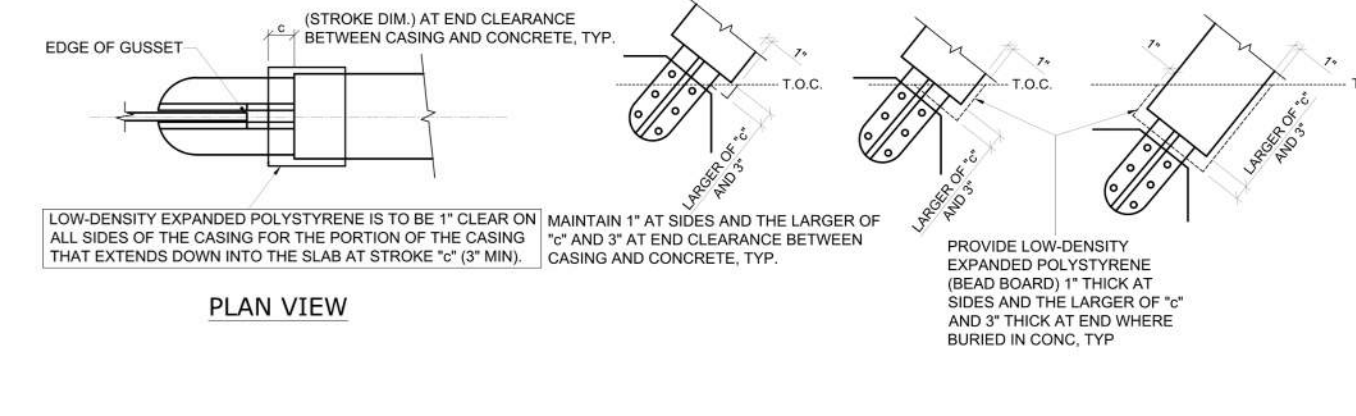


BRB CASING BURIED IN CONCRETE - TYPICAL DETAIL
SCALE: NTS 4

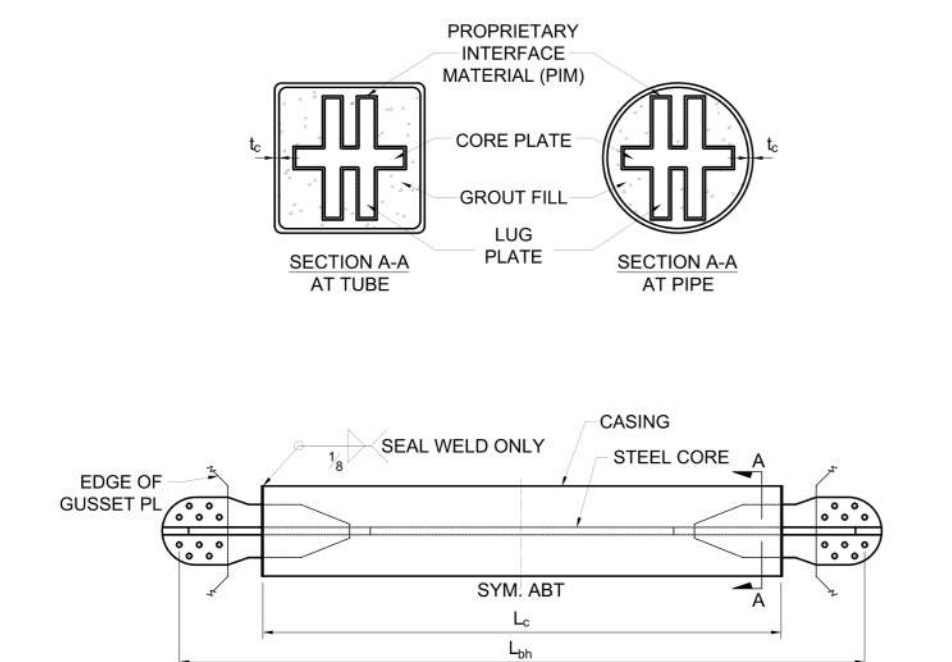


TYPICAL CORE AND CASING CONFIGURATION
SCALE: NTS 5

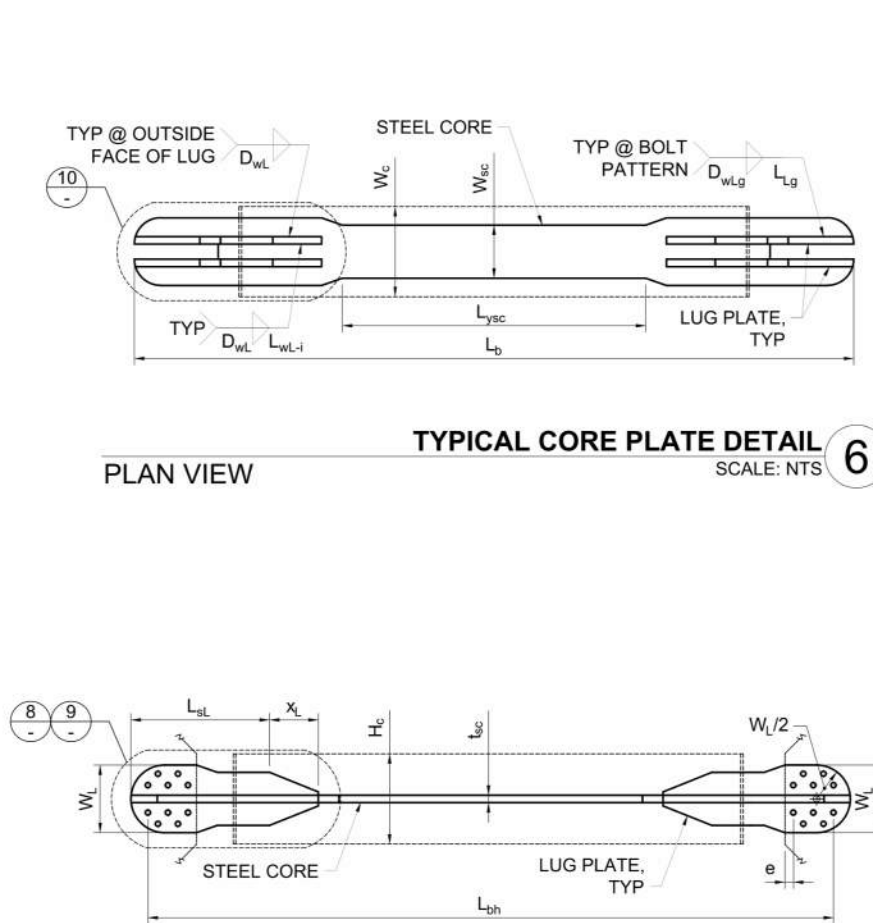


TYPICAL CORE PLATE DETAIL
SCALE: NTS 6

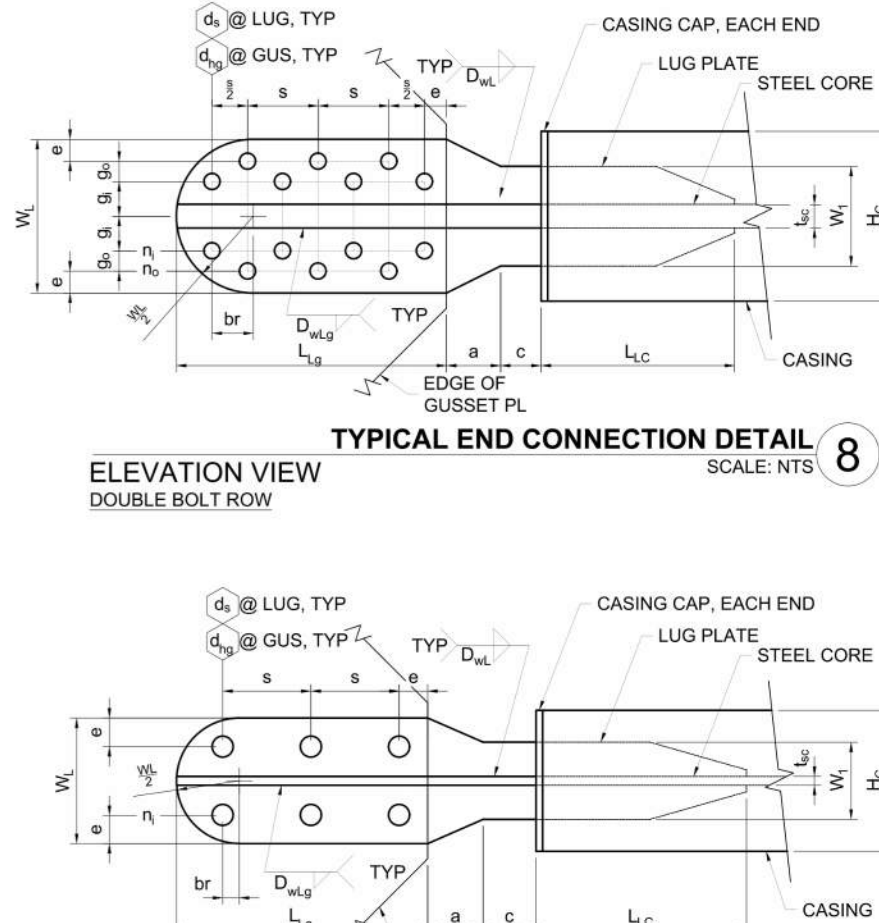


TYPICAL END CONNECTION DETAIL
SCALE: NTS 8

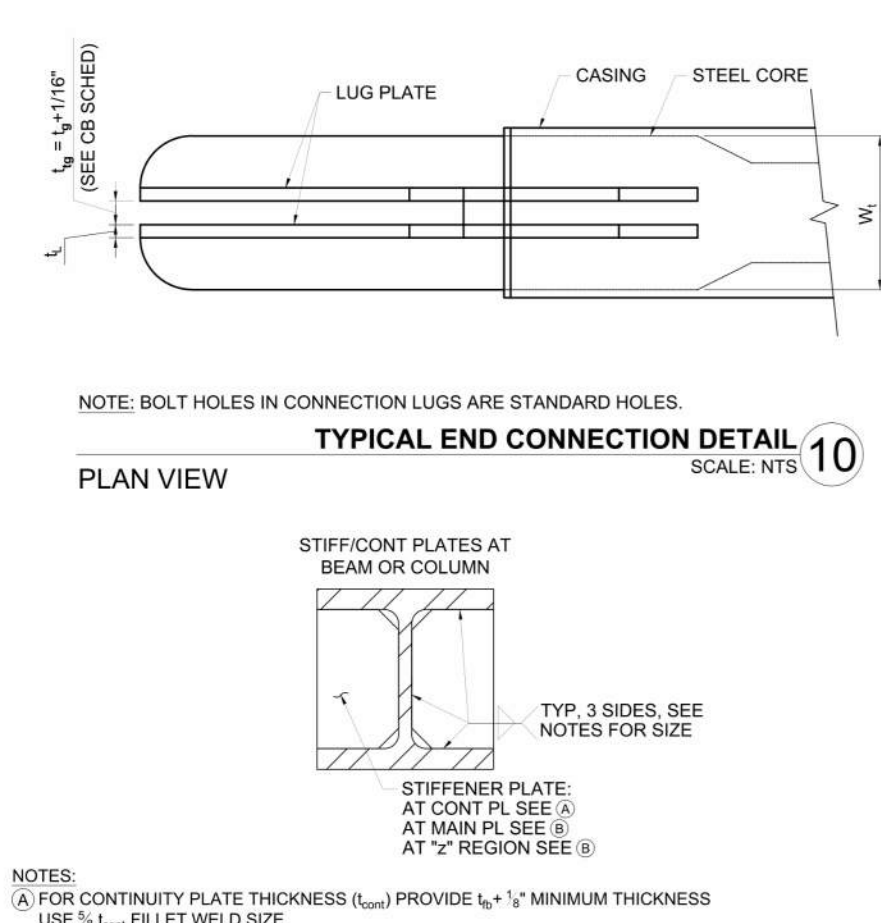


TYPICAL END CONNECTION DETAIL
SCALE: NTS 10

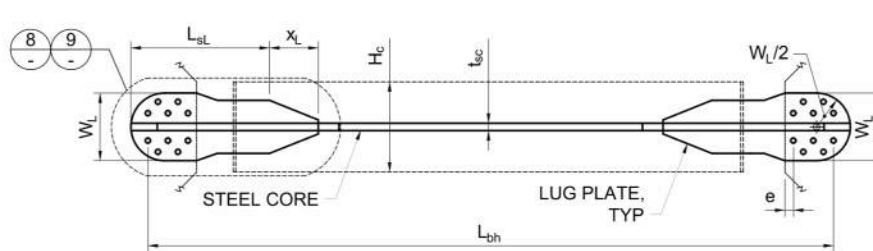

TYPICAL CORE PLATE DETAIL
SCALE: NTS 7

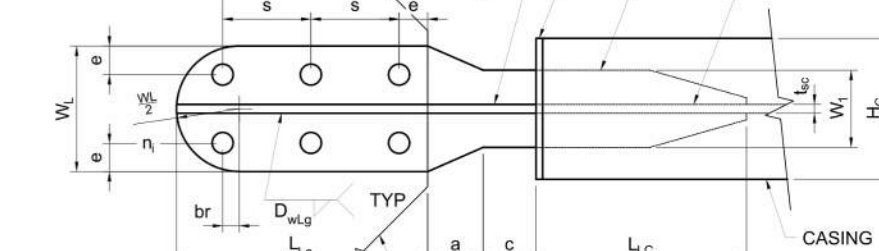


TYPICAL END CONNECTION DETAIL
SCALE: NTS 9

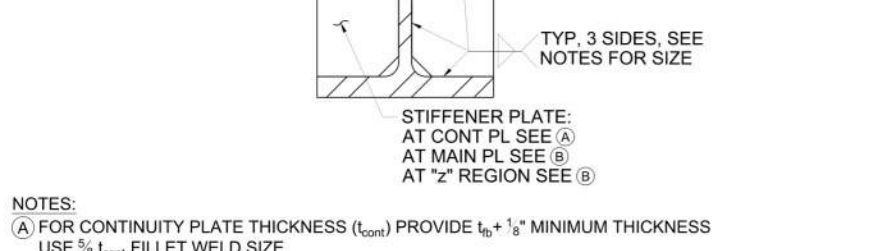

STIFFENING PL. TO MEMBER
SCALE: NTS 11


NOT USED
SCALE: NTS 12

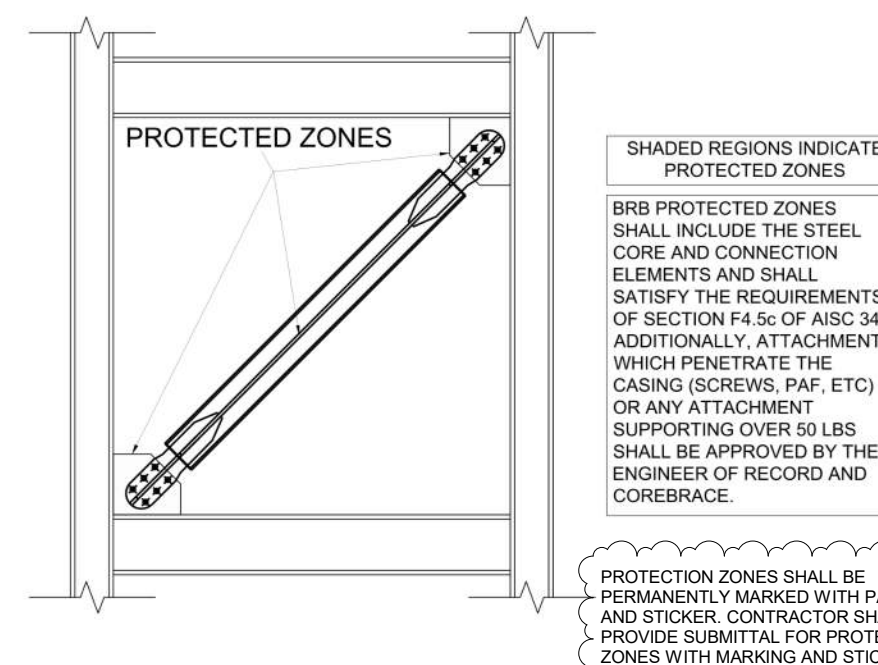


PROTECTED ZONES - AISC 341
SCALE: NTS 13

- GENERAL NOTES:**
- SEE PROJECT DRAWINGS FOR ADDITIONAL INFORMATION.
 - DIMENSIONS AND WP LOCATIONS FROM PROJECT DRAWINGS GOVERN.
 - CONTACT COREBRACE PRIOR TO DETAILING IF ANY DISCREPANCIES ARE NOTED.
 - CORE PL. A36 SPECIAL (FY RANGE PROVIDED ON COREBRACE SCHEDULE).
 - CASING A500 GR B FOR HSS AND A53 GR B FOR PIPE.
 - BRB LUG PLATE (TRANSVERSE STIFFENER) A572 GR 50.
 - GUSSET PL., GUSSET STIFFENER AND REPAD PL. A572 GR 50 U.N.O.
 - ALL STIFFENERS AND DOUBLER PL. TO MATCH BEAM AND COLUMN GRADE.
 - USE ASTM F3125 GR A490-SCF2280-TC OR ASTM F3148 TNA BOLTS.
 - BOLT HOLES IN GUSSET ARE OVERSIZED. BOLT HOLES IN BRB ARE STANDARD.
 - CLASS A (TOOL CLEAN) ALL FAYING SURFACES.
 - GALVANIZED FAYING SURFACES TO BE HAND WIRE BRUSHED PRIOR TO ERECTION OF BRB.
 - THE GAP BETWEEN THE BOLTED CONNECTION PLATES AT THE END OF THE BRB SHALL NOT BE INCREASED EXCEPT IN INSTANCES WHERE SPECIFIC APPROVAL AND METHODOLOGY HAVE BEEN PROVIDED BY COREBRACE.


- CONNECTION NOTES:**
- CIRCLED NOTES ARE KEYS ON CONNECTION DETAILS.
 - SEE STRUCTURAL DRAWINGS FOR BEAM/BASE PLATE CONNECTION, TYP.
 - SEE CONNECTION SCHEDULE FOR CONNECTION DIMENSIONS.
 - SEE COREBRACE SCHEDULE FOR BRB GEOMETRY DIMENSIONS.
 - MAIN STIFF PL. EA. SIDE AS REQ'D BY STRUCTURAL DRAWINGS OR AS INDICATED ON CONNECTION SCHEDULE. SEE DETAIL 11.
 - FIELD INSTALL STIFF PL. AS NECESSARY FOR INSTALLATION OF BRACE.
 - WELD BOTH SIDES, WHERE GUSSET PL. IS LONGER THAN REQ'D WELD LENGTH, PROVIDE WELD ALONG ENTIRE LENGTH TO WITHIN 1/2" OF EDGE OF PL.
 - TOP AND BOTTOM FLANGE LATERAL BRACINGS AS REQUIRED BY STRUCTURAL DRAWINGS.
 - CONTINUITY PLATE WHERE REQ'D BY STRUCTURAL DRAWINGS, AT WEAK-AXIS COLUMN, ALWAYS PROVIDE CONTINUITY PLATE T&B AND N&S. SEE DETAIL 11.

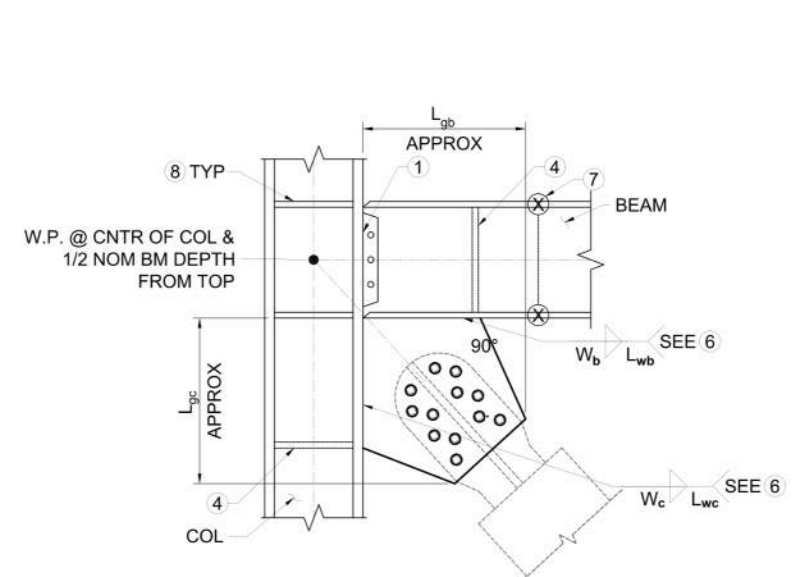

GUSSET CONNECTION AT ROOF
SCALE: NTS 14

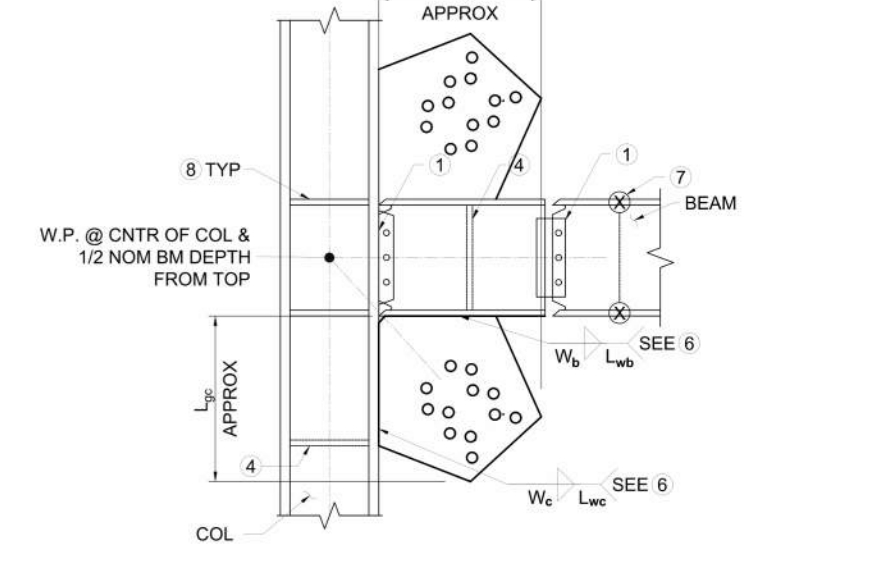

EXTENDED GUSSET CONNECTION AT LEVEL 2
SCALE: NTS 15

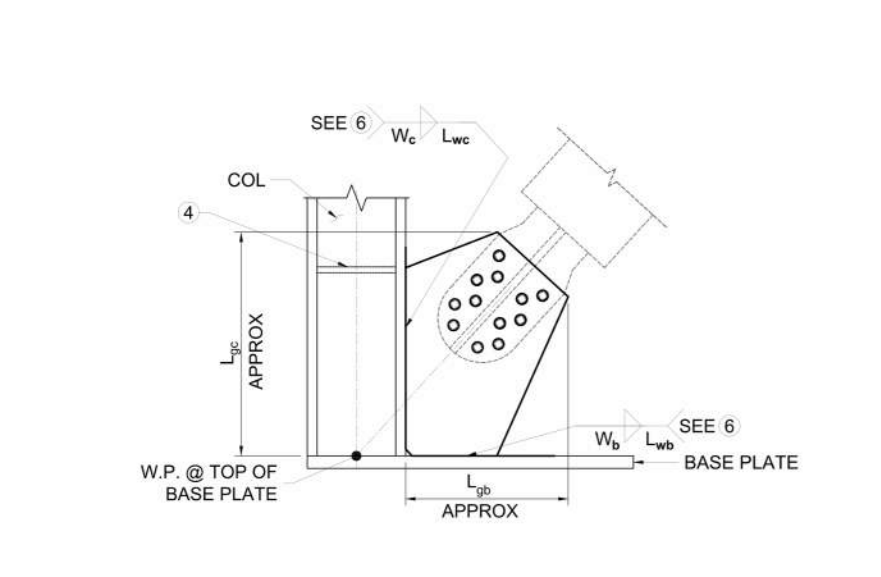

GUSSET CONNECTION AT BASEPLATE
SCALE: NTS 16

- BRB ENGINEERING DESIGN RESPONSIBILITY IS LIMITED TO THE FOLLOWING:
- COMPLETE BRB DESIGN BASED ON AISC PROVIDED IN STRUCTURAL DRAWINGS.
 - DESIGN GUSSET PLATE AND CONNECTION OF BRB TO GUSSET PLATE.
 - DESIGN CONNECTION OF GUSSET TO FRAME COLUMNS & BEAMS/BASE PLATES.



0780 W. Walsh Park Rd.
West Orange, NJ 07061
(851) 280-0701



CONSULTANT
miyamoto.
1201 West Orange Street, Suite A
Ontario, CA 91762
909-987-0909
myamoto@miyamoto.com

NO	DATE	BY	DESCRIPTION
			REVISIONS
3	03/05/24		ADDENDUM 3

DRAWN: DG
CHECKED: MS/FR
DATE: 11/23/22
SCALE:
PROJECT NUMBER: 2110000

**COREBRACE BRB
DETAILS**

DRAWING NUMBER: **S0.11**

COREBRACE
BRACE AND GUSSET
CONNECTION DETAILS

KEY NOTES

- 1 10x10 UP TO EF-1 ON ROOF.
- 2 12x12 UP TO EF-2 ON ROOF.
- 3 TYPICAL DUCT WITH 2" INTERNAL INSULATION. SHALL INCLUDE VERTICAL DUCT PLENUMS, & FITTINGS FROM RT UNITS TO LOCATIONS SHOWN ON PLANS.
- 4 REFER TO FAN COIL SCHEDULES FOR OA WHEN BALANCING (TYP ALL FAN COILS).
- 5 LOUVER CENTERED ABOVE DOORS AT 14'-0" TO THE TOPSIDE OF THE LOUVER FROM FLOOR LEVEL.
- 6 PROVIDE REFRIGERANT PIPING TO HP'S ABOVE MANUFACTURERS RECOMMENDATIONS. (TYP)
- 7 INSTALL FAN COIL WITH CLEARANCE AS PER MANUFACTURER. (TYP)
- 8 AC-1 FOR IT ROOM.
- 9 AC-2 FOR IT ROOM.
- 10 ALL DUCTS SHALL BE SUPPORTED AS SHOWN ON DETAILS 2.38 AND 2.50 ON SHEET M6.4. (TYPICAL)
- 11 PROVIDE COVERS FOR THERMOSTATS IN LOCKER ROOMS.
- 12 PROVIDE DRYER VENTING BOX MODEL DEFLECCO DVBOX 17.38 x 11.5 x 4.5 IN WALL AT 54" AFF TO TOP OF BOX. RUN 4" DRYER DUCT FROM VENTING BOX TO LOUVER AT 14'-0" FROM FLOOR TO TOP OF LOUVER. DRYER DUCT SHALL BE 4" DIAMETER ALUMINUM DUCT LAPPED IN THE DIRECTION OF AIRFLOW AND SECURED WITHOUT SCREWS PENETRATING INSIDE THE DUCT.





RANCHO CUCAMONGA
8163 Rochester Avenue, Suite 100
Rancho Cucamonga, CA 91730
909-987-0909 P

NOGALES HIGH SCHOOL & AQUATIC CENTER
ROWLAND UNIFIED SCHOOL DISTRICT
401 NOGALES ST., LA PUENTE, CA 91744

GENERAL NOTES

- 1. ALL DUCTS SHALL BE SUPPORTED AND BRACED AS SHOWN ON DETAILS 2.38 AND 2.50 ON SHEET M6.4 AND STRUCTURAL DETAILS 8, 12 & 14 ON SD 7. (TYPICAL)
- 2. PROVIDE 2" INTERNAL DUCT INSULATION ON ALL DUCTS WHERE SHOWN INSIDE THE BUILDING ENVELOPE. PROVIDE 2" INTERNAL DUCT INSULATION ON ALL DUCTS LOCATED OUTSIDE OF THE BUILDING ENVELOPE. EXTERNAL INSULATION IS NOT REQUIRED ON ANY SECTION OF DUCT WITH INTERNAL INSULATION.
- 3. ALL DUCT SIZES SHOWN ARE CLEAR INSIDE DIMENSIONS.
- 4. WHERE NOT SPECIFICALLY INDICATED REFER TO SPECIFICATIONS FOR INSULATION REQUIREMENTS.

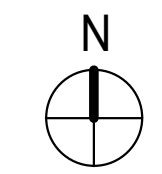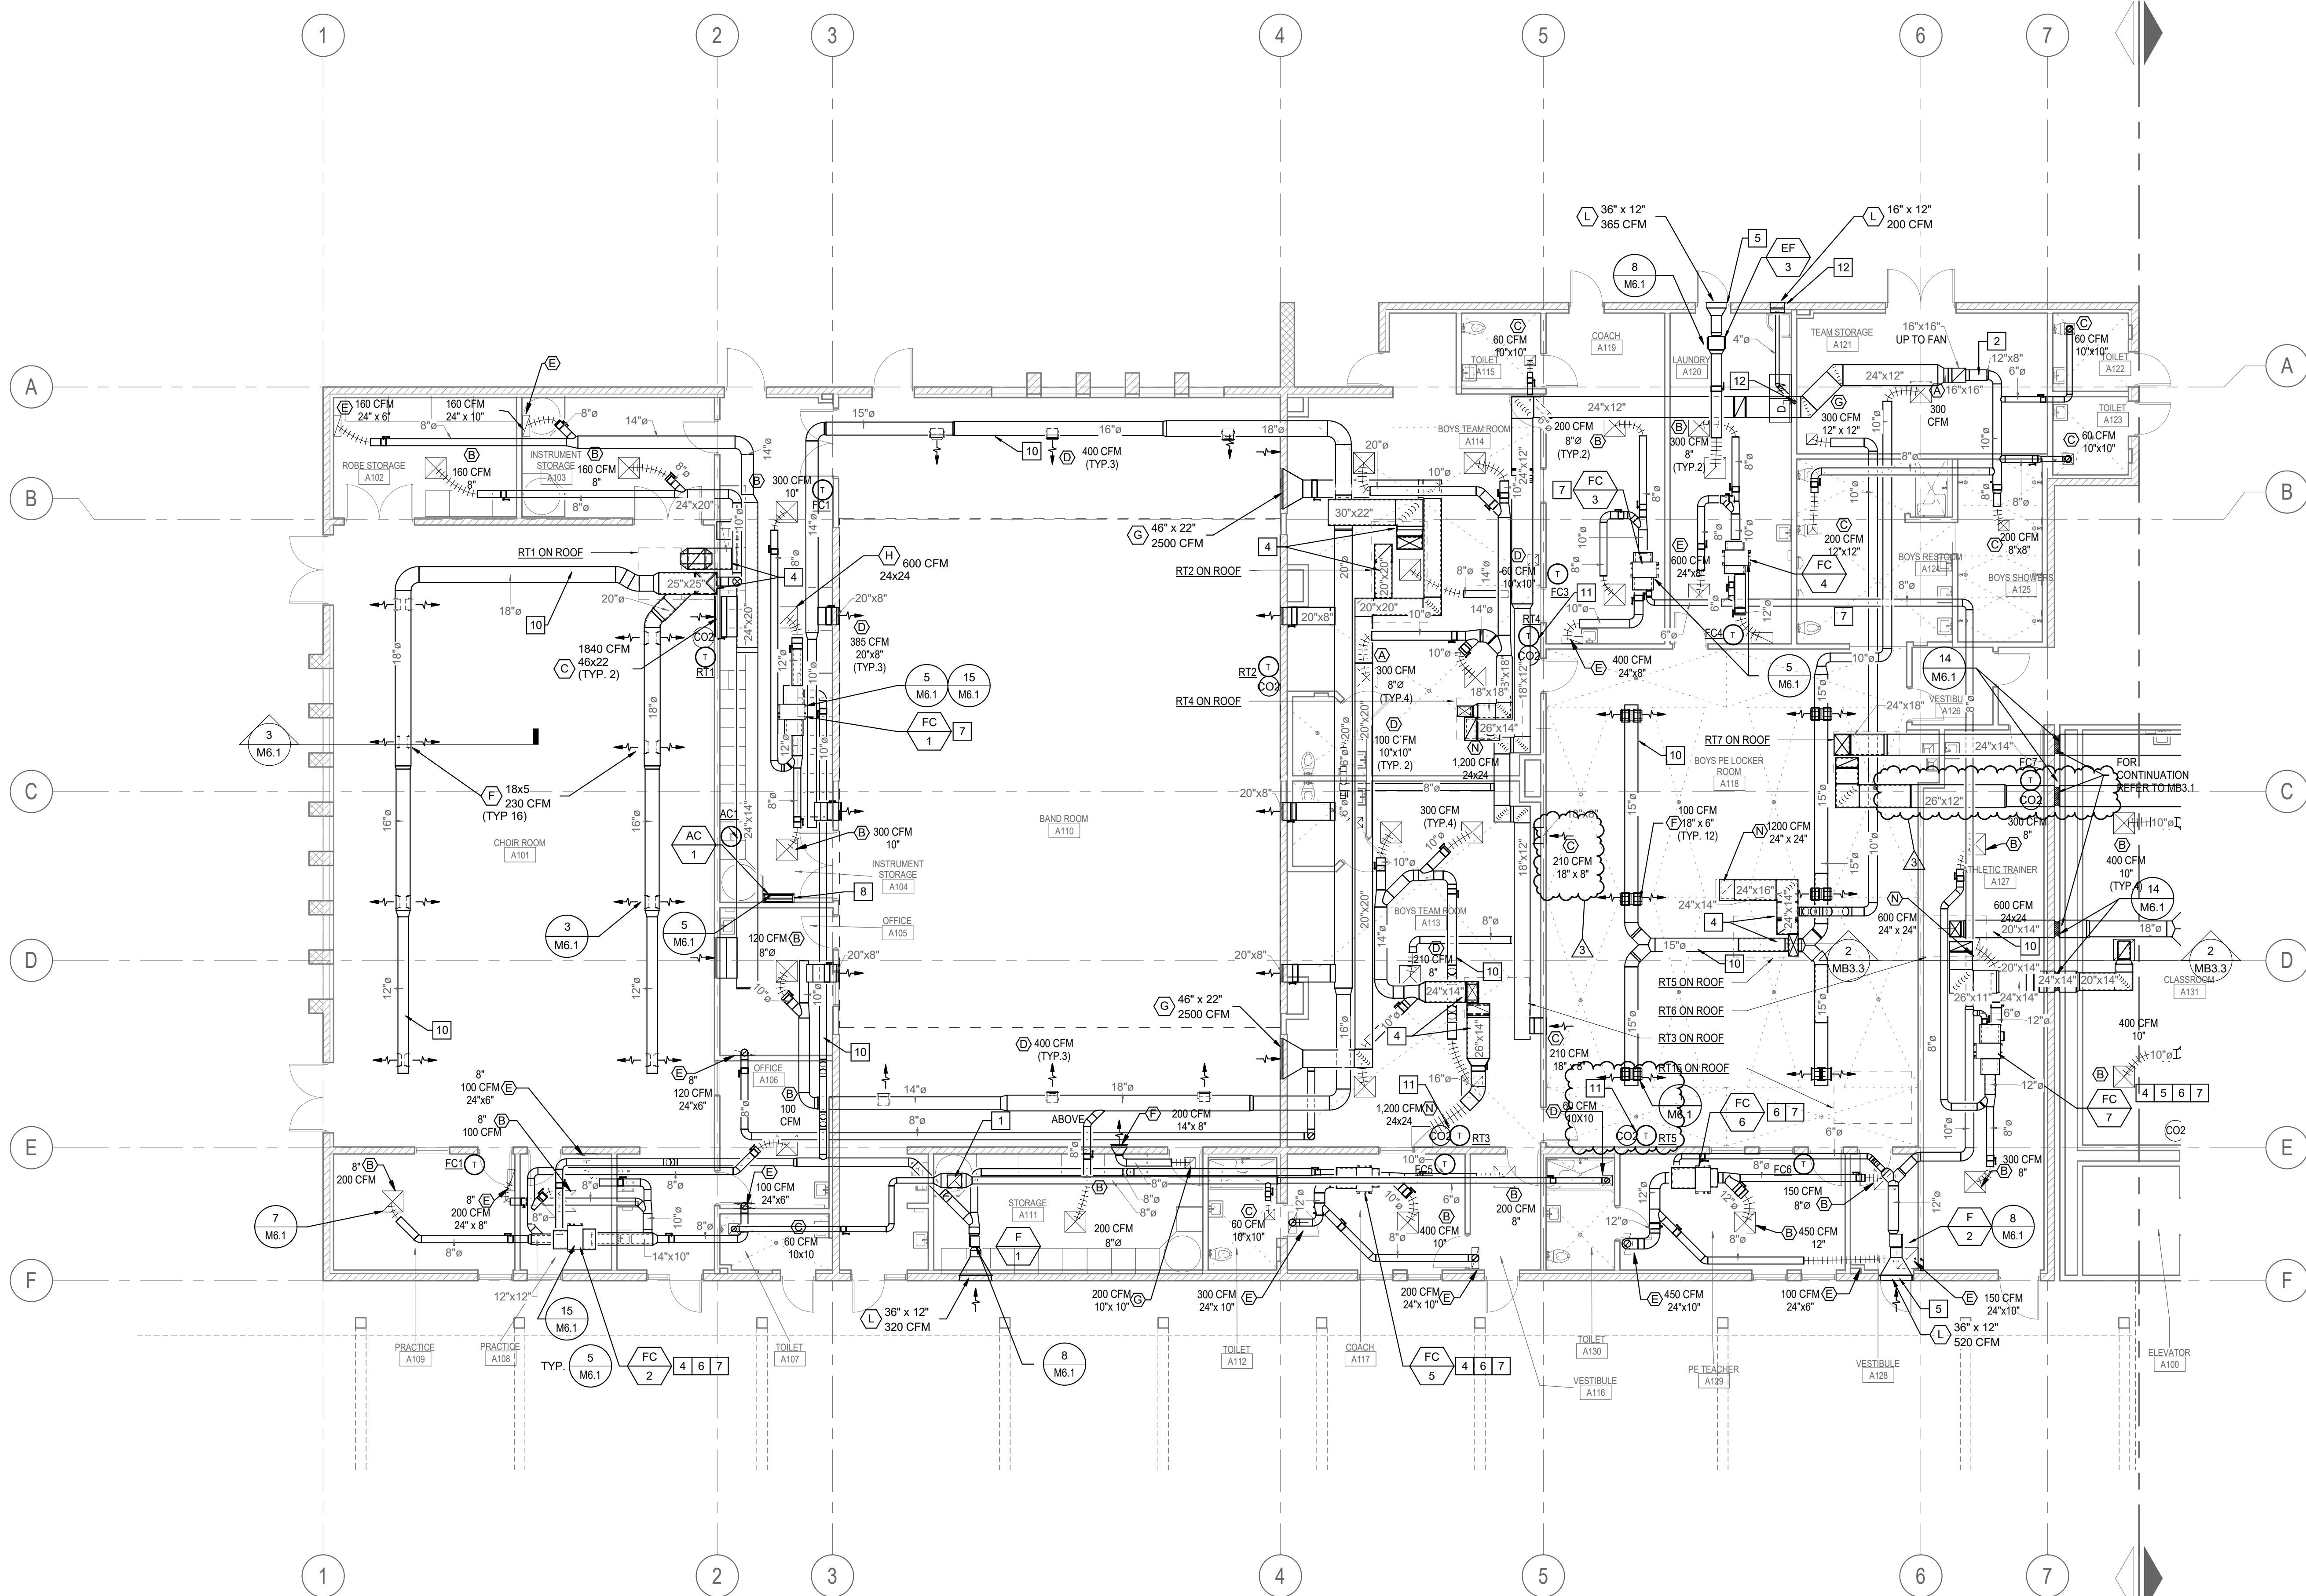

CONSULTANT
LEAF ENGINEERS
8163 Rochester Avenue, Suite 100
Rancho Cucamonga, CA 91730
909-987-0909
leafengineers.com


1	01/25/24	PBK	ADDENDUM 1
2	03/05/24	PBK	ADDENDUM 2
3	02/27/24	PBK	ADDENDUM 3

NO	DATE	BY	DESCRIPTION
REVISIONS			

DRAWN: JM	CHECKED: RW
DATE: 12-02-2022	SCALE: 1/8" = 1'-0"
PROJECT NUMBER: 2110000	

MECHANICAL FIRST FLOOR PLAN - AREA A

DRAWING NUMBER: **MA2.1**

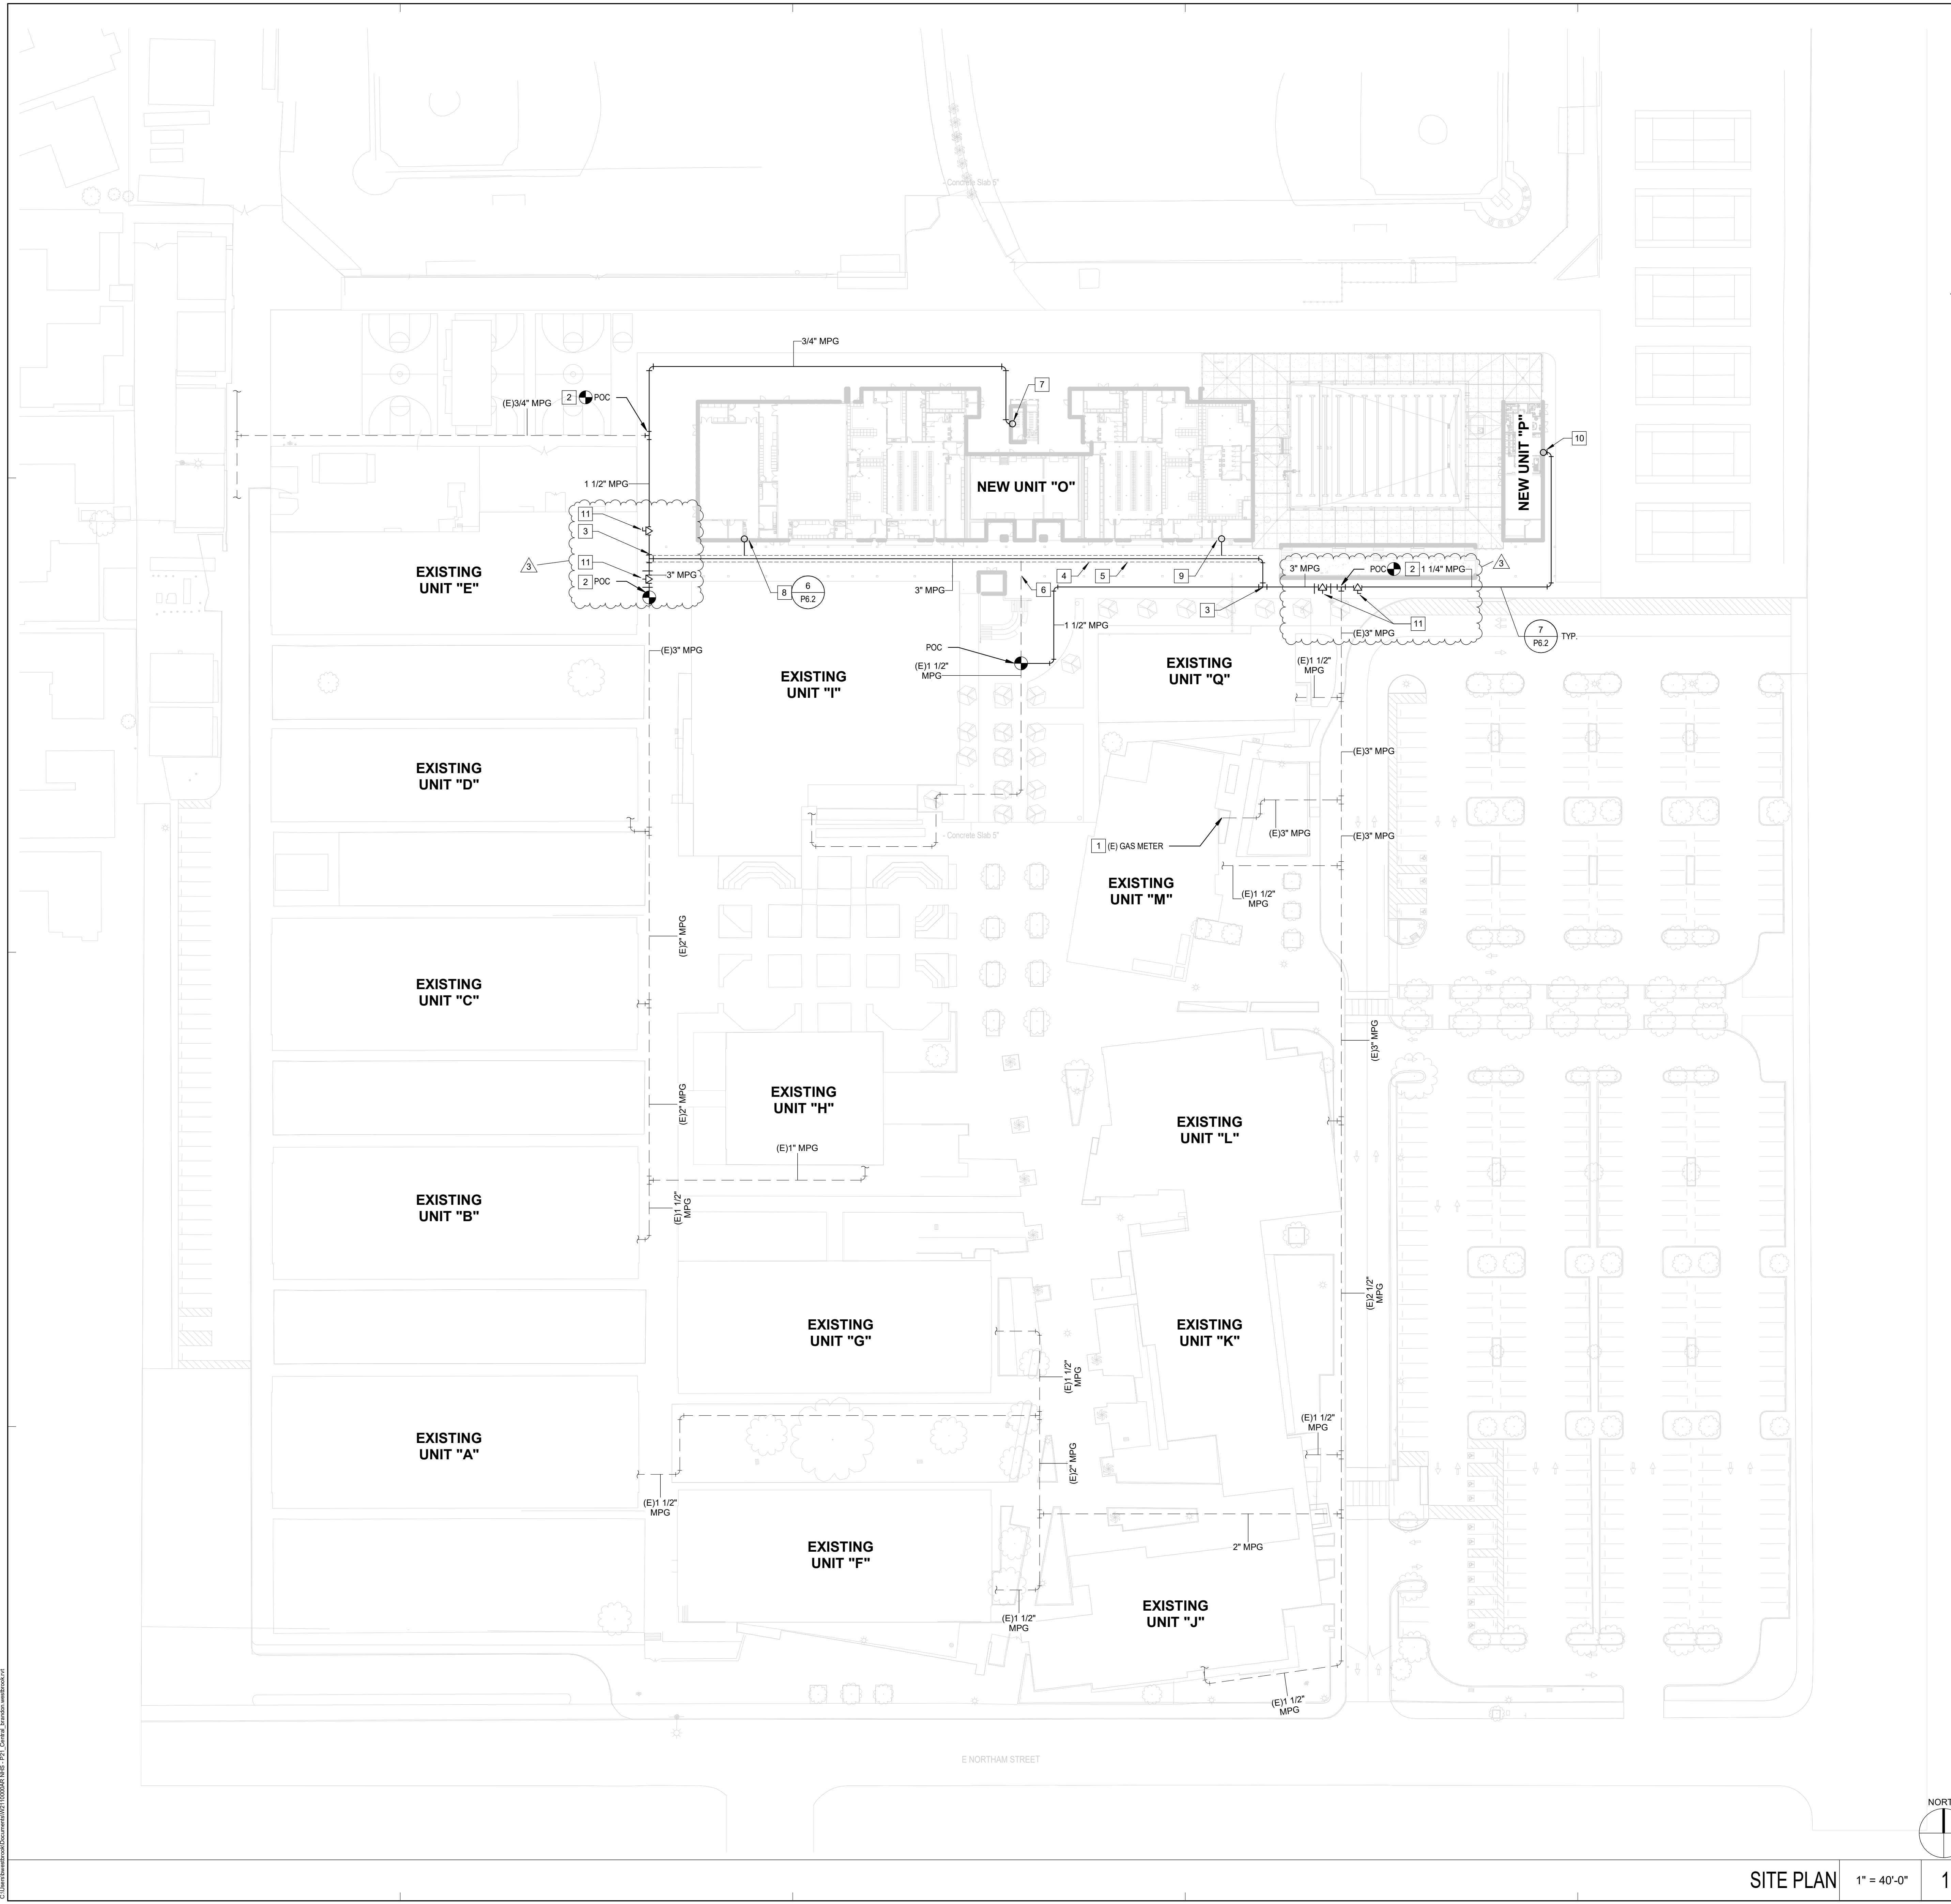

KEY NOTES

- 1 (E) GAS METERS AND SERVICE PIPING BY PG&E. CONTRACTOR SHALL ARRANGE FOR UPGRADE OF METER AND SERVICE AND OWNER SHALL PAY ALL COSTS ADDED. TOTAL DEMAND ADDED 2500 MBH.
- 2 POC (N) MPG PIPE TO (E) 3" MPG PIPE.
- 3 LOCATE GAS TEE OUTSIDE OF NEW BUILDING OVERHANG.
- 4 REMOVE AND REPLACE (E) SLEEVED 3" MPG PIPE BELOW OVERHANG. EXTEND NEW SLEEVE 24" PAST NEW OVERHANG. FIELD VERIFY LOCATION OF EXISTING PIPE.
- 5 SLEEVE AND VENT 1-1/2" MPG PIPING BELOW OVERHANG.
- 6 REMOVE (E) 1-1/2" MPG PIPING BELOW GRADE.
- 7 GAS PIPING TO RISE UP AND ELBOW INTO WALL ABOVE FOOTING. SEE SHEET P2.3.2 FOR CONTINUATION.
- 8 ROUTE 2" VENT PIPE TO BUILDING "O." SEE SHEET P2.2.2 FOR CONTINUATION.
- 9 ROUTE 2" VENT PIPE TO BUILDING "O." SEE SHEET P2.2.2 FOR CONTINUATION.
- 10 GAS PIPING TO RISE UP AND ELBOW INTO WALL ABOVE FOOTING. SEE SHEET P3.1 FOR CONTINUATION.
- 11 FULL SIZE GAS SHUT-OFF VALVE IN CHRISTY BOX.


DEMOLITION NOTES

1. DEMOLISH ALL EXISTING MEDIUM PRESSURE GAS IN CONSTRUCTION AREA.



RANCHO CUCAMONGA
8163 Rochester Avenue, Suite 100
Rancho Cucamonga, CA 91730
909-987-0909 P

NOGALES HIGH SCHOOL & AQUATIC CENTER
ROWLAND UNIFIED SCHOOL DISTRICT
401 NOGALES ST., LA PUENTE, CA 91744

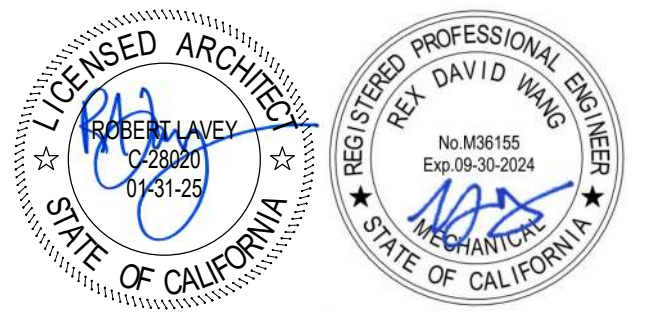

CONSULTANT
LEAF ENGINEERS
8163 Rochester Avenue, Suite 100
Rancho Cucamonga, CA 91730
909-987-0909
leafengineers.com


1	01/25/24	PBK	ADDENDUM 1
2	02/19/24	PBK	ADDENDUM 2
3	03/05/24	PBK	ADDENDUM 3

NO	DATE	BY	DESCRIPTION
REVISIONS			

DRAWN: Author CHECKED: Checker
DATE: 06/24/22 SCALE: 1" = 40'-0"
PROJECT NUMBER: 2110000

PLUMBING SITE PLAN

DRAWING NUMBER: **P1.1**


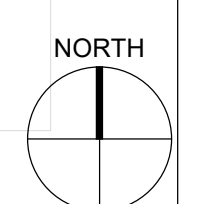


M:\2024\A\012124\...
 C:\Users\...



RANCHO CUCAMONGA
8163 Rochester Avenue, Suite 100
Rancho Cucamonga, CA 91730
909-987-0909 P


NOGALES HIGH SCHOOL & AQUATIC CENTER
ROWLAND UNIFIED SCHOOL DISTRICT
401 NOGALES ST., LA PUENTE, CA 91744

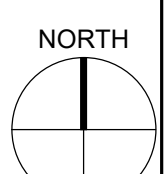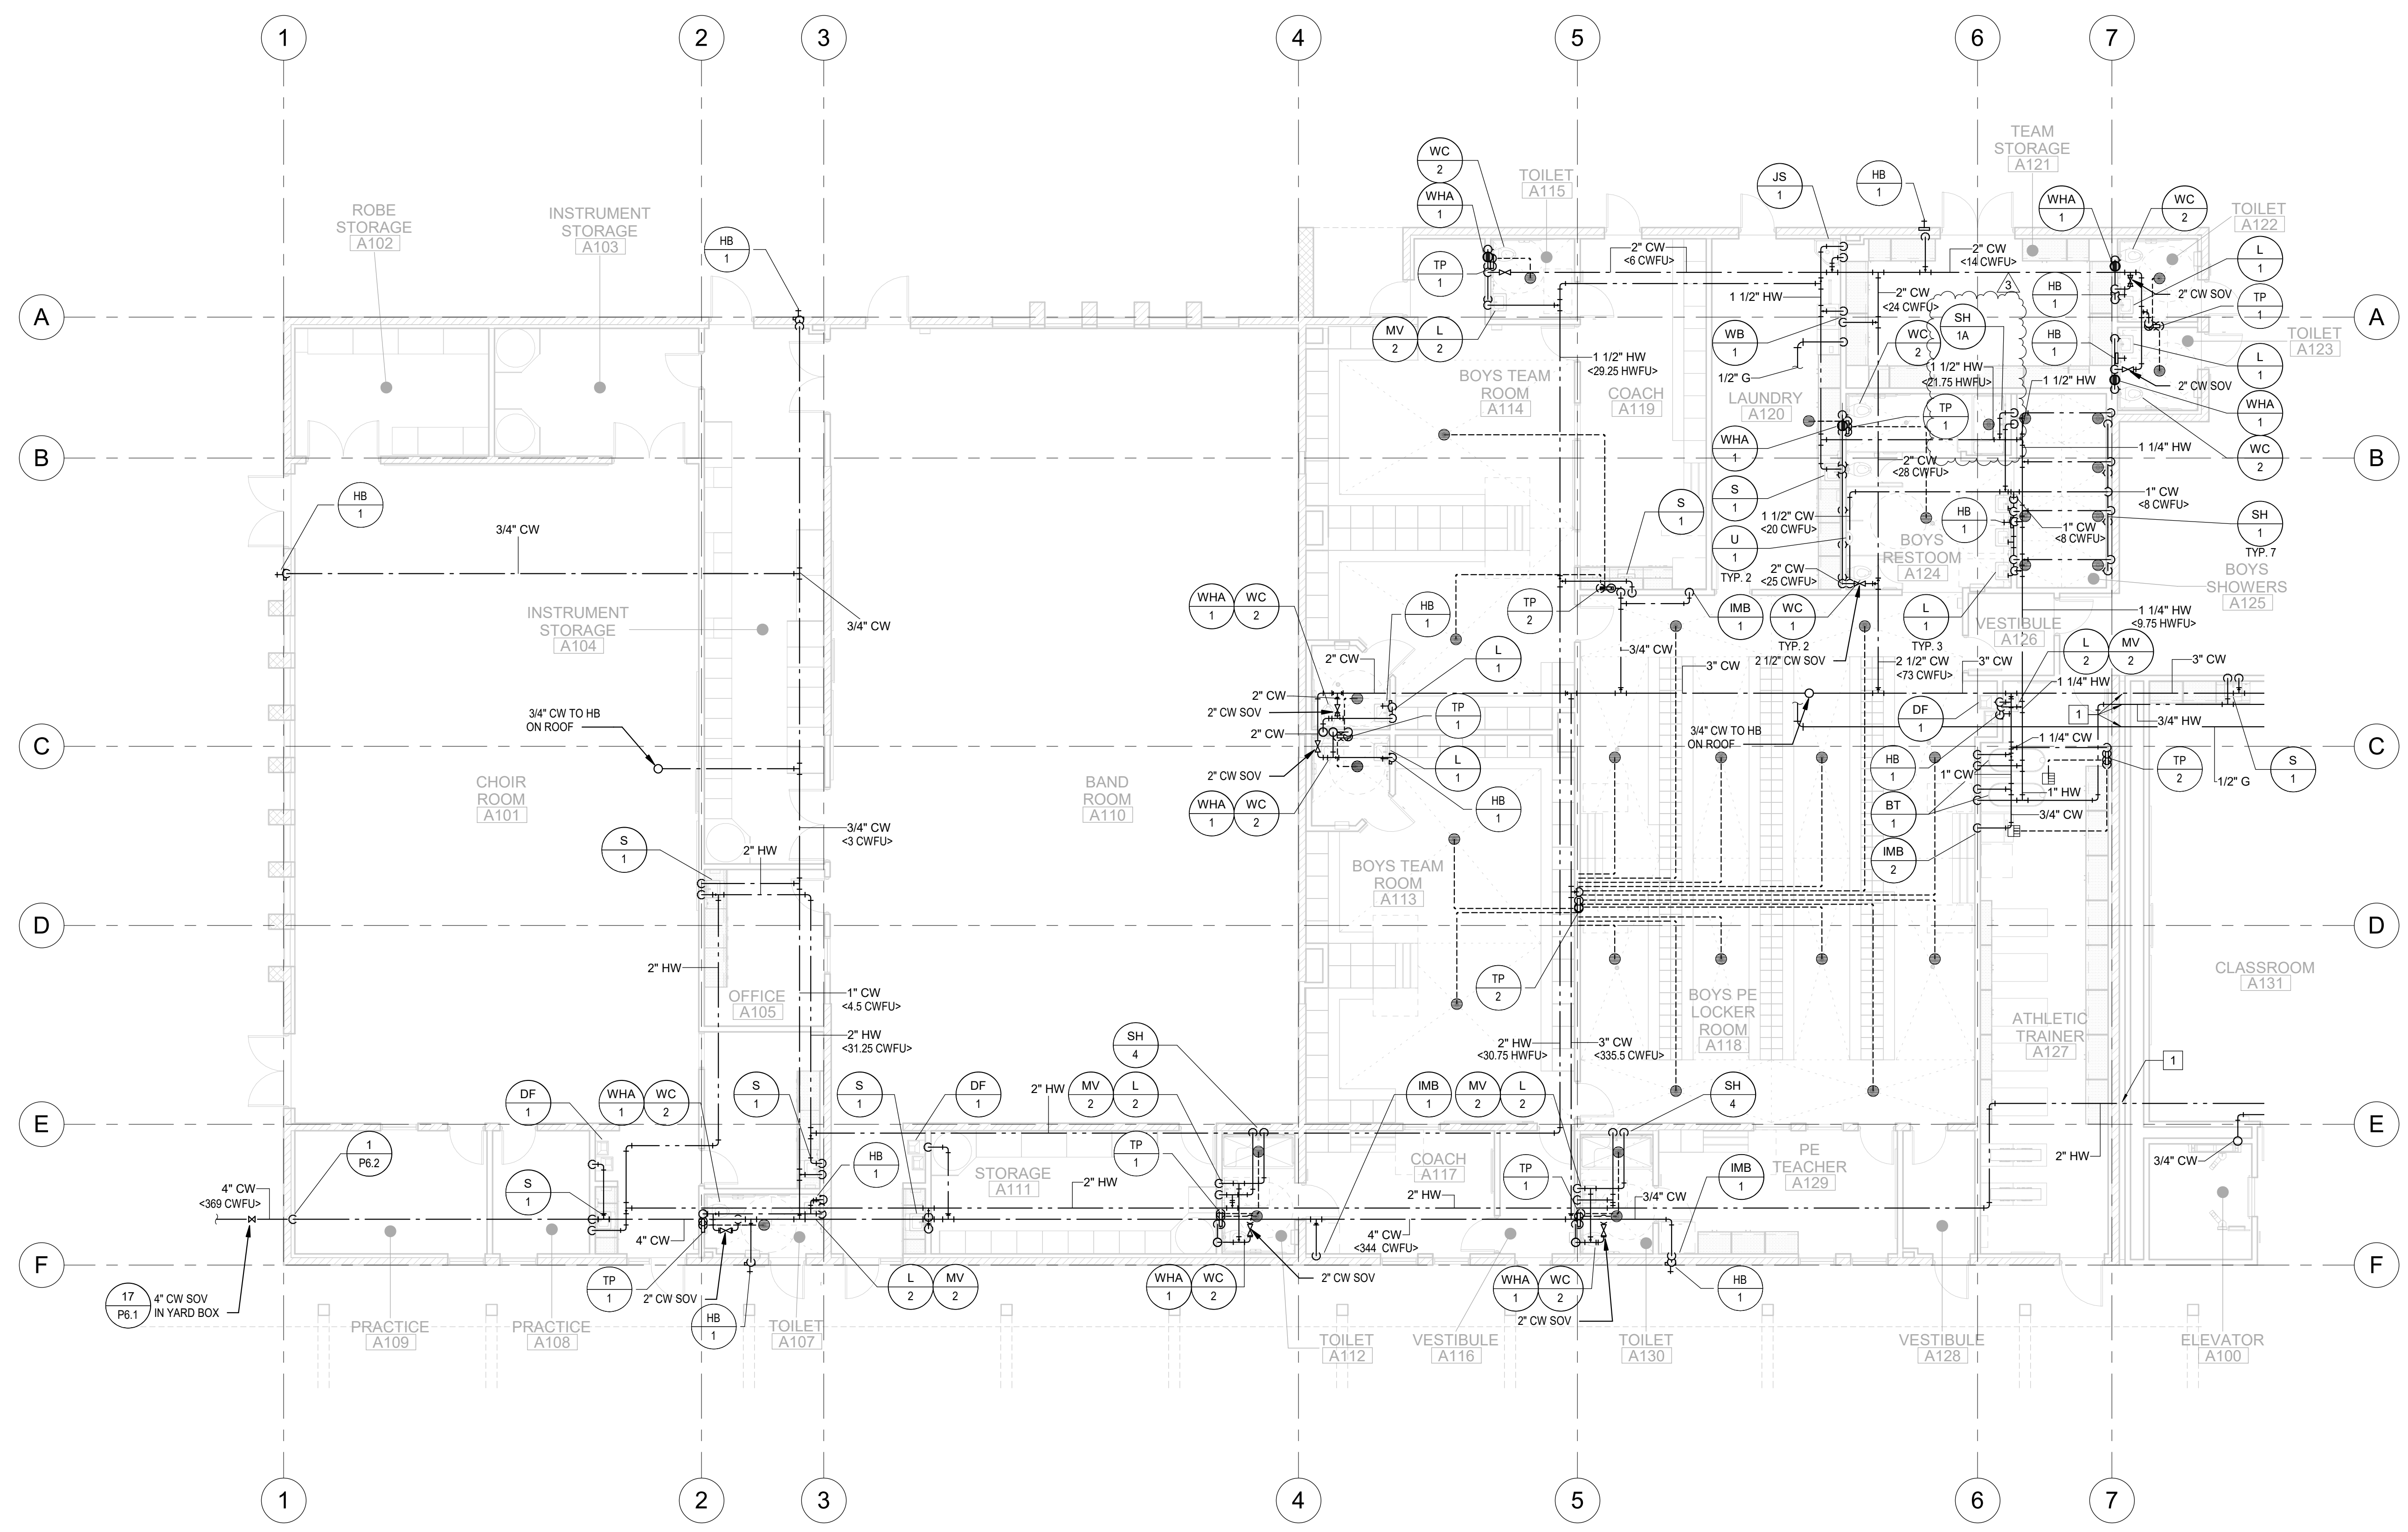

PLUMBING FIRST FLOOR PLAN - AREA A - WATER AND GAS 1/8" = 1'-0" 1

KEYNOTES:

- 1 PROVIDE METRIFLEX EXPANSION JOINTS FOR ALL PIPING CROSSING SEISMIC JOINTS. SEE DETAIL 9 ON SHEET P6.1

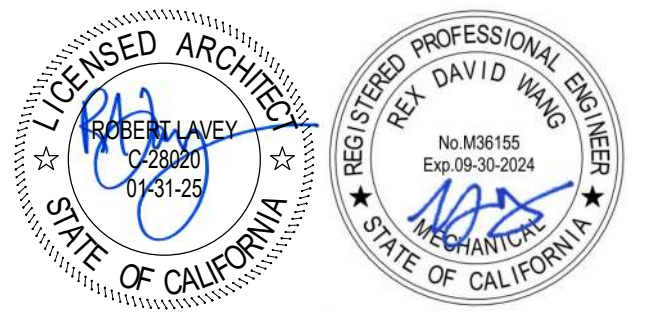

CONSULTANT
LEAF ENGINEERS
8163 Rochester Avenue, Suite 100
Rancho Cucamonga, CA 91730
909.987.0909
leafengineers.com

1	01/25/24	PBK	ADDENDUM 1
2	02/19/24	PBK	ADDENDUM 2
3	03/05/24	PBK	ADDENDUM 3

NO	DATE	BY	DESCRIPTION
REVISIONS			

DRAWN: Author CHECKED: Checker
DATE: 10/19/22 SCALE: 1/8" = 1'-0"
PROJECT NUMBER: 2110000

**PLUMBING 1ST FLR
PLN - AREA A -
WATER AND GAS**

DRAWING NUMBER: **P2.2.2**

M:\2024\A\02744 -
 C:\Users\mwhitlock\Documents\2110000\NHS_P2_2\Drawn - 2024.mwhitlock.rvt





RANCHO CUCAMONGA
8163 Rochester Avenue, Suite 100
Rancho Cucamonga, CA 91730
909-987-0909 P

NOGALES HIGH SCHOOL & AQUATIC CENTER

ROWLAND UNIFIED SCHOOL DISTRICT

401 NOGALES ST., LA PUENTE, CA 91744

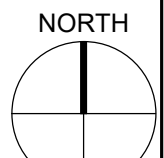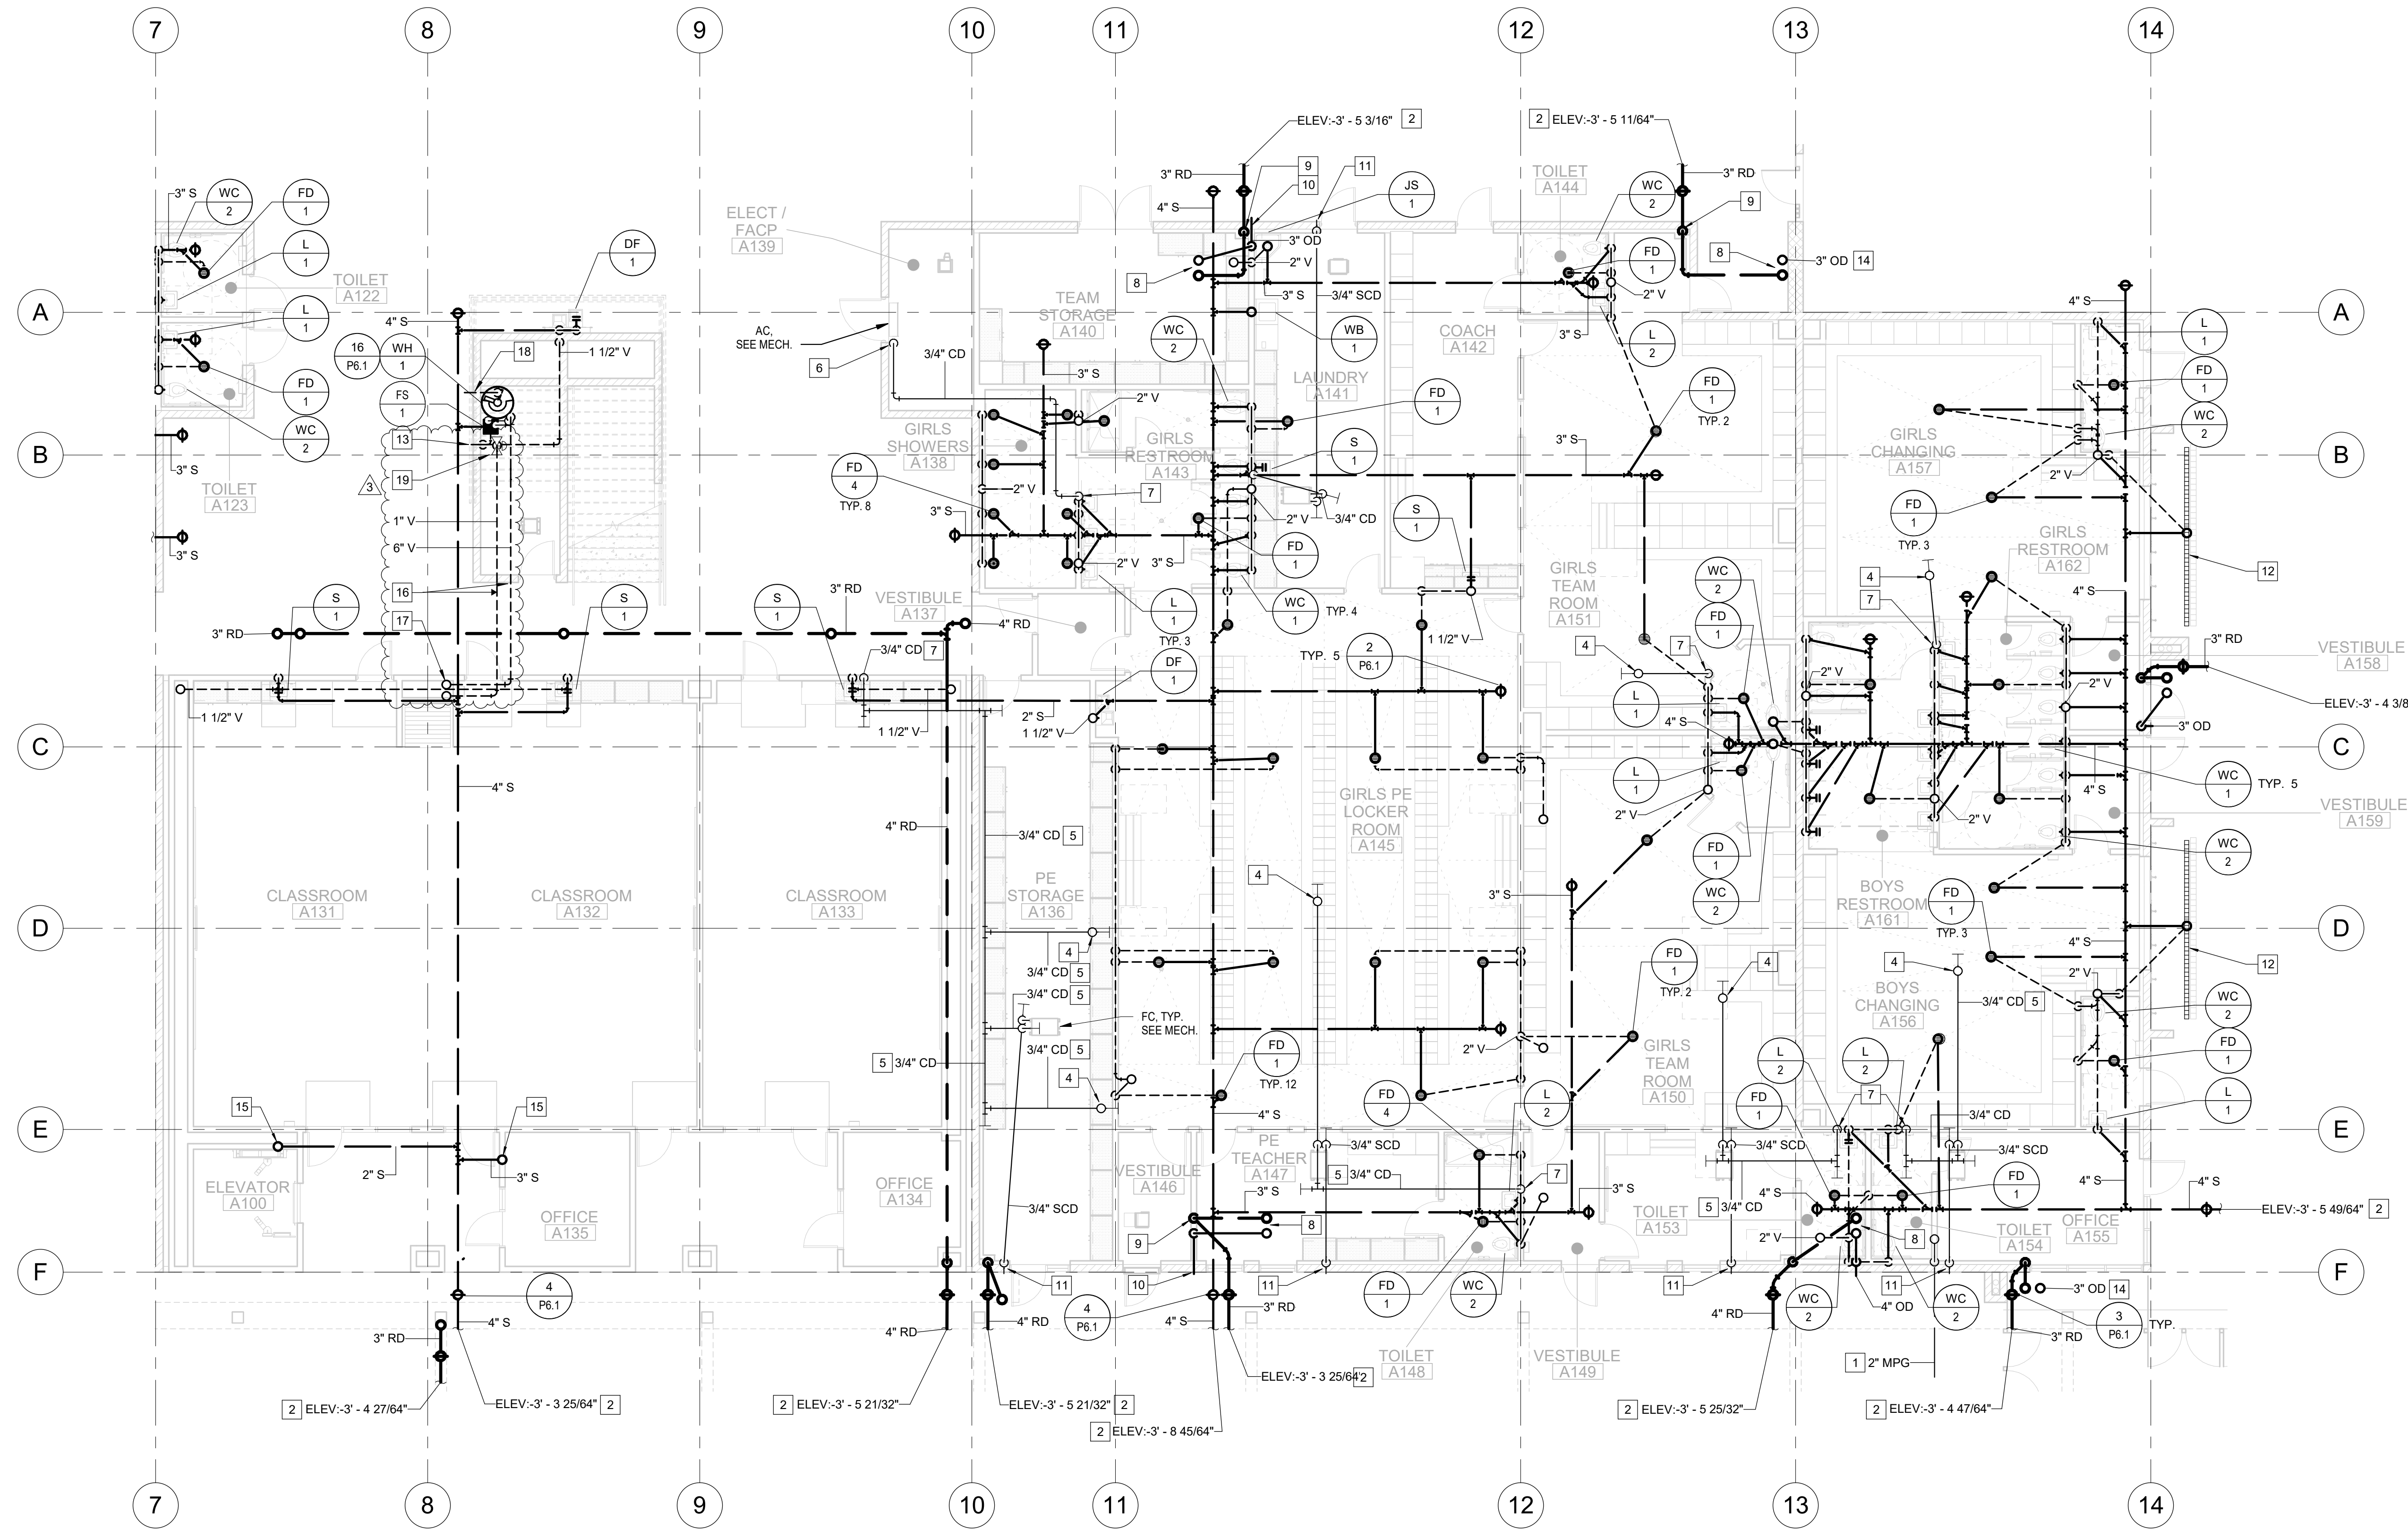


PLUMBING FIRST FLOOR PLAN - AREA B - WASTE AND VENT 1/8" = 1'-0" 1

KEYNOTES (CONT.):

19 ROUTE 1" VENT FROM GAS PRESSURE REGULATOR UP THRU ROOF. ROUTE ALONG SIDE THE WATER HEATER FLUE. TERMINATE VENT THRU ROOF PER DETAIL 6P6.2. LOCATE MINIMUM OF 10' AWAY FROM OUTSIDE AIR INTAKE OR 3'-0" ABOVE.

KEYNOTES:

- 1 MPG VENT FROM SLEEVED GAS LINE. SEE P1.1
- 2 CIVIL POINT OF CONNECTION 5' OUTSIDE OF BUILDING. SEE PLUMBING SITE PLAN P1.1 FOR CONTINUATION.
- 3 CLEARANCE NOT LESS THAN 18" IN FRONT OF CLEAN OUT.
- 4 3/4" CONDENSATE DROP THRU ROOF.
- 5 SLOPE PIPING 1/8" PER FOOT IN DIRECTION INDICATED.
- 6 ROUTE 3/4" CONDENSATE DRAIN FROM CONDENSATE PUMP UP TO ABOVE CEILING.
- 7 ROUTE 3/4" CONDENSATE DRAIN DOWN IN WALL. ELBOW OUT AND EXTEND TO TAILPIECE OF SINK/LAVATORY. SEE DETAIL 1P6.1
- 8 ROOF DRAIN AND OVERFLOW DRAIN RISERS THRU ROOF.
- 9 ROOF DRAIN DROP IN WALL TO BELOW SLAB. EXTEND BELOW GRADE WITH COTG. SEE CIVIL DRAWINGS FOR CONTINUATION.
- 10 DAYLIGHT OVERFLOW DRAIN LINE UP THRU EXTERIOR WALL AT 12" A.F.F. PROVIDE S.S. COVER ON OUTLET PER ARCH DRAWINGS.
- 11 DAYLIGHT 3/4" SECONDARY CONDENSATE DRAIN THRU EXTERIOR WALL.
- 12 TRENCH DRAIN. SEE POOL CONSULTANT DRAWINGS.
- 13 2" VENT THRU WALL MIN. 10' A.F.G.
- 14 DAYLIGHT OVERFLOW DRAIN THRU ROOF OVERHANG. TERMINATE 1-1/2' BEYOND FINISHED SURFACE. PROVIDE S.S. COVER ON OUTLET PER ARCH DRAWINGS.
- 15 SEWER DROP FROM ABOVE. SEE P2.5.1
- 16 METRAFLEX SEISMIC LOOP FOR GAS WATER HEATER FLUE PIPE.
- 17 6" WATER HEATER FLUE ROUTED UP IN CHASE THROUGH ROOF.
- 18 6" WATER HEATER INTAKE ROUTED UP THROUGH SIDEWALL.

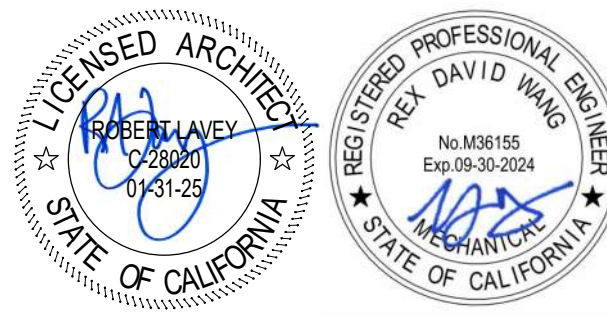

CONSULTANT
LEAF ENGINEERS
8163 Rochester Avenue, Suite 100
Rancho Cucamonga, CA 91730
909.987.0909
leafengineers.com

1	01/25/24	PBK	ADDENDUM 1
2	02/19/24	PBK	ADDENDUM 2
3	03/05/24	PBK	ADDENDUM 3

NO	DATE	BY	DESCRIPTION
REVISIONS			

DRAWN: Author CHECKED: Checker
DATE: 01/10/24 SCALE: 1/8" = 1'-0"
PROJECT NUMBER: 2110000

**PLUMBING 1ST FLR
PLN - AREA B -
WASTE AND VENT**

DRAWING NUMBER: **P2.3.1**





RANCHO CUCAMONGA
8163 Rochester Avenue, Suite 100
Rancho Cucamonga, CA 91730
909-987-0909 P

NOGALES HIGH SCHOOL & AQUATIC CENTER

CENTER

ROWLAND UNIFIED SCHOOL DISTRICT

401 NOGALES ST., LA PUENTE, CA 91744

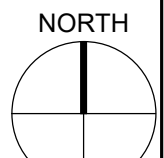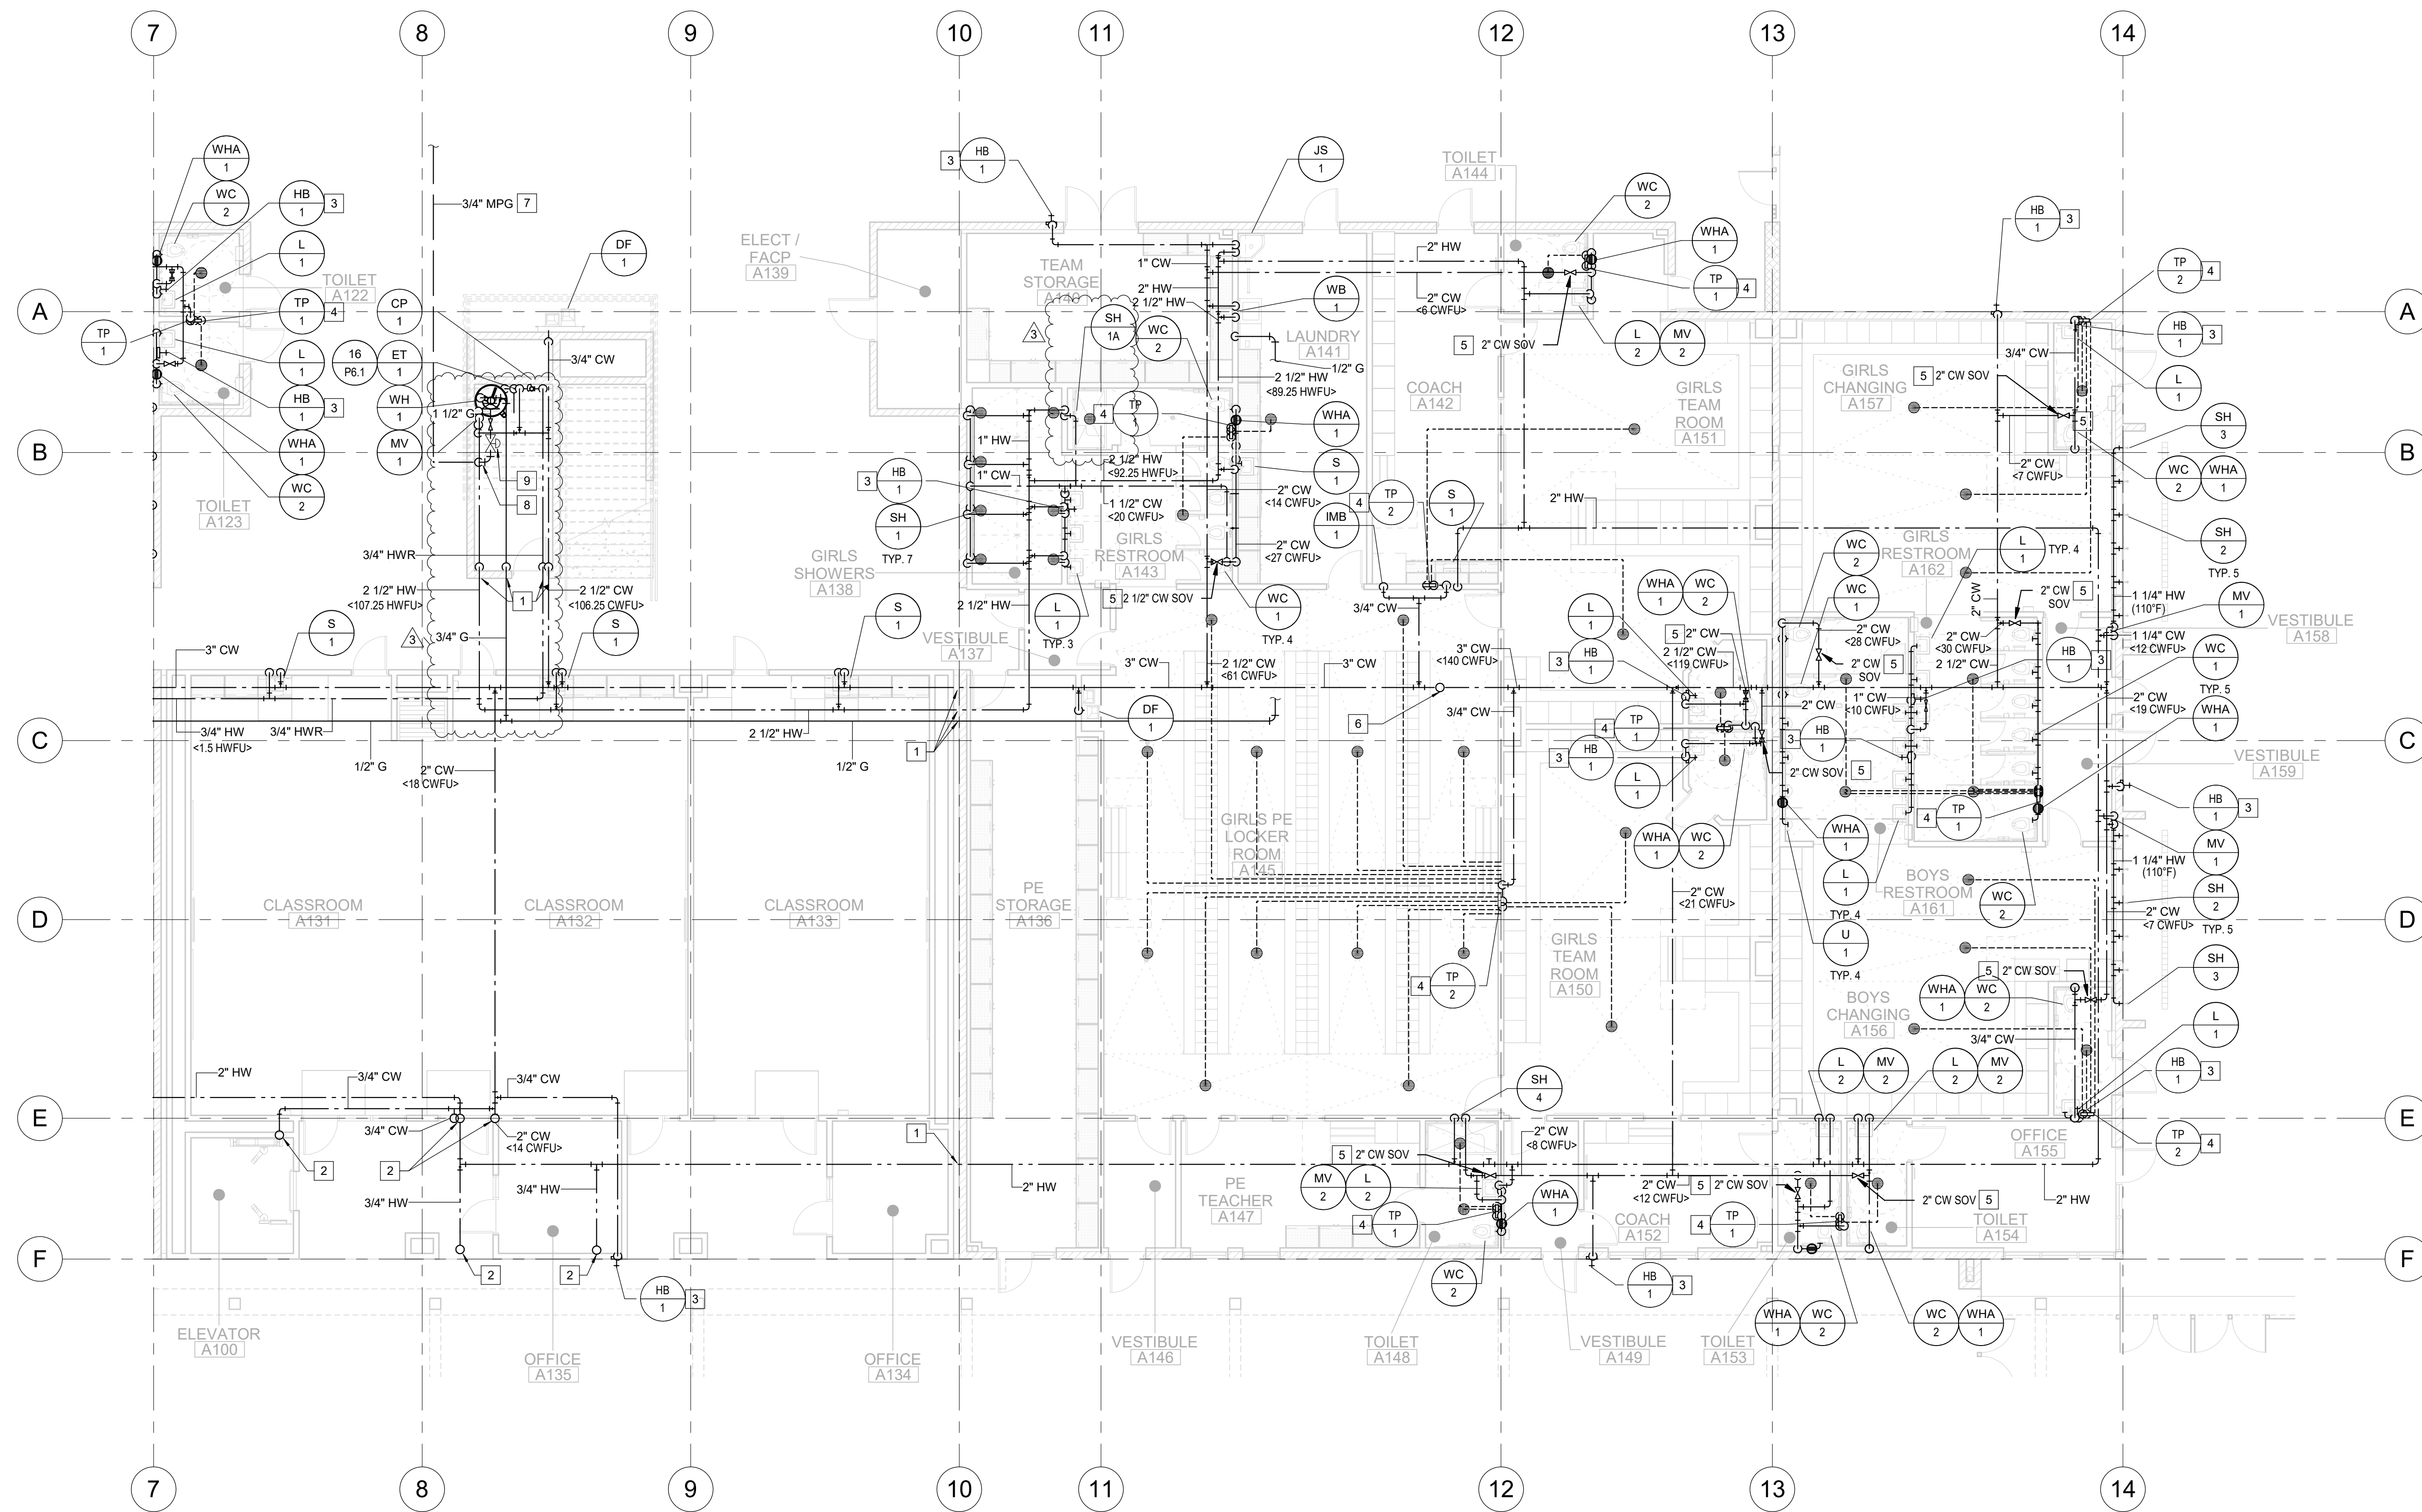


PLUMBING FIRST FLOOR PLAN - AREA B - WATER AND GAS

1/8" = 1'-0"

1

KEYNOTES:

- 1 PROVIDE METRIFLEX EXPANSION JOINTS FOR ALL PIPING CROSSING SEISMIC JOINTS. SEE DETAIL 9 ON SHEET P6.1
- 2 HOT/COLD WATER RISER, TYPICAL. SEE P2.3.2 FOR CONTINUATION.
- 3 MOUNT HOSE BIBB A MINIMUM OF 18" ABOVE FINISHED FLOOR/GRADE.
- 4 ROUTE 1/2" LINE BELOW GRADE FROM TP TO FLOOR DRAIN.
- 5 COLD WATER SHUT OFF VALVE ABOVE CEILING ACCESS PANEL.
- 6 ROUTE 3/4" COLD WATER UP THROUGH ROOF TO HOSE BIBB.
- 7 SEE SITE PLAN SHEET P1.1 FOR CONTINUATION OF GAS PIPE.
- 8 GAS PIPE RISER UP INSIDE STARWELL. CONNECT TO GAS PRESSURE REGULATOR AND SHUT OFF VALVE.
- 9 AMERICAN METER 1800C, 3/4" INLET AND 1-1/2" OUTLET WITH 3/16" ORIFICE GAS PRESSURE REGULATOR. REGULATE 5 PSI TO 7" WC PIPING IN BUILDING. 7" WC PIPE SIZED PER 2022 CPC TABLE 1215.2(1). TDL = 175'. TOTAL DEMAND = 345 MBH.

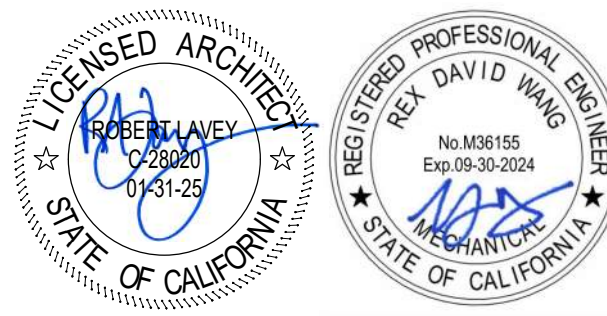

CONSULTANT
LEAF ENGINEERS
8163 Rochester Avenue, Suite 100
Rancho Cucamonga, CA 91730
909.987.0909
leafengineers.com

1	01/25/24	PBK	ADDENDUM 1
2	02/19/24	PBK	ADDENDUM 2
3	03/05/24	PBK	ADDENDUM 3


NO	DATE	BY	DESCRIPTION
REVISIONS			

DRAWN: Author CHECKED: Checker
DATE: 10/19/22 SCALE: 1/8" = 1'-0"
PROJECT NUMBER: 2110000


**PLUMBING 1ST FLR
PLN - AREA B -
WATER AND GAS**

DRAWING NUMBER: **P2.3.2**

202404_14_12.dwg
 C:\Users\mehmetkork\Desktop\2110000\NHS_P2_3.dwg - 2024/04/12 10:00:00 AM

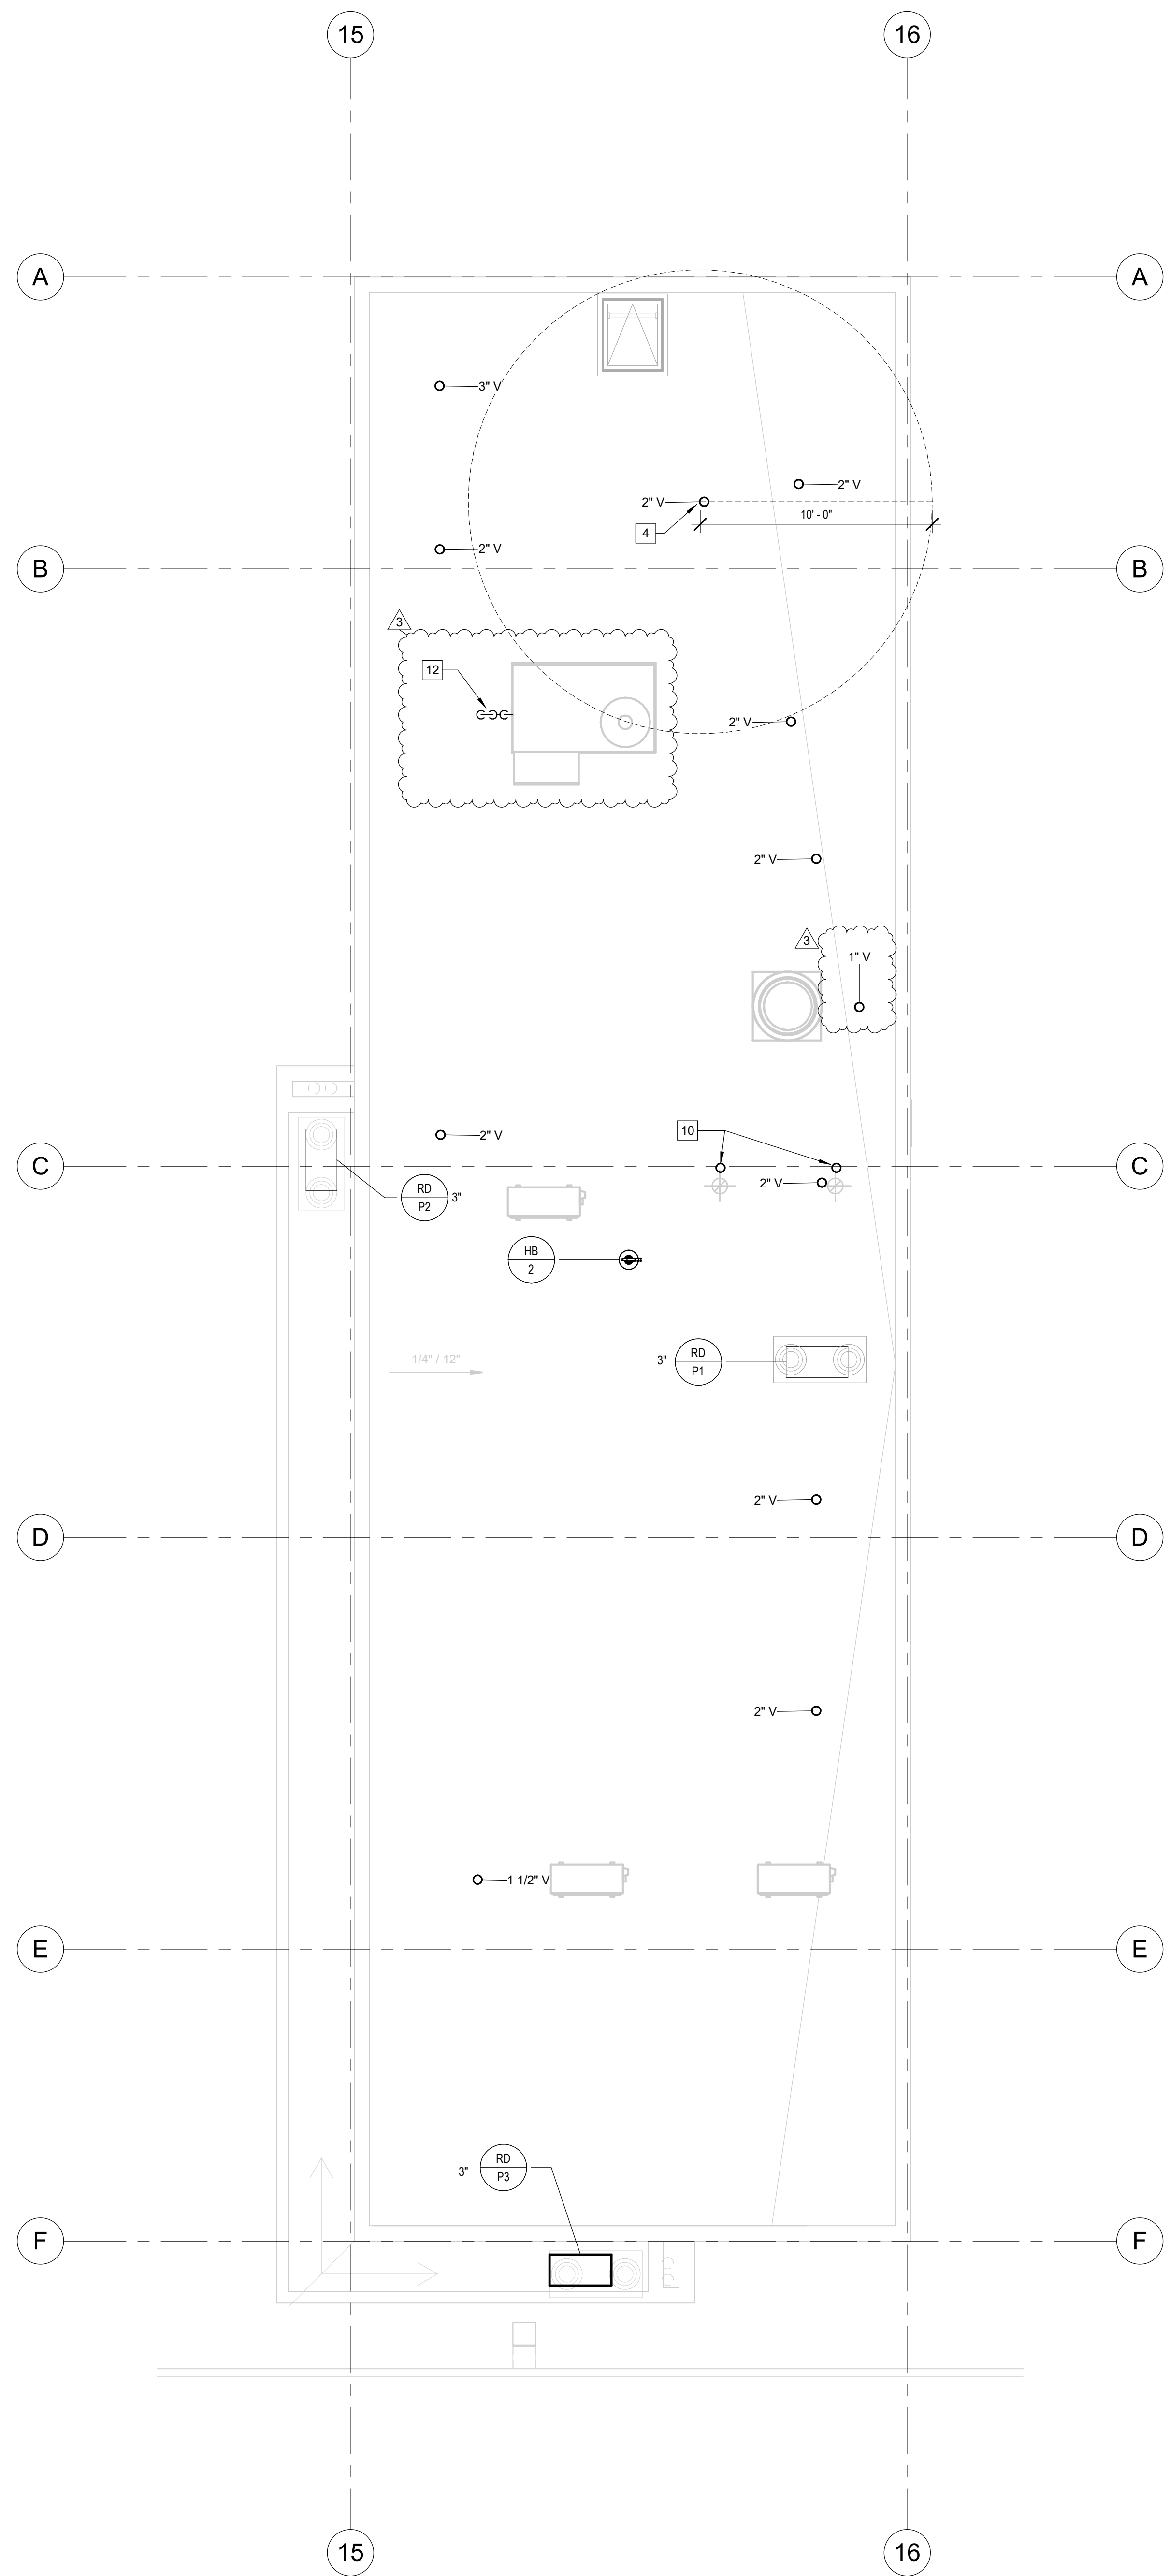

ENLARGED PLAN - POOL EQUIPMENT BUILDING ROOF PLAN 1/4" = 1'-0" 2

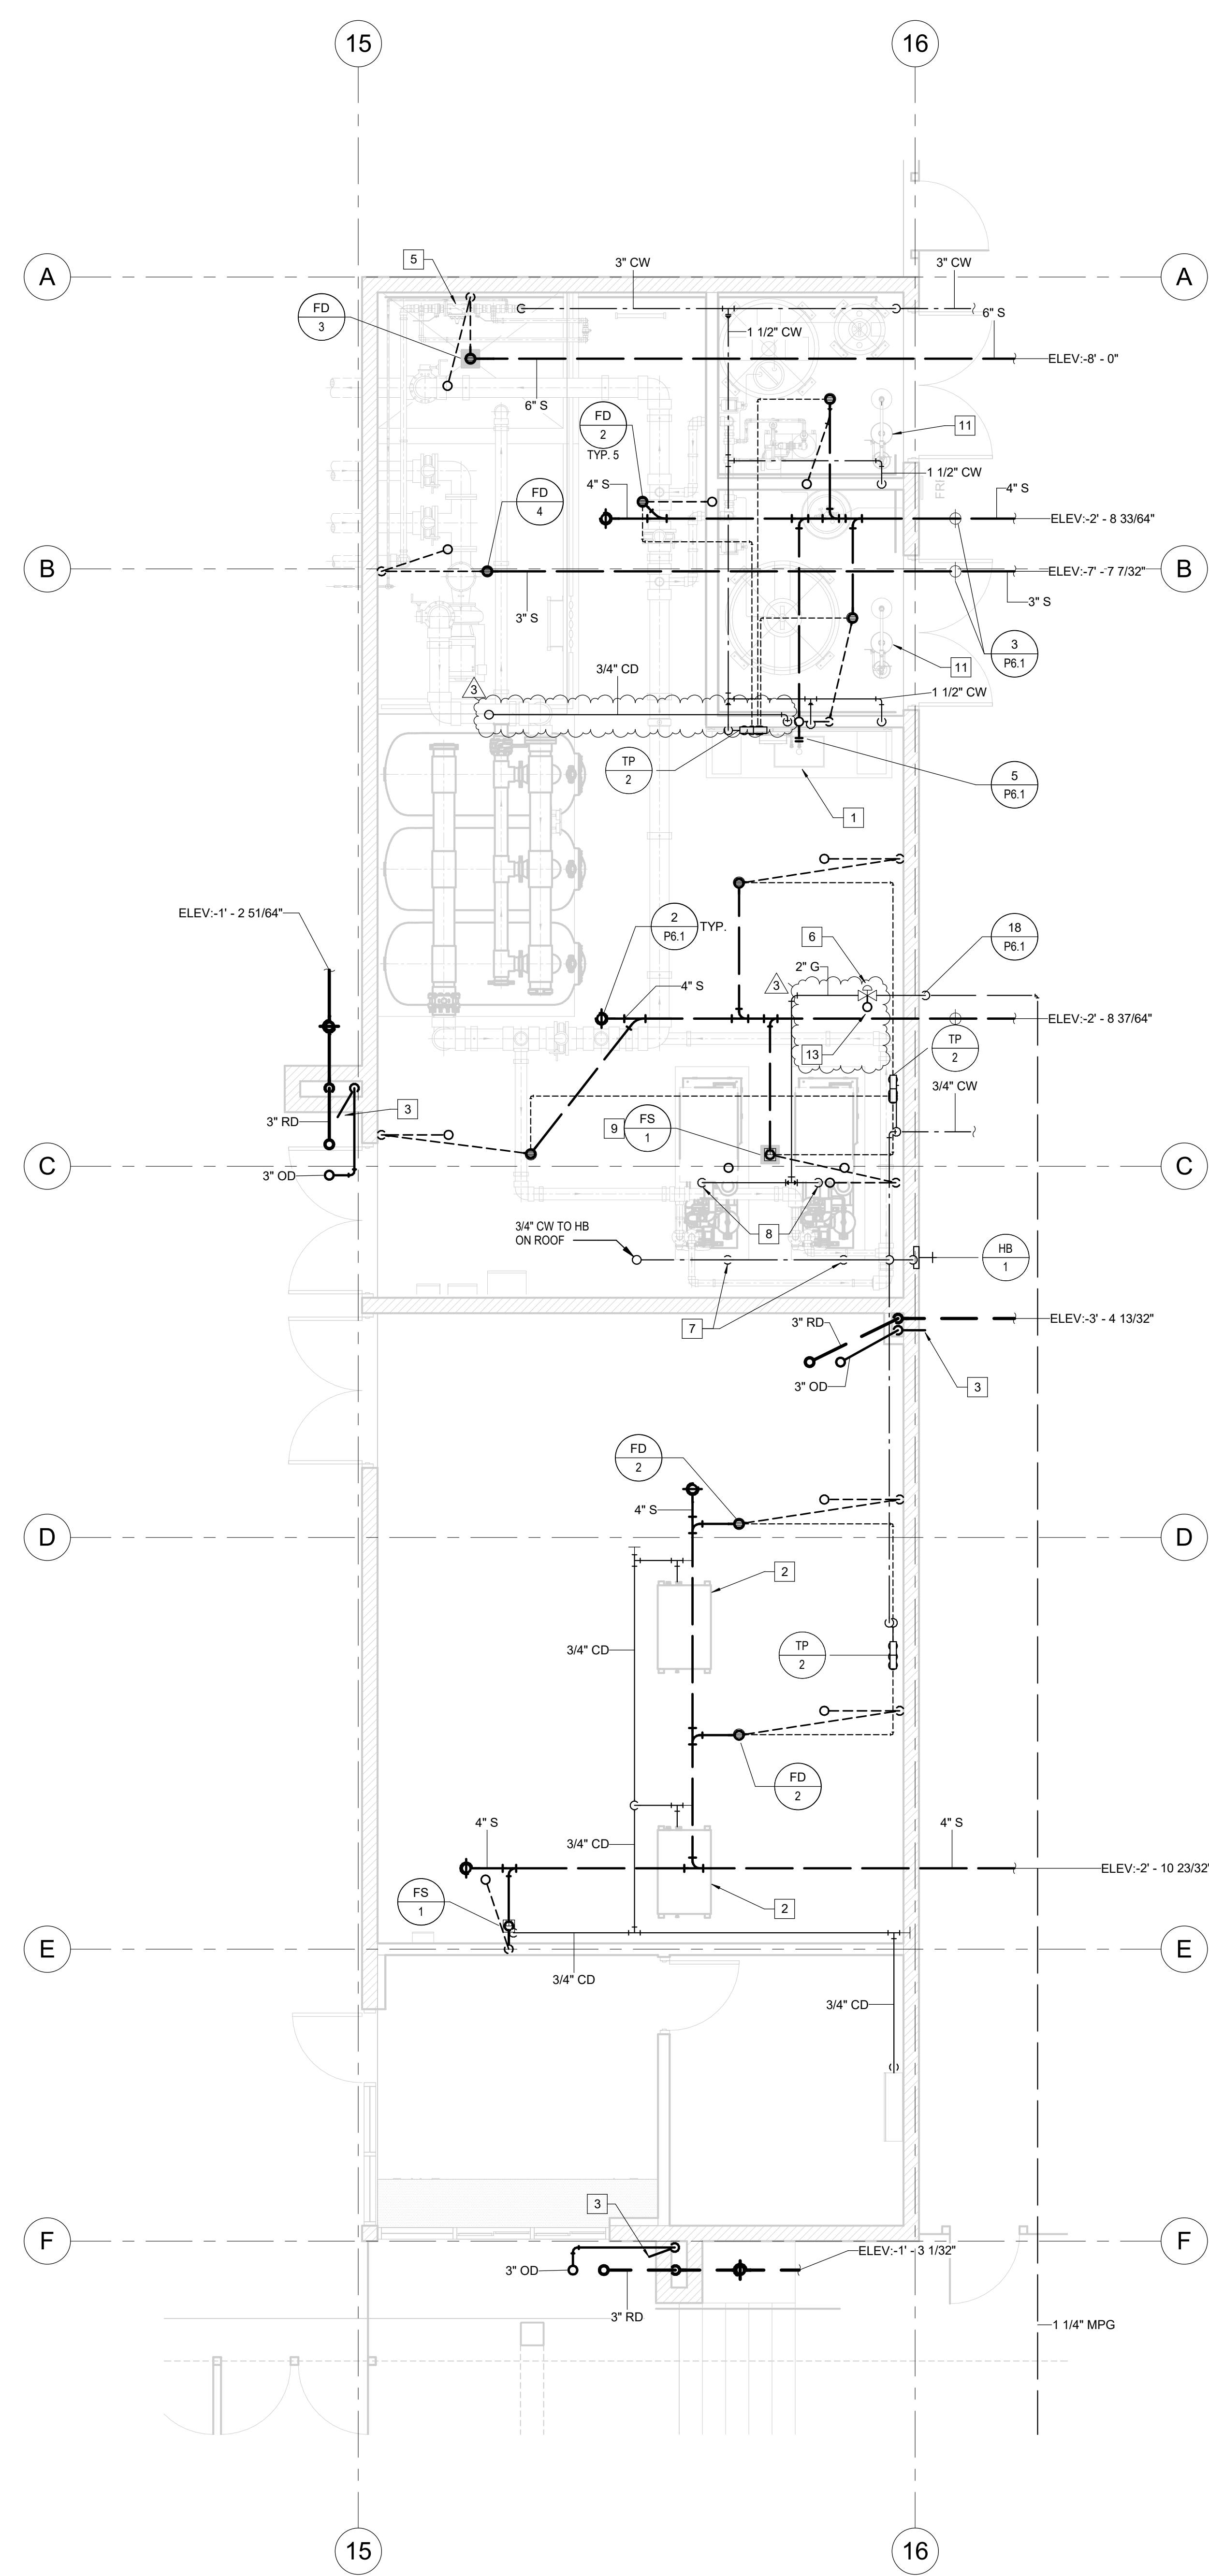

ENLARGED PLAN - POOL EQUIPMENT BUILDING FLOOR PLAN 1/4" = 1'-0" 1

KEY NOTES

- 1 POOL WORK STATION. SEE MR. 1 FOR SPECIFICATION.
- 2 MECH UNIT. SEE MECH DWGS. ROUTE CONDENSATE TO FLOOR SINK.
- 3 TERMINATE OVERFLOW DRAIN 12" ABOVE GRADE.
- 4 ROUTE VENT THROUGH ROOF MIN. 10'-0" AWAY FROM OUTSIDE AIR INTAKE OR 3'-0" ABOVE TYPICAL.
- 5 BACKFLOW PROVIDED BY POOL CONSULTANT. SEE SHEET MR.1.
- 6 AMERICAN METER, 1800C, 1-1/4" INLET AND 2" OUTLET WITH 1/2" ORIFICE GAS PRESSURE REGULATOR. REGULATE 5 PSI TO 7" WC PIPING IN BUILDING. 7" WC PIPE SIZED PER 2022 CPC TABLE 12.15.2(1). TDL = 20'. TOTAL DEMAND = 2,500 MBH.
- 7 3/4" COLD WATER TO EACH SWIMMING POOL HEATER.
- 8 1-1/2" NATURAL GAS TO EACH SWIMMING POOL HEATER.
- 9 DISCHARGE FULL-SIZED CONDENSATE DRAIN FROM SWIMMING POOL HEATER TO FLOOR SINK. ELBOW DOWN TERMINATE WITH 1" MINIMUM AIR GAP ABOVE FLOOD RIM OF FLOOR SINK.
- 10 POOL WATER HEATER FLUE.
- 11 EYEWASH/SHOWER PROVIDED BY POOL CONSULTANT. SEE SHEET MR.1.
- 12 CONDENSATE ROUTED BELOW ROOF TO SINK TAILPIECE. SEE 1/P3.1 FOR CONTINUATION. SEE 15/P6.1 FOR TRAP INSTALLATION.
- 13 1" VENT FROM GAS PRESSURE REGULATOR UP THRU ROOF. TERMINATE VENT THRU ROOF PER 6/P6.2. LOCATE MINIMUM OF 10' AWAY FROM OUTSIDE AIR INTAKE OR 3'-0" ABOVE.

ROOF DRAIN SIZING CALCULATION

ROOF DRAIN	ROOF AREA COVERED	MAX AREA ALLOWED	SIZE
RD-P1	1889	2320	3"
RD-P2	133	2320	3"
RD-P3	38	2320	3"



RANCHO CUCAMONGA
8163 Rochester Avenue, Suite 100
Rancho Cucamonga, CA 91730
909-987-0909 P

NOGALES HIGH SCHOOL & AQUATIC CENTER
 ROWLAND UNIFIED SCHOOL DISTRICT
 401 NOGALES ST., LA PUENTE, CA 91744



CONSULTANT
LEAF ENGINEERS
 8163 Rochester Avenue, Suite 100
 Rancho Cucamonga, CA 91730
 909.987.0909
 leafengineers.com

1	01/25/24	PBK	ADDENDUM 1
2	02/19/24	PBK	ADDENDUM 2
3	03/05/24	PBK	ADDENDUM 3

NO	DATE	BY	DESCRIPTION
REVISIONS			

DRAWN: Author CHECKED: Checker
 DATE: 05/12/23 SCALE: 1/4" = 1'-0"
 PROJECT NUMBER: 2110000

ENLARGED PLUMBING PLANS

DRAWING NUMBER: **P3.1**

2024.05.14.15.17 PM
 C:\Users\james\OneDrive\Documents\2110000\NHB_P31_Drains_2024.mxd

WATER HEATER SCHEDULE																
UNIT	MANUFACTURER & MODEL NO.	LOCATION	SERVICE	TYPE	TANK SIZE (GAL)	FUEL	INPUT CAPACITY (MBH)	RECOVERY RATE @80°F (GPH)	INLET TEMP. °F	OUTLET TEMP. °F	ELECTRICAL				OPER. WT.(LBS)	REMARKS
											VOLTS	PHASE	HERTZ	FLA		
WH 1	A.O. SMITH CYCLONE (MI MODEL BTH-300(A))	FIRE RISER A178	DOM. HOT WATER	TANK	120	GAS	300	436	60	140	460	3	60	43.3	1850	PROVIDE CONCENTRIC VENT KIT. SEE DETAIL 16 ON SHEET P6.1 FOR ANCHORAGE.

CIRCULATOR PUMP SCHEDULE												
NO.	MANUFACTURER & MODEL NO.	LOCATION	SERVICE	TYPE	EFFICIENCY	FLOW RATE (GPM)	TDH	WATTS	RPM	VOL/PH/Hz	OPERATING WT.(LBS.)	REMARKS
CP 1	BELL & GOSSETT MODEL NFB-45	FIRE RISER A178	DOM. HOT WATER	VERTICAL, IN-LINE	-	10	20	270	3300	115/1/60	14.5	PROVIDE AQUA STAT TO START AT 120 DEGREES AND STOP AT 140 DEGREES. SEE DETAIL 16 ON SHEET P6.1 FOR ANCHORAGE.

EXPANSION TANK SCHEDULE									
NO.	MANUFACTURER & MODEL NO.	LOCATION	SERVICE	QUANTITY	TOTAL VOL.(GAL)	HEIGHT	DIAMETER	OPERATING WT.(LBS.)	REMARKS
ET 1	AMTROL INC THERM-X-TROL MODEL ST-12C-DD	FIRE RISER A178	DOM. HOT WATER	1	6.4	18"	12"	26	SEE DETAIL 16 ON SHEET P6.1 FOR ANCHORAGE.

THERMOSTATIC MIXING VALVE SCHEDULE						
NO.	MANUFACTURER & MODEL NO.	LOCATION	SERVICE	SIZE (INCH)	PRESSURE DROP (PSI)	REMARKS
MV 1	LEONARD MODEL LV-985-SW-LF	FIRE RISER A178	DOM. HOT WATER	2" INLETS, 2" OUTLET	5	SERVICE: PLUMBING FIXTURES. SINGLE VALVE, MIN. FLOW RATE 10 GPM. MAX. 216 GPM. LEAD FREE MIXING VALVE, PRESSURE GAUGE, SET TO DELIVER 120°F HW. PROVIDE REDUCER & INCREASE FITTING AS REQUIRED. SEE DETAIL 16 ON SHEET P6.1 FOR ANCHORAGE.

WASTE AND VENT SIZING TABLE				
WASTE SIZING (HORIZONTAL PIPING)			VENT SIZING (HORIZONTAL & VERTICAL PIPING)	
PIPE SIZE	FU	PIPE SIZE	FU	MAX. LENGTH (FT.)
1 1/2"	1	1 1/2"	8	60
2"	8	2"	24	120
2 1/2"	14	2 1/2"	48	180
3"	35	3"	81	212
4"	216	4"	256	300
5"	428	5"	600	390
6"	720	6"	1380	510

WASTE & WATER FIXTURE UNITS					
FIXTURE	WASTE			WATER	
	QUANTITY	FIXTURE UNITS	TOTAL	FIXTURE UNITS	TOTAL
WASTE CLOSET - FLUSH TANK	-	3.0	-	3.0	-
WATER CLOSET - FLUSH VALVE	34	4.0	136	5.0	170
URINAL - FLUSH VALVE	6	2.0	12	4	24
LAVATORY	33	1.0	33	1.0	33
FLOOR DRAIN	81	2.0	162	-	-
FLOOR SINK	2	3.0	6	-	-
SHOWER	31	2.0	62	2.0	62
SINK	12	3.0	36	2.0	24
DOM. UNIT/ CLOTHES WASHER	2	3.0	6	4.0	8
HOSE BIBB	31	-	-	1.0	31
BATH TUB	2	2.0	4	4.0	8
DRINKING FOUNTAIN	6	0.5	3	0.5	3
SERVICE SINK	2	3.0	6	3.0	6
TOTAL			466		369
				GPM	112

WATER CALCULATIONS		
BUILDING FIXTURE UNITS	369	= 121 GPM
BUILDING EXTERNAL PRESSURE LOSS		
MAX. 75 PSI		
- WATER METER	4	PSI
- BACK FLOW PREVENTER	11	PSI
- PRESSURE REDUCING VALVE	-	PSI
PRESSURE AVAILABLE AT BUILDING ENTRANCE	60	PSI
BUILDING INTERNAL PRESSURE LOSS		
BUILDING STATIC PRESSURE HEIGHT	34	HEIGHT X 0.434 = 14.80 PSI
PRESSURE REQUIRED AT FIXTURE:		
FLUSH VALVE:	25	PSI
FLUSH TANK:	8	PSI
BUILDING TOTAL LOSS:	40	PSI
AVAILABLE PRESSURE FOR FRICTION LOSS		
TOTAL LENGTH 1250 FT X F 1.2 = TOTAL EQUIVALENT LENGTH (T.E.L.) 1500 FT		
MAX ALLOWABLE FRICTION LOSS PER 100 FT : 1.93		
USE 1.80 PSI LOSS PER 100 FT		

WATER HAMMER ARRESTER SIZING/SELECTION TABLE		
WHA SIZE	FIXTURE UNITS	CROSS REF PDI STANDARD
1/2"	1 - 11	A
3/4"	12 - 32	B
1"	33 - 60	C
1 1/4"	61 - 113	D
1 1/2"	114 - 154	E
2"	155 - 330	F

NATURAL GAS PIPE SIZING SCHEDULE (8" W.C.)									
GAS LOADS: 300 CFH, TDL = 350'									
PIPE SIZE	1/2"	3/4"	1"	1 1/4"	1 1/2"	2"	2 1/2"	3"	4"
CFH @ 350'	25	52	99	204	307	591	943	1668	3404


PLUMBING FIXTURE SCHEDULE						
MARK	FIXTURE	S or W	V	CW	HW	DESCRIPTION
SH 1A	SHOWER HEAD (ACCESS. INTERIOR)	FD	-	3/4"	3/4"	SHOWER STALL, FOLD DOWN SEAT AND GRAB BARS DESIGNED BY ARCHITECT. PLUMBING CONTRACTOR TO PROVIDE ACORN S38ADA-PBH-HL-QD-PSO ZENITH BUILT-IN SHOWERS, FLANGED SHOWERHEAD, HAND-SHOWER ASSEMBLY WITH FLEX HOSE HAND-HELD SHOWER HEAD, WITH 24" STAINLESS STEEL ADA GRAB BAR, DIVERTER VALVE, AIR-CONTROL, SINGLE TEMPERATURE METERING VALVE, BRADLEY S59-4016 MIXING VALVE FOR HOT & COLD INLET. SET OUTLET TEMPERED WATER TO 108 DEG F. CBC ACCESS COMPLIANT. 1.6 GPM.

PLUMBING FIXTURE SCHEDULE						
MARK	FIXTURE	S or W	V	CW	HW	DESCRIPTION
WC 1	WATER CLOSET	3"	2"	1-1/2"	-	KOHLER "HIGHCLIFF" NO. K-9607 ELONGATED FLOOR MOUNTED WATER CLOSET, 1.28 GPF, VITREOUS CHINA (ADA), ELONGATED BOWL, SIPHON JET WITH KOHLER "WAVE" K-10673-SV 1.28 GPF EXPOSED BATTERY-POWERED SENSOR FLUSH VALVE. PROVIDE KOHLER K-4731-SC ELONGATED TOILET SEAT.
WC 2	WATER CLOSET (ACCESS.)	3"	2"	1-1/2"	-	KOHLER "HIGHCLIFF" NO. K-9607 ELONGATED FLOOR MOUNTED WATER CLOSET, 1.28 GPF, VITREOUS CHINA (ADA), ELONGATED BOWL, SIPHON JET WITH KOHLER "WAVE" K-10673-SV 1.28 GPF EXPOSED BATTERY-POWERED SENSOR FLUSH VALVE. PROVIDE KOHLER K-4731-SC ELONGATED TOILET SEAT. CBC COMPLIANT FOR ACCESS.
L 1	LAVATORY (ACCESS.)	2"	1-1/2"	1/2"	-	AMERICAN STANDARD NO. 0355.012, WALL-HUNG, 20"x18" VITREOUS CHINA WITH BACKSPASH & WALL BRACKET, 3 MOUNTING HOLES FOR CHICAGO FAUCETS NO. EVR-A12A-11ABCP SENSOR FAUCET, ADJUSTED TO STAY OPEN 10 SECONDS WITH (0.5 GPM) FLOW RESTRICTOR, PERFORATED GRID DRAIN, P-TRAP, SPEED CONTROL COMPRESSION WALL STOP & SUPPLY TUBING, JAY R SMITH SERIES 0700 CARRIER, SEE ARCH. SHEETS FOR MOUNTING HEIGHT, CBC COMPLIANT FOR ACCESS. SEE DETAIL 14/P6.1 FOR MOUNTING DETAIL.
L 2	LAVATORY (ACCESS.)	2"	1-1/2"	1/2"	1/2"	AMERICAN STANDARD NO. 0355.012, WALL-HUNG, 20"x18" VITREOUS CHINA WITH BACKSPASH & WALL BRACKET, 3 MOUNTING HOLES FOR CHICAGO FAUCETS NO. 2200-4E39VABCP LEVER HANDLE FAUCET WITH (0.35 GPM) FLOW RESTRICTOR, PERFORATED GRID DRAIN, P-TRAP, SPEEDWAY COMPRESSION WALL STOP AND SUPPLY TUBING, SEE ARCH. SHEETS FOR MOUNTING HEIGHT. CBC COMPLIANT FOR ACCESS. SEE DETAIL 14/P6.1 FOR MOUNTING DETAIL.
U 1	URINAL (ACCESS.)	2"	2"	3/4"	-	KOHLER "BARDON" NO. K-4891-ERSS WALL-HUNG URINAL, 0.125 GPF, VITREOUS CHINA (ADA) WITH KOHLER "WAVE" K-10668-SV 0.125 GPF EXPOSED BATTERY-POWERED SENSOR FLUSH VALVE. PROVIDE JR. SMITH #0000 SERIES URINAL SUPPORTS. PROVIDE WALL CLEANOUTS ABOVE EACH URINAL. SEE DETAIL 13/P6.1 FOR MOUNTING DETAIL.
S 1	SINK (ACCESS.)	2"	1-1/2"	1/2"	1/2"	ELKAY NO. LRAD131655 SINGLE BOWL DROP-IN ADA SINK, 13"X18"X1-1/2" 18 GAUGE 304 STAINLESS STEEL BOWL WITH CENTER DRAIN, 3 MOUNTING HOLES FOR CHICAGO FAUCETS NO. 526-317ABCP DECK MOUNTED MANUAL SINK FAUCET WITH 4" FIXED CENTERS.
SH 1	SHOWER HEAD	FD	-	3/4"	3/4"	SHOWER STALL DESIGN BY ARCHITECT. PLUMBING CONTRACTOR TO PROVIDE ACORN S36-MV, ZENITH BUILT-IN SHOWERS, FLANGED SHOWERHEAD, AIR-CONTROL, SINGLE TEMPERATURE METERING VALVE, BRADLEY S59-4016 MIXING VALVE FOR HOT & COLD INLET, SET OUTLET TEMPERED WATER TO 108 DEG F. 1.6 GPM.
SH 2	SHOWER HEAD (EXTERIOR)	FD	-	1/2"	1/2"	ACORN 4108-W SHOWER-WARE WALL MOUNTED 18 GAGE TYPE 304 STAINLESS STEEL SHOWER PANEL, SINGLE TEMP 1.6 GPM SHOWER WITH ON/OFF PUSHBUTTON.
SH 3	SHOWER HEAD (ACCESS. EXTERIOR)	FD	-	1/2"	1/2"	ACORN 4108ADA-W SHOWER-WARE WALL MOUNTED 18 GAGE TYPE 304 STAINLESS STEEL SHOWER PANEL WITH ADA COMPLIANT CONTROL VALVE, HANDHELD SHOWER WITH ON/OFF PUSHBUTTON, 60" HOSE, QUICK-DISCONNECT AND SINGLE TEMP 1.6 GPM FLOW CONTROL, PROVIDE PADDED SEAT WHERE SHOWN ON PLANS.
SH 4	SHOWER HEAD (ACCESS. INTERIOR)	FD	-	3/4"	3/4"	SHOWER STALL, FOLD DOWN SEAT AND GRAB BARS, DESIGNED BY ARCHITECT. PLUMBING CONTRACTOR TO PROVIDE ACORN S38ADA-PBH-HL-QD-PSO ZENITH BUILT-IN SHOWERS, FLANGED SHOWERHEAD, HAND-SHOWER ASSEMBLY WITH FLEX HOSE HAND-HELD SHOWER HEAD, WITH 24" STAINLESS STEEL ADA GRAB BAR, DIVERTER VALVE, TEMPERATURE, PRESSURE BALANCING MIXING VALVE, SET OUTLET TEMPERED WATER TO 108 DEG F. CBC ACCESS COMPLIANT. 1.6 GPM.
MV 1	MIXING VALVE	-	-	2"	2"	BRADLEY LW-985-SW-LF THERMOSTATIC WATER MIXING VALVE, INTEGRAL COMBINATION CHECKSTOPS WITH STRAINERS AND WALL SUPPORT, ADJUSTABLE SET POINT TEMPERATURE CONTROL, SET OUTLET TEMPERATURE AT 120°F, 10.0 GPM MINIMUM FLOW.
MV 2	MIXING VALVE	-	-	1/2"	1/2"	BRADLEY S59-4000 POINT OF USE MIXING VALVE, IN-LINE CHECK VALVES, ADJUSTABLE SET POINT TEMPERATURE CONTROL, SET OUTLET TEMPERATURE AT 110°F, 0.35 GPM MINIMUM FLOW.
WHA 1	WATER HAMMER ARRESTOR	-	-	VARIES	-	ZURN NO. Z1700 SHOKTROL WATER HAMMER ARRESTOR, STAINLESS STEEL CONSTRUCTION, WATER CONNECTION DEPENDS ON FIXTURE CAPACITY
RD XY	ROOF/OVERFLOW DRAIN	SEE PLANS	-	-	-	WATTS DRAINAGE RD-250 COMBINATION ROOF DRAIN/OVERFLOW WITH EPOXY COATED CAST IRON DRAIN BODIES, FLASHING CLAMPS WITH INTEGRAL GRAVEL GUARDS, 4" HIGH INTERNAL STANDPIPE, SELF-LOCKING POLYETHYLENE DOMES AND NO HUB OUTLET. X = BLDG NO., Y = RD NO.
JS 1	JANITOR SINK	3"	2"	3/4"	3/4"	FLORESTONE NO. MSR-2424 24"X24" MOLDED ONE-PIECE MOP RECEPTOR WITH CHICAGO FAUCETS NO. 445-VBRRCF WALL-MOUNTED MANUAL SINK FAUCET, VANDAL-PROOF RIGID SPOUT WITH VACUUM BREAKER.
HB 1	HOSE BIBB	-	-	3/4"	-	WOODFORD B24P-3/4, BRASS FAUCET, SHIELDED LOOSE KEY HANDLE, NON REMOVABLE VACUUM BREAKER, ROUGH CHROME FINISH FOR OUTDOORS; POLISHED CHROME INDOORS.
HB 2	HOSE BIBB	-	-	3/4"	-	WOODFORD Y24 AT STAND PIPES, BRASS FAUCET, SHIELDED LOOSE KEY HANDLE, NON REMOVABLE VACUUM BREAKER & ROUGH CHROME FINISH FOR OUTDOORS.
FD 1	FLOOR DRAIN	2"	1-1/2"	TP	-	ZURN NO. ZN415-2NH-58-P CAST IRON BODY, COMPLETE WITH 6" ROUND NICKEL-BRONZE TOP, CLAMPING COLLAR, 1/2" TRAP PRIMER CONNECTION AND P-TRAP. SEE DETAIL 8/P6.1 FOR MOUNTING DETAIL.
FD 2	FLOOR DRAIN	3"	2"	TP	-	ZURN NO. ZN415-3NH-68-AR-P CAST IRON BODY, COMPLETE WITH 6" ROUND NICKEL-BRONZE TOP, CLAMPING COLLAR, 1/2" TRAP PRIMER CONNECTION AND P-TRAP. SEE DETAIL 8/P6.1 FOR MOUNTING DETAIL.
FD 3	FLOOR DRAIN	6"	3"	-	-	ZURN NO. ZN415-6IP-108 CAST IRON BODY, COMPLETE WITH 8" ROUND NICKEL-BRONZE TOP, CLAMPING COLLAR, P-TRAP. SEE DETAIL 8/P6.1 FOR MOUNTING DETAIL.
FD 4	FLOOR DRAIN	2"	1-1/2"	-	-	ZURN NO. ZN415-3NH-68-AR-P CAST IRON BODY, COMPLETE WITH 6" ROUND NICKEL-BRONZE TOP, CLAMPING COLLAR, P-TRAP. SEE DETAIL 8/P6.1 FOR MOUNTING DETAIL.
AD 1	AREA DRAIN	3"	-	-	-	ZURN NO. ZN611 CAST IRON BODY, COMPLETE WITH HEAVY DUTY 9" ROUND NICKEL-BRONZE TOP, CLAMPING COLLAR, P-TRAP. SEE DETAIL 8/P6.1 FOR MOUNTING DETAIL. CONNECT TO STORM DRAIN.
DF 1	DRINKING FOUNTAIN (ACCESS.)	2"	1-1/2"	1/2"	-	HAWS 1119-14(BP32)1920R489 WALL-HUNG 14 GA. STAINLESS STEEL, VANDAL RESISTANT, HIGH-LOW DRINKING FOUNTAIN WITH PUSH BUTTON BOTTLE FILLER, BACK PANEL AND DROP TRAY. SEE ARCH. SHEETS FOR MOUNTING HEIGHT. CBC COMPLIANT.
BT 1	BATH TUB	FS	-	3/4"	3/4"	FERNO IIE MODEL 306 WHIRLPOOL TUB, 18 GA STAINLESS STEEL, 36 GALLON TUB, 5 FOOT FILL HOSE, INTEGRAL PUMP AND MOTOR, DRAIN TO FLOOR SINK.
WB 1	WASHING MACHINE BOX	2"	1-1/2"	3/4"	3/4"	SPECIALTY PRODUCTS #08501 RECESSED METAL WASHING MACHINE OUTLET BOX WITH COPPER SWEAT VALVES AND LEFT OR RIGHT OUTLET.
IMB 1	ICE MAKER BOX	-	-	1/2"	-	SPECIALTY PRODUCTS #08504-LL RECESSED METAL WATER SUPPLY BOX WITH COPPER SWEAT VALVES.
IMB 2	ICE MAKER BOX	-	-	3/4"	-	SPECIALTY PRODUCTS #08504-LL RECESSED METAL WATER SUPPLY BOX WITH COPPER SWEAT VALVES.
TP 1	TRAP PRIMER	-	-	1/2"	-	MIFAB #MR-500-NPB PRESSURE ACTIVATED TRAP PRIMER VALVE, BRASS BODY, ADJUSTABLE, COMPLETE WITH 1/2" COPPER TYPE 1/1" PIPE TO RECEPTOR, INSTALL PER MANUFACTURER'S RECOMMENDATIONS, COMPLETE BEHIND ACCESS PANEL. SEE DETAIL 12/P6.1 FOR MOUNTING DETAIL, UP TO 6 DRAINS. SEE PLANS FOR NUMBER OF DRAINS. SEE DETAIL 12/P6.1 FOR MOUNTING DETAIL.
TP 2	TRAP PRIMER	-	-	3/4"	-	MIFAB #M-100 ELECTRONIC TRAP PRIMER VALVE, COMPLETE WITH 1/2" COPPER TYPE 1/1" PIPE TO RECEPTOR, INSTALL PER MANUFACTURER'S RECOMMENDATIONS, COMPLETE BEHIND ACCESS PANEL. SEE DETAIL 12/P6.1 FOR MOUNTING DETAIL, UP TO 30 DRAINS. SEE PLANS FOR NUMBER OF DRAINS. COORDINATE WITH ELECTRICAL FOR VOLTAGE.
FS 1	FLOOR SINK	2"	1-1/2"	TP	-	ZURN NO. ZN-1900-KC-32 COATED CAST IRON WITH ACID RESISTANT PAINTED INTERIOR, 12" SQUARE TOP, 6" DEEP, DOUBLE DRAINAGE, NO HUB OUTLET AND DOME STRAINER, 1/2" GRATE.

NOTES:
 1. ALL PLUMBING FIXTURES, FLUSH VALVES, FAUCETS, FLOOR DRAINS, FLOOR SINKS, DRINKING FOUNTAINS, ETC. SHALL BE VANDAL RESISTANT.
 2. ALL PLUMBING FIXTURES SHALL COMPLY WITH CAL GREEN FLOW RATES FOR 20 PERCENT FLOW RATE REDUCTION PER TABLE S.303.2.3.

PBK
 RANCHO CUCAMONGA
 8163 Rochester Avenue, Suite 100
 Rancho Cucamonga, CA 91730
 909-987-0909 P

NOGALES HIGH SCHOOL & AQUATIC CENTER
 ROWLAND UNIFIED SCHOOL DISTRICT
 401 NOGALES ST., LA PUENTE, CA 91744

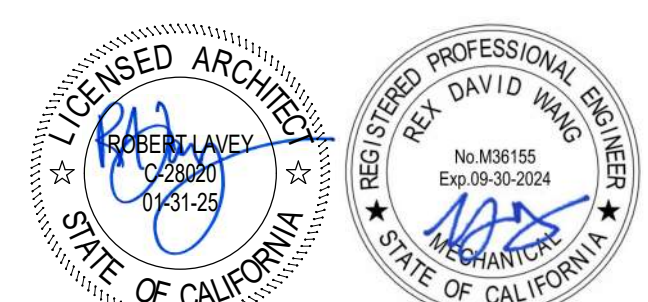


CONSULTANT
LEAF ENGINEERS
 8163 Rochester Avenue, Suite 100
 Rancho Cucamonga, CA 91730
 909-987-0909
 leafengineers.com

1	01/25/24	PBK	ADDENDUM 1
3	03/05/24	PBK	ADDENDUM 3
NO	DATE	BY	DESCRIPTION
REVISIONS			

DRAWN: Author CHECKED: Checker
 DATE: 06/28/22 SCALE: As indicated
 PROJECT NUMBER: 2110000


PLUMBING SCHEDULES

DRAWING NUMBER: **P5.1**

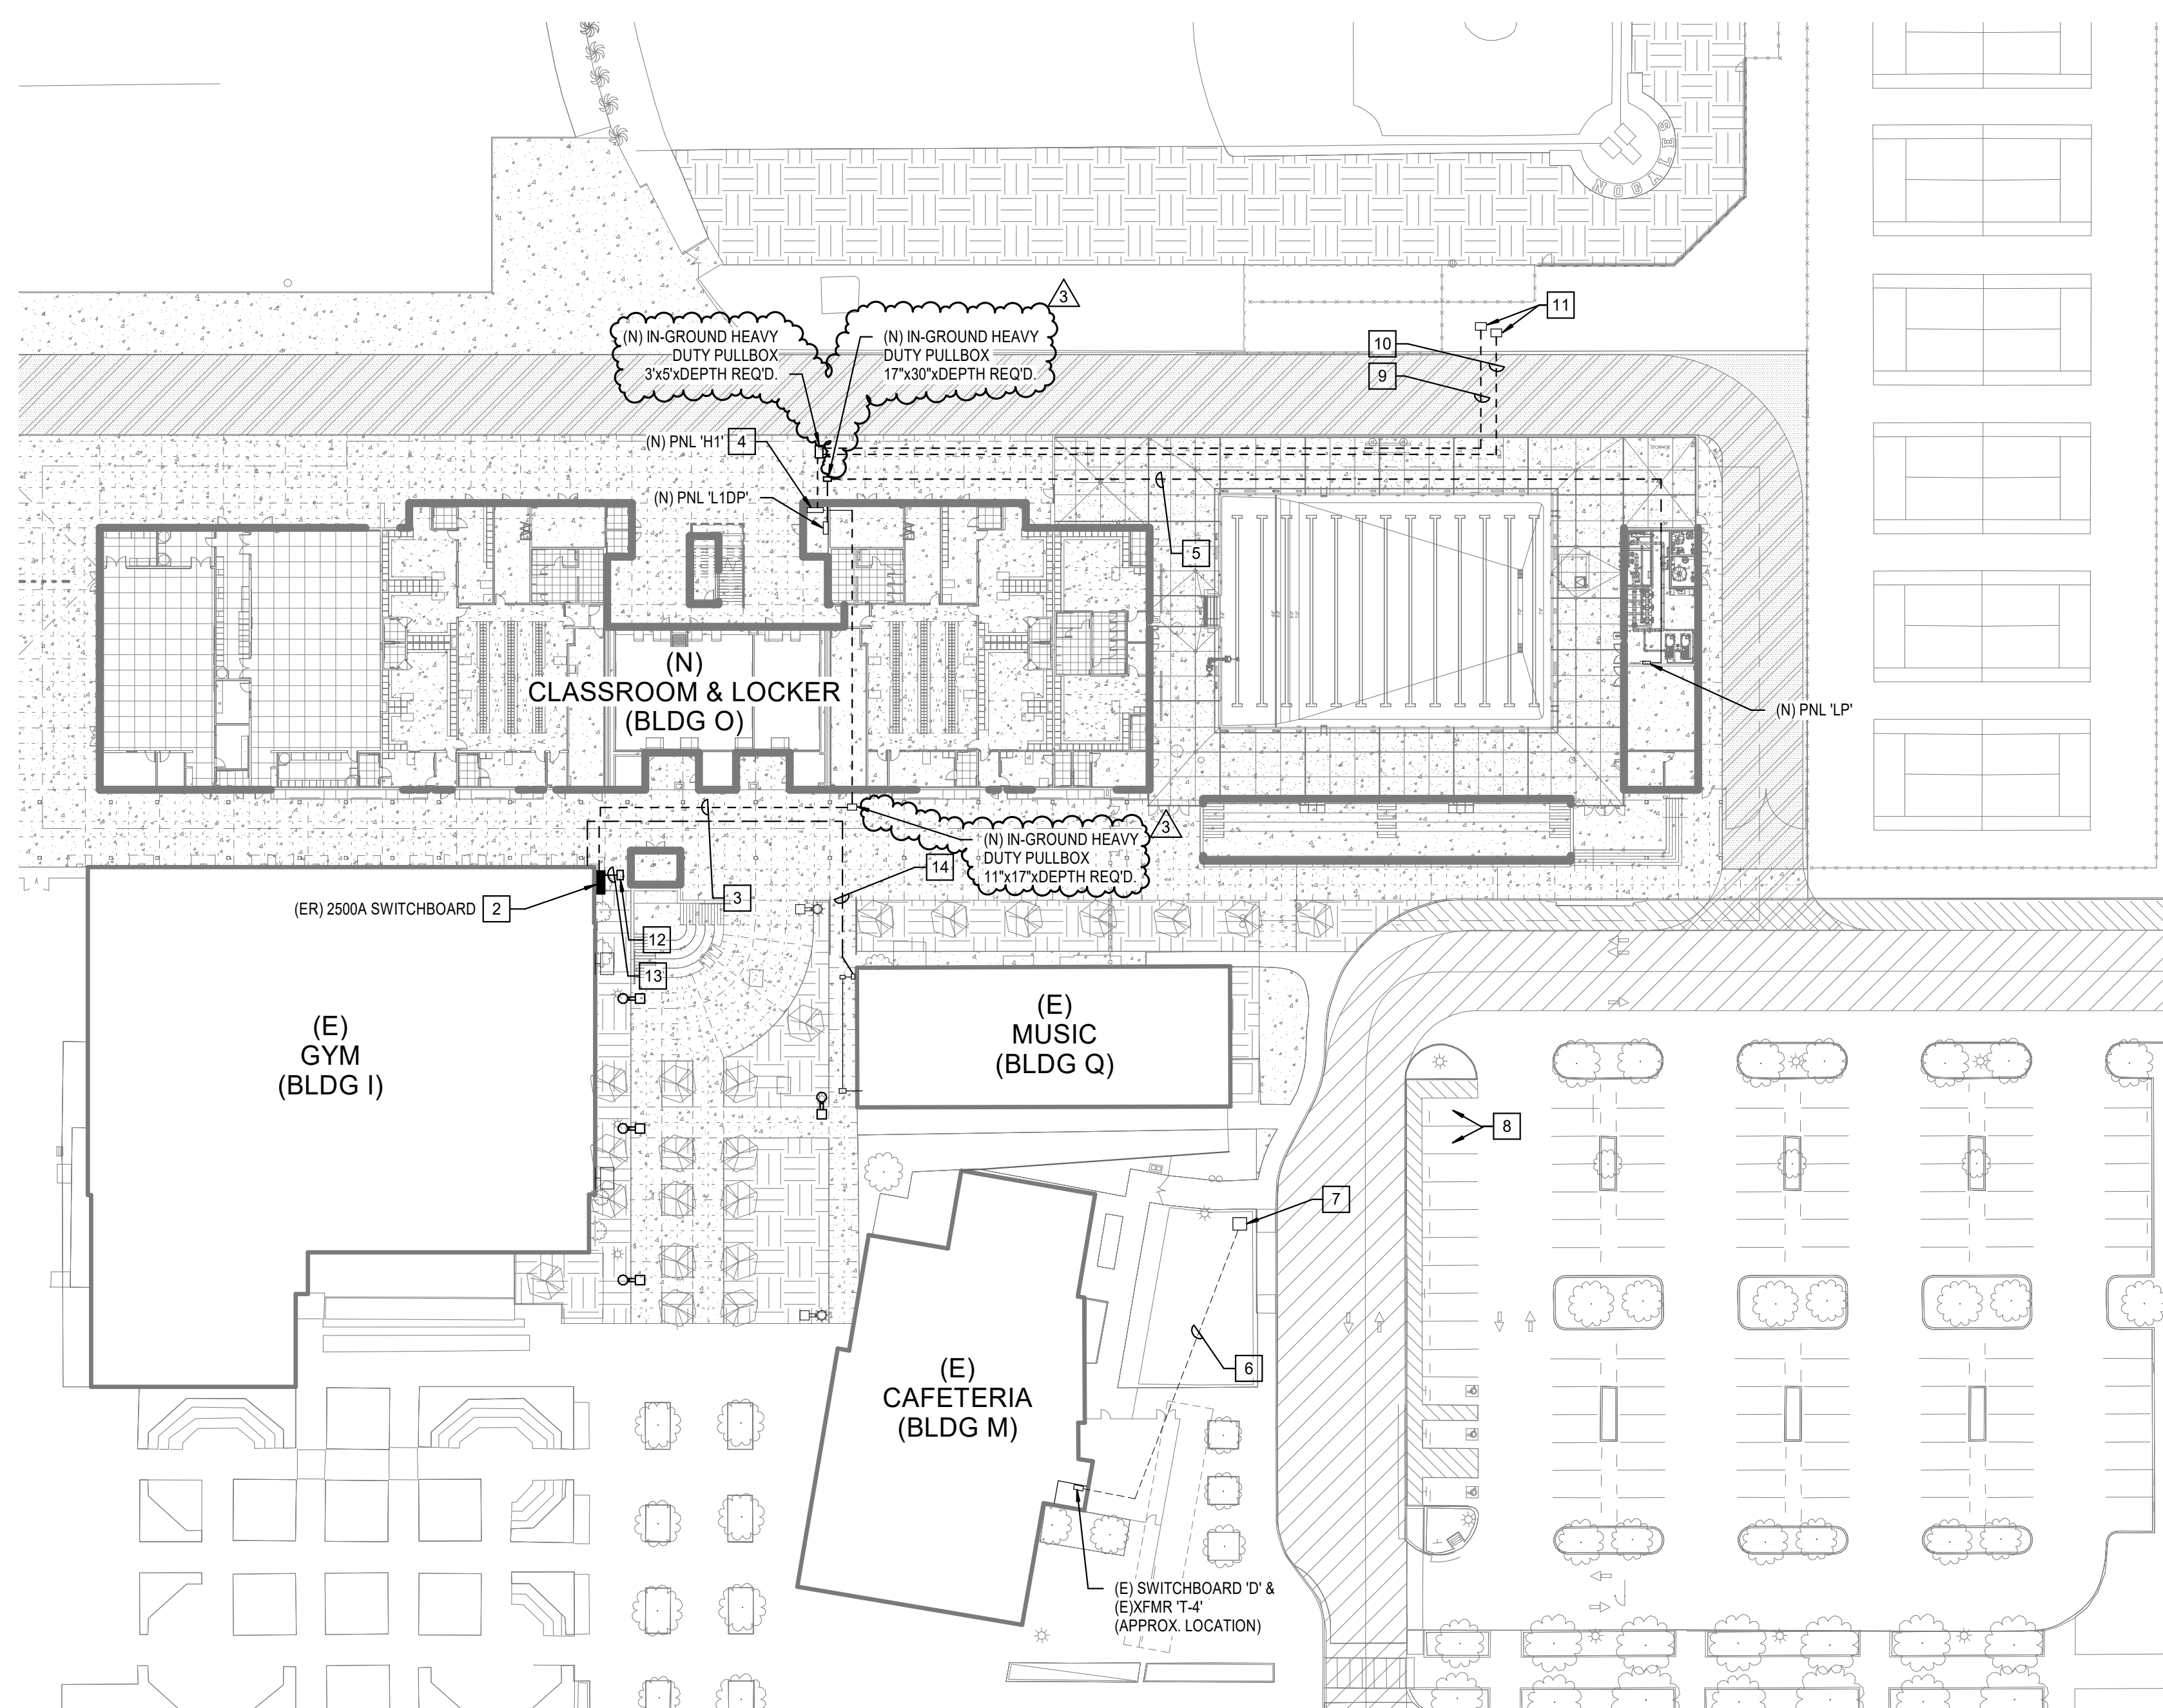

PARTIAL SITE PLAN - NEW

1" = 40'-0" 1

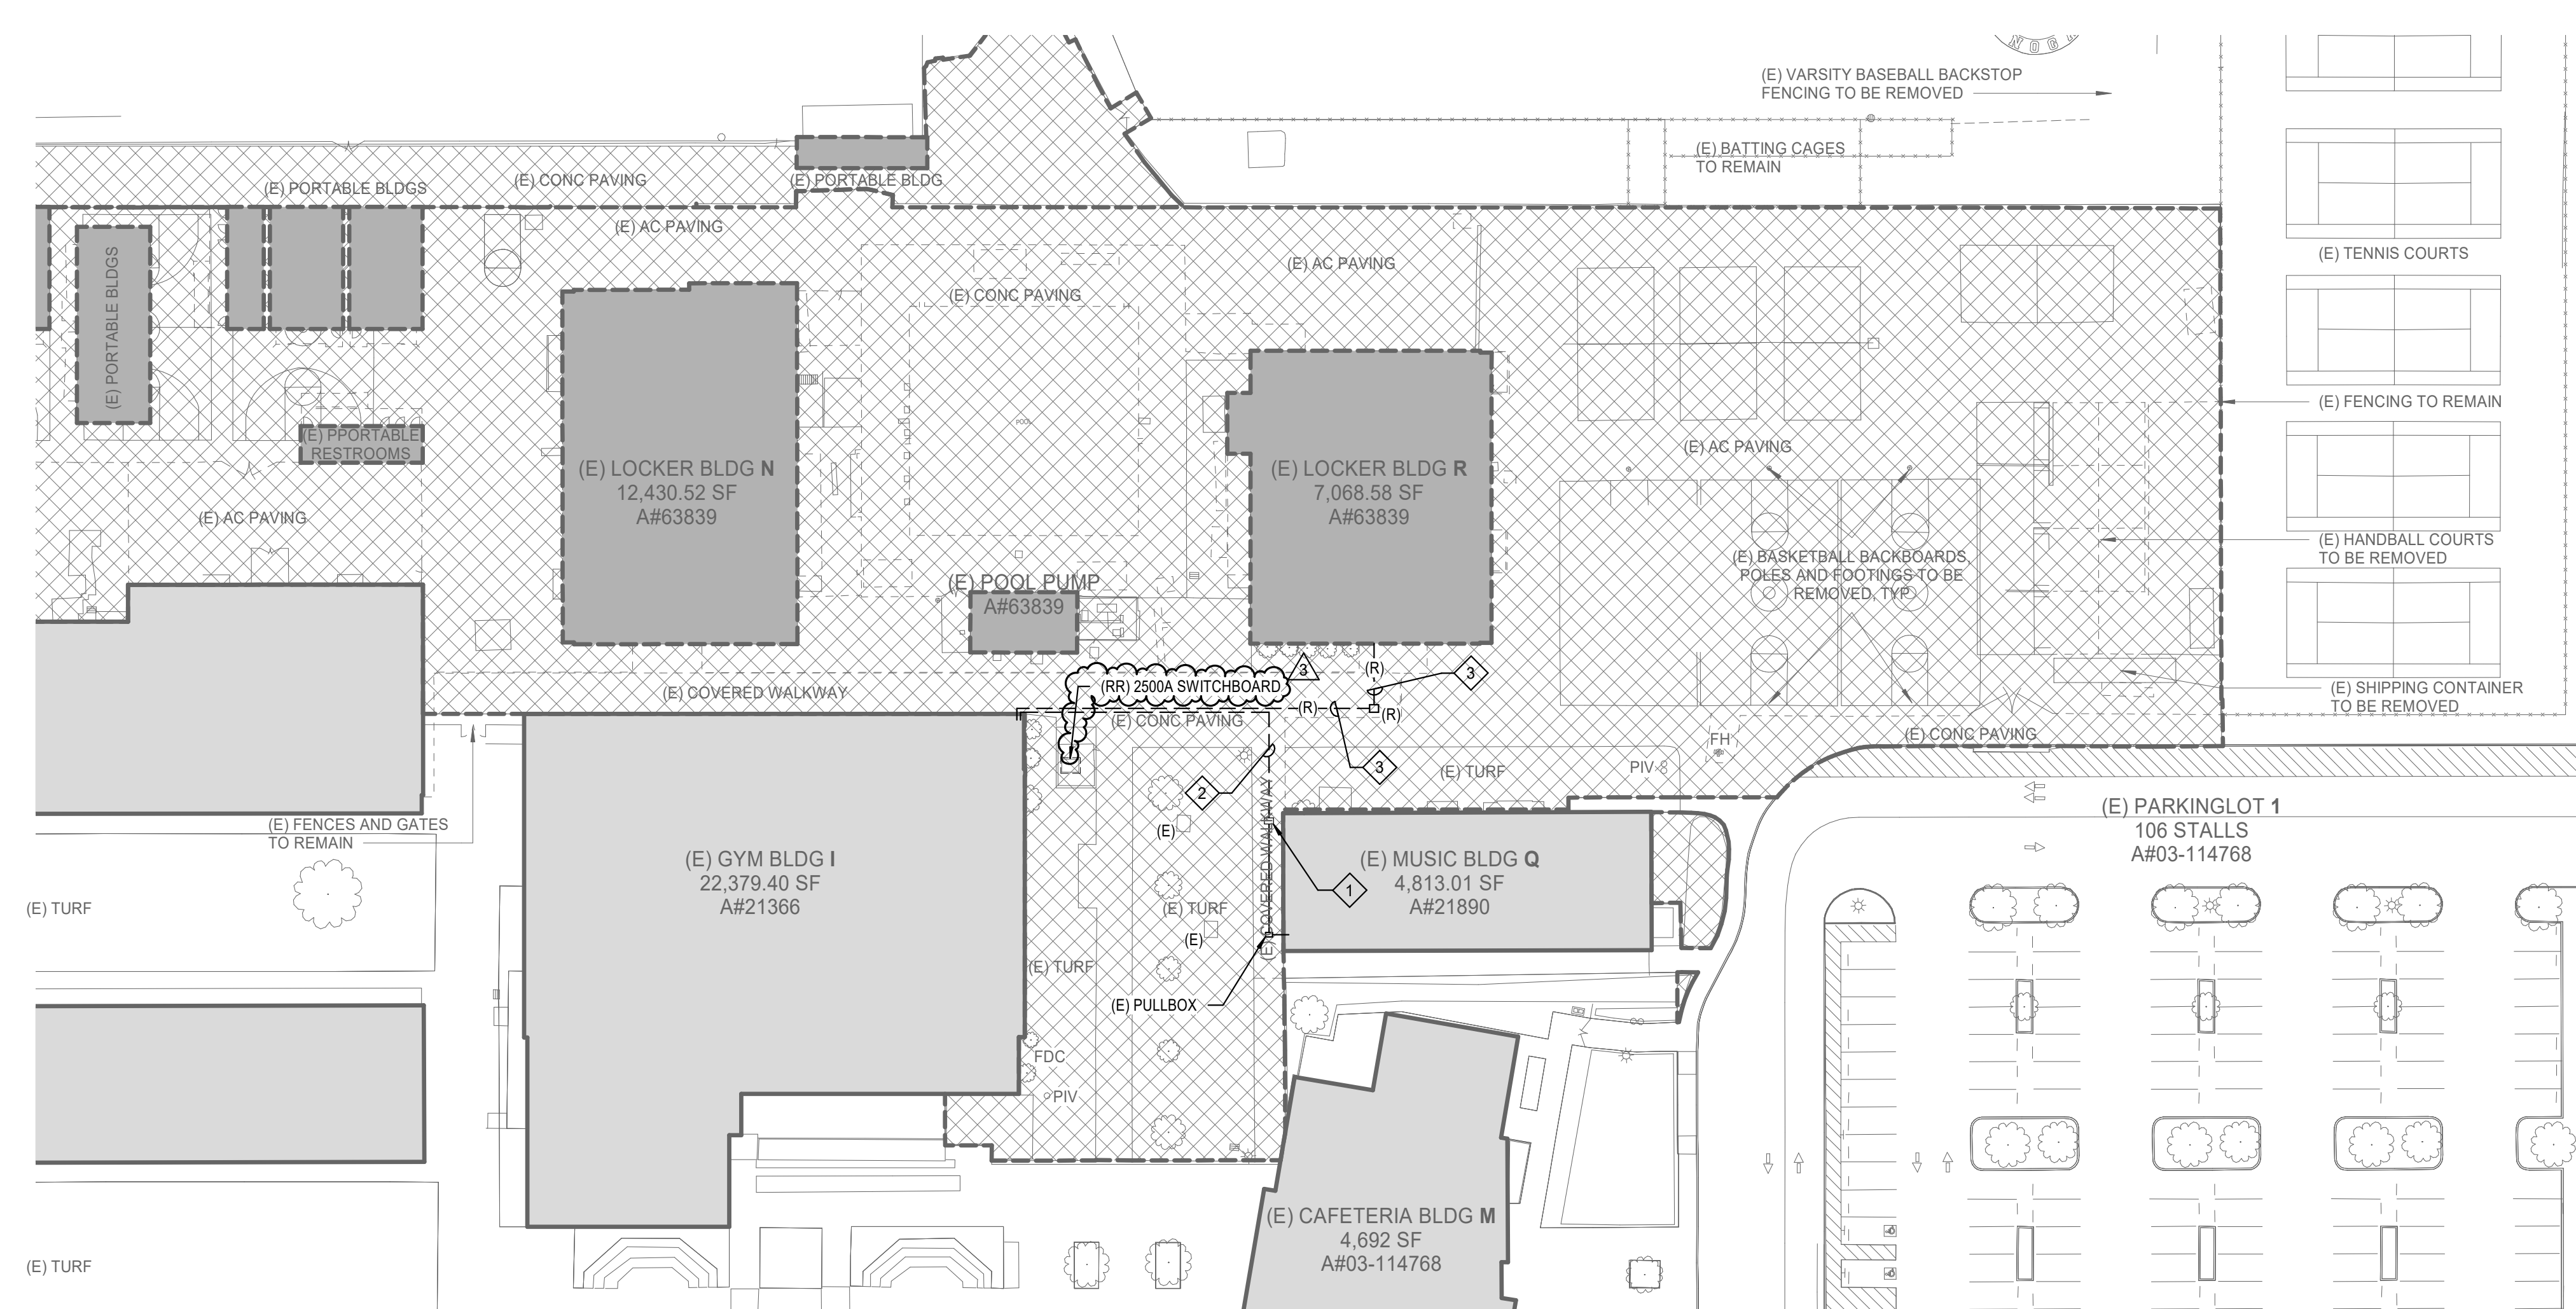

PARTIAL SITE PLAN - DEMO

1" = 40'-0" 2

GENERAL NOTES

1. THE EXISTING BUILDING INCLUDING PORTIONS OF THE RENOVATED AREA SHALL REMAIN IN SERVICE DURING THE CONSTRUCTION PHASE OF THIS PROJECT. ANY MODIFICATIONS TO THE EXISTING ELECTRICAL SYSTEMS THAT MAY REQUIRE THE TEMPORARY INTERRUPTION OF THE EXISTING SERVICES SHALL BE COORDINATED AND PRESCHEDULED WITH THE OWNER'S REPRESENTATIVE PRIOR TO STARTING ANY WORK.
2. ELECTRICAL ENGINEERING FOR THIS PROJECT IS BASED ON EXISTING DRAWINGS, AND A FIELD VISIT OF THE ELECTRICAL SYSTEM. IN CASE OF ANY DISCREPANCIES WITH EXISTING FIELD CONDITIONS, ELECTRICAL CONTRACTOR SHALL VERIFY THE EXACT DIFFERENCES AND NOTIFY THE ELECTRICAL ENGINEER FOR POSSIBLE REVISION TO THESE DOCUMENTS.
3. COORDINATE ROUTING FOR ALL UNDERGROUND ELECTRICAL BRANCH CIRCUITS AND FEEDERS WITH OTHER DISCIPLINES PRIOR TO TRENCHING.
4. CONTRACTOR SHALL BE RESPONSIBLE FOR ANY DAMAGE TO EXISTING UTILITIES CAUSED BY INSTALLATION OF NEW WORK.
5. PER DISTRICT STANDARD CONTRACTOR SHALL PROVIDE CONCRETE ENCASUREMENT TO ALL UNDERGROUND ELECTRICAL AND LOW VOLTAGE LINES.
6. SEE DETAIL 9/E6.1 FOR UNDERGROUND CONDUIT INSTALLATION, 8/E6.1 FOR PULL BOX INSTALLATION, AND 2/E6.1 FOR CONDUIT STUB UPS.

KEY NOTES - NEW WORK

- 1 NOT USED.
- 2 (E) 2500AMP EXTERIOR SWITCHBOARD AT 480Y/277V SHALL BE DISCONNECTED AND RELOCATED TO LOCATION AS SHOWN.
- 3 PROVIDE NEW UNDERGROUND FEEDER FROM (E) EXTERIOR SWITCHBOARD TO NEW PANEL BOARD "HIDP". SEE SINGLE LINE DIAGRAM ON SHEET ES.1 FOR FEEDER AND CONDUIT SIZES.
- 4 NEW PANEL BOARD "HIDP". SEE SINGLE LINE DIAGRAM ON SHEET ES.1 FOR FEEDER AND CONDUIT SIZE.
- 5 PROVIDE NEW UNDERGROUND FEEDER FROM NEW PANEL BOARD "HIDP" TO NEW SPCS POOL CABINET AND FROM L1DP TO PANEL LP. SEE SINGLE LINE DIAGRAM ON SHEET ES.1 FOR FEEDER AND CONDUIT SIZES.
- 6 PROVIDE (2) NEW UNDERGROUND 2". FROM EXISTING SWITCH BOARD "D" TO PULL BOX AS SHOWN ON THE SITE PLAN. SEE SINGLE LINE DIAGRAM ON SHEET ES.1 FOR FEEDER AND CONDUIT SIZES. CONTRACTOR SHALL REPAIR/PATCH AND WEATHER-PROOF ANY OPENING CAUSED BY EQUIPMENT/CONDUIT INSTALLATION, AND SHALL PAINT WHERE NECESSARY, MATCH TO EXISTING.
- 7 CONTRACTOR TO PROVIDE NEW 16" x 16" UNDERGROUND PULLBOX PER NEC WHEN ALL NECESSARY INFORMATION FOR FUTURE EV CHARGER IS DETERMINED.
- 8 PARKING STALL WILL BE DEDICATED FOR FUTURE ELECTRICAL VEHICLE CHARGING STATION. REFER TO ARCHITECTURAL DRAWINGS FOR FURTHER INFORMATION.
- 9 PROVIDE (2) 2" SPARE CONDUITS WITH PULLCORDS FOR FUTURE DATA TO STADIUM.
- 10 PROVIDE (2) 4" SPARE CONDUITS WITH PULLSTRINGS FOR FUTURE POWER TO STADIUM.
- 11 PROVIDE NEW IN-GROUND HEAVY DUTY TRAFFIC RATED PULLBOX. (1) 17"x30"DEPTH REQ'D - FOR COMMUNICATION (1) 17"x30"DEPTH REQ'D - FOR POWER
- 12 PROVIDE NEW IN-GROUND HEAVY DUTY TRAFFIC RATED PULLBOX, 36"x60"DEPTH REQUIRED.
- 13 CONTRACTOR SHALL INTERCEPT AND EXTEND EXISTING FEEDERS AND CONDUITS FROM EXISTING 2500A SWITCHBOARD LOCATION TO THE NEW LOCATION. REFER TO SINGLE LINE DIAGRAM ON SHEET ES.1 FOR ALL CONDUIT AND WIRE SIZING.
- 14 CONTRACTOR SHALL INTERCEPT AND EXTEND EXISTING FEEDERS AND CONDUITS FROM PULLBOX LOCATION TO THE SOURCE. CONTRACTOR TO FIELD VERIFY EXISTING CONDUIT AND FEEDER SIZING, MATCH TO EXISTING.


KEY NOTES - DEMOLITION

- 1 INTERCEPT EXISTING CONDUIT AND FEEDERS TO REMAIN, ROUTE EXISTING CONDUIT AND FEEDERS TO NEW SURFACE MOUNTED PULLBOX ON BREEZEWAY. PROVIDE NEW SURFACE MOUNTED PULLBOX, 12"x12"DEPTH REQUIRED.
- 2 DEMOLISH EXISTING SURFACE MOUNTED CONDUIT AND WIRING ON BREEZEWAY BACK TO SOURCE. NEW UNDERGROUND CONDUIT AND WIRING SHALL BE PROVIDED IN RECONSTRUCTION. SEE NEW WORK KEYNOTE #14 FOR ADDITIONAL INFORMATION.
- 3 ALL EXISTING CONDUIT AND FEEDERS SHALL BE DEMOLISHED BACK TO SOURCE. MARK CIRCUIT BREAKER/S AS 'SPARE'.



RANCHO CUCAMONGA
8163 Rochester Avenue, Suite 100
Rancho Cucamonga, CA 91730
909-987-0909 P

NOGALES HIGH SCHOOL
NEW BUILDING & AQUATIC CENTER
ROWLAND UNIFIED SCHOOL DISTRICT
401 NOGALES ST., LA PUENTE, CA 91744

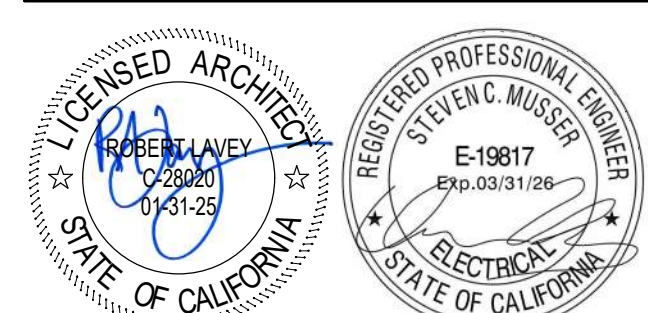

CONSULTANT
LEAF ENGINEERS
8163 Rochester Avenue, Suite 100
Rancho Cucamonga, CA 91730
909-987-0909
leafengineers.com

1	01/25/24	PBK	ADDENDUM 1
3	03/04/24		ADDENDUM 3

NO	DATE	BY	DESCRIPTION
REVISIONS			

DRAWN: Author CHECKED: Checker
DATE: 06/24/22 SCALE: 1" = 40'-0"
PROJECT NUMBER: 2110000



**ELECTRICAL SITE
PLN**

DRAWING NUMBER: **E1.1**



RANCHO CUCAMONGA
8163 Rochester Avenue, Suite 100
Rancho Cucamonga, CA 91730
909-987-0909 P

**NOGALES HIGH SCHOOL
NEW BUILDING & AQUATIC CENTER**
ROWLAND UNIFIED SCHOOL DISTRICT
401 NOGALES ST., LA PUENTE, CA 91744

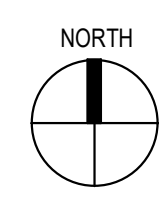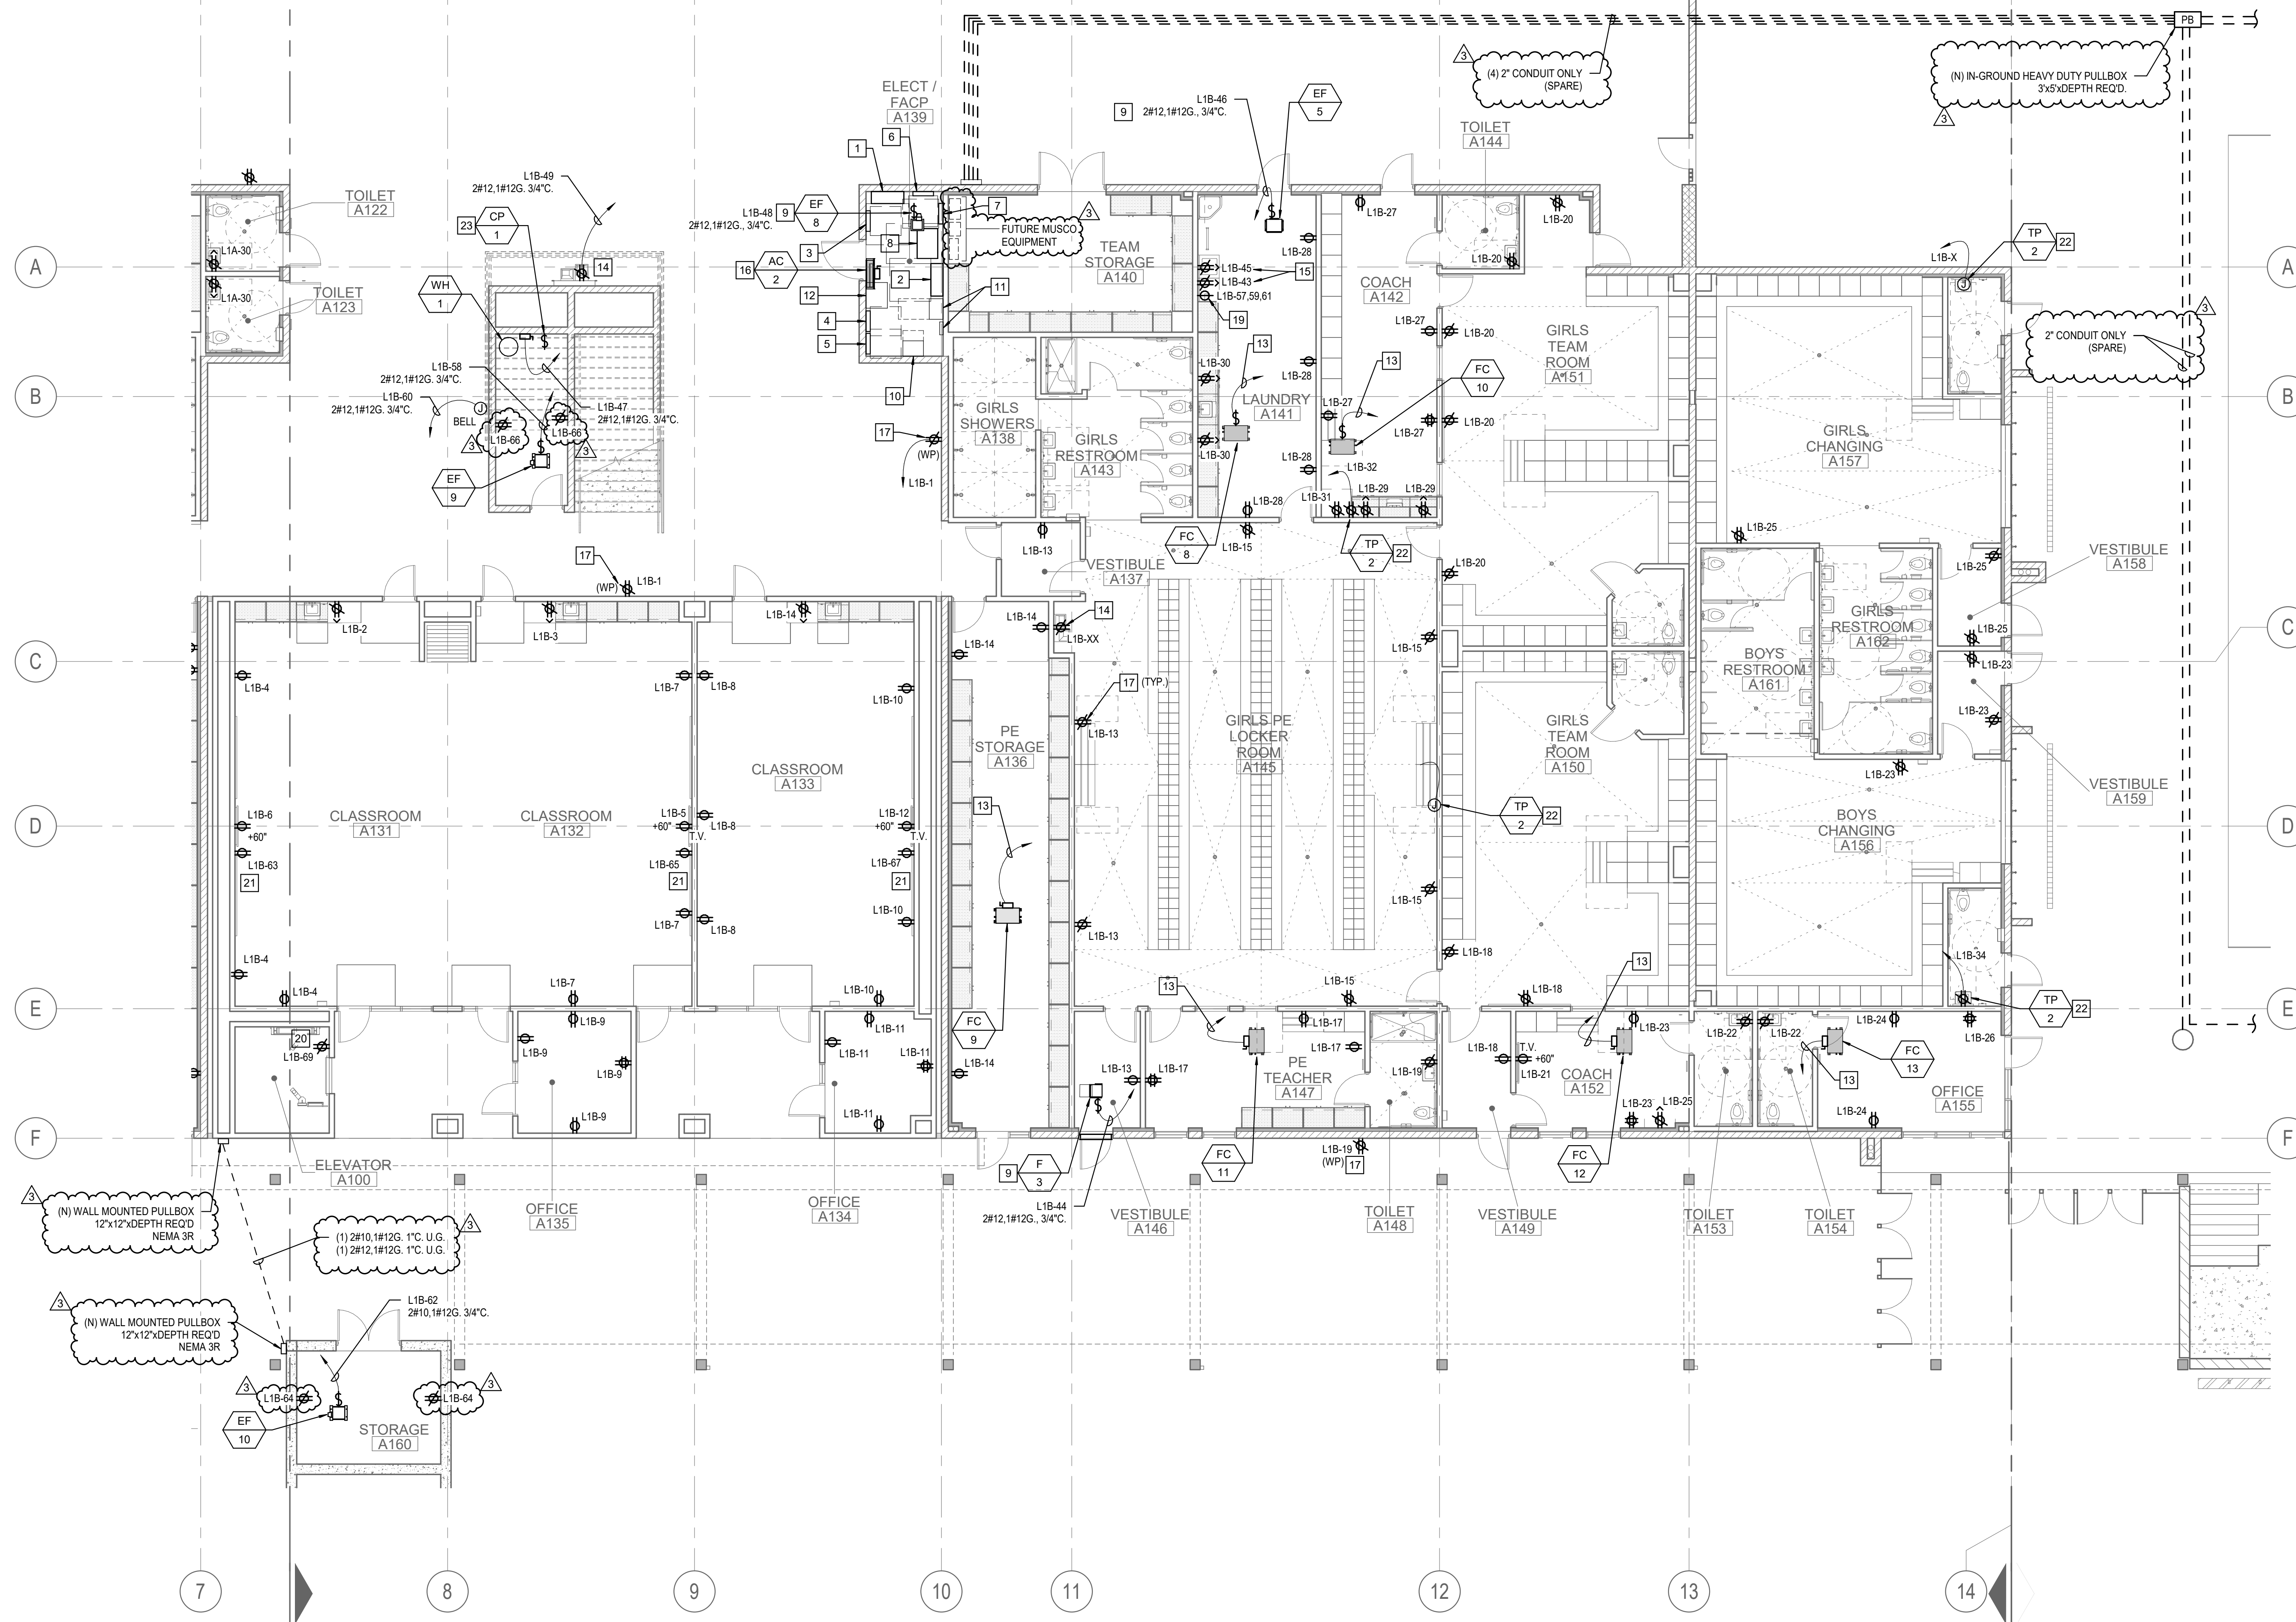

FIRST FLOOR PLAN - AREA B 1/8" = 1'-0" 1

KEY NOTES:

- 1 PROVIDE NEW DISTRIBUTION PANEL "H1DP" 480Y/277V, 3PH, 4W. SEE SINGLE LINE DIAGRAM ON SHEET ES.1 FOR FURTHER DETAILS. REFER TO PANEL MOUNTING DETAIL ON SHEET 7/E6.1.
- 2 PROVIDE NEW DISTRIBUTION PANEL "L1DP" 120/208V, 3PH, 4W. SEE SINGLE LINE DIAGRAM ON SHEET ES.1 FOR FURTHER DETAILS. REFER TO PANEL MOUNTING DETAIL ON SHEET 7/E6.1.
- 3 PROVIDE NEW PANEL "L1A" 120/208V, 3PH, 4W. SEE SINGLE LINE DIAGRAM ON SHEET ES.1 FOR FURTHER DETAILS. REFER TO PANEL MOUNTING DETAIL ON SHEET 7/E6.1.
- 4 PROVIDE NEW PANEL "L1B" 120/208V, 3PH, 4W. SEE SINGLE LINE DIAGRAM ON SHEET ES.1 FOR FURTHER DETAILS. REFER TO PANEL MOUNTING DETAIL ON SHEET 7/E6.1.
- 5 PROVIDE NEW PANEL "L1M" 120/208V, 3PH, 4W. SEE SINGLE LINE DIAGRAM ON SHEET ES.1 FOR FURTHER DETAILS. REFER TO PANEL MOUNTING DETAIL ON SHEET 7/E6.1.
- 6 PROVIDE NEW PANEL "H1MA" 480Y/277V, 3PH, 4W. SEE SINGLE LINE DIAGRAM ON SHEET ES.1 FOR FURTHER DETAILS. REFER TO PANEL MOUNTING DETAIL ON SHEET 7/E6.1.
- 7 PROVIDE NEW PANEL "H1MB" 480Y/277V, 3PH, 4W. SEE SINGLE LINE DIAGRAM ON SHEET ES.1 FOR FURTHER DETAILS. REFER TO PANEL MOUNTING DETAIL ON SHEET 7/E6.1.
- 8 PROVIDE NEW TRANSFORMER "TH1" 112.5 KVA 480-120/208V. SEE DETAIL 4/E6.1. FOR WIRE SIZE AND EQUIPMENT INFORMATION SEE SINGLE LINE DIAGRAM ON SHEET ES.1.
- 9 PROVIDE 120V POWER TO NEW FANS. LOCAL DISCONNECT SWITCH PROVIDED BY MECHANICAL. SEE MECHANICAL SCHEDULE MS.1 FOR ADDITIONAL INFORMATION.
- 10 APPROXIMATE LOCATION OF NEW WALL MOUNTED DF CABINET. CONTRACTOR TO VERIFY WITH TECHNOLOGY PLANS FOR EXACT LOCATION IN THE FIELD. DF CABINET CIRCUITED TO PANEL "L1B" CIRCUIT # 21, 22, 2#12, 1#12G, 3#4.
- 11 APPROXIMATE LOCATION OF NEW WALL MOUNTED FIRE ALARM CABINET. CONTRACTOR TO VERIFY WITH FIRE ALARM PLANS FOR EXACT LOCATION IN THE FIELD. FIRE ALARM CABINET CIRCUITED TO PANEL "L1B" CIRCUIT #23, 24, 25-2#12, 1#12G, 3#4.
- 12 PROVIDE NEW ACUTY BRANDS LIGHTING; LITHONIA IBCN3P SERIES 8KVA INVERTER WITH SINGLE CABINET INCLUDING BATTERIES AND CONTROL PANEL. INVERTER TO BE PROVIDED WITH FACTORY INSTALLED OUTPUT BREAKERS TO SERVE LIGHTING LOADS. INPUT/OUTPUT VOLTAGE TO BE 277/480V AND 277/480 OUT.
- 13 INDOOR FAN COIL POWER CONNECTION IS PROVIDED FROM OUTDOOR UNIT. PROVIDE LOCAL DISCONNECT SWITCH WITH 3#12, 1#12G, 3#4. STUB UP TO ASSOCIATED OUTDOOR HEAT PUMP UNIT. EXTEND CONDUIT AND WIRING TO ROOFTOP UNIT CIRCUITS.
- 14 DRINKING FOUNTAIN, PROVIDE 120V CONNECTION WITH GFCI RECEPTACLE.
- 15 PROVIDE GFCI RECEPTACLE FOR WASHER. CONTRACTOR TO VERIFY EXACT MOUNTING HEIGHT AND LOCATION PRIOR TO ROUGH-IN.
- 16 INDOOR AC UNIT POWER CONNECTION IS PROVIDED FROM OUTDOOR UNIT. PROVIDE LOCAL DISCONNECT SWITCH WITH 3#10, 1#12G, 1" C. STUB OUT TO ASSOCIATED OUTDOOR CONDENSING UNIT AND ASSOCIATED CIRCUIT.
- 17 INSTALL GFCI TYPE DUPLEX RECEPTACLE IN WEATHERPROOF ENCLOSURE.
- 18 PROVIDE NEW PANEL "L1MA" 120/208V, 3PH, 4W, 225A-3P. SEE SINGLE LINE DIAGRAM ON SHEET ES.1 FOR FURTHER DETAILS. REFER TO PANEL MOUNTING DETAIL ON SHEET 7/E6.1.
- 19 PROVIDE DEDICATED 208V/3PH CIRCUIT TO DRYER. INSTALL GFCI TYPE RECEPTACLE. CONTRACTOR TO VERIFY EXACT MOUNTING HEIGHT AND LOCATION PRIOR TO ROUGH-IN. CONTRACTOR TO VERIFY RECEPTACLE NEMA CONFIGURATION PRIOR TO PROCUREMENT.
- 20 PROVIDE GFCI RECEPTACLE FOR ELEVATOR PIT.
- 21 PROVIDE CONNECTION TO ROLLING CART.
- 22 PROVIDE 120V DUPLEX TO TRAP PRIMER VALVE/SP-2. COORDINATE WITH PLUMBING CONTRACTOR FOR EXACT LOCATION.
- 23 PROVIDE 120V POWER CONNECTION TO NEW CIRC PUMP "CP-1". REFER TO PLUMBING PLANS FOR ADDITIONAL INFORMATION.

GENERAL NOTES:

- 1 ALL FAN COIL UNITS ARE POWERED FROM OUTDOOR UNITS. SEE MECHANICAL SCHEDULE ON MS.1 FOR FURTHER DETAILS.
- 2 REFER TO MECHANICAL DRAWINGS FOR EXACT EQUIPMENT PLACEMENT.
- 3 FOR ALL CMU LOCATIONS, POWER AND DATA OUTLETS SHALL BE SURFACE MOUNTED WITH SURFACE MOUNTED CONDUITS SUPPORTED EVERY 10' AS REQUIRED PER NEC.
- 4 FOR EQUIPMENT OR DEVICES SHOWN ON ARCHITECTURAL DRAWINGS THAT REQUIRE POWER AND NOT IDENTIFIED ON ELECTRICAL PLANS, ASSUME AT A MINIMUM A DUPLEX OUTLET, A DEDICATED CIRCUIT WITH 2#12, 1#12G, 3#4. WITH HOMERUN TO NEAREST 120/208V PANEL. ITEMS SUCH AS BUT NOT LIMITED TO ROLL DOWN DOORS, COUNTER DOORS, OVERHEAD GRILLES, DISPLAY CASES, HAND DRYERS, WATER COOLERS, ICE MAKERS, GARBAGE DISPOSALS, OSCILLATING FANS, LCD'S, PROJECTORS, DISHWASHERS, MOTORIZED PROJECTION SCREENS, ETC.
- 5 FOR ALL DEVICES WITH "WP", PROVIDE WEATHERPROOF LOCKABLE ENCLOSURE.

CONSULTANT

LEAF ENGINEERS
8163 Rochester Avenue, Suite 100
Rancho Cucamonga, CA 91730
909.987.0909
leafengineers.com

NO	DATE	BY	DESCRIPTION
1	01/25/24	PBK	ADDENDUM 1
2	02/19/24		ADDENDUM 2
3	03/04/24		ADDENDUM 3
REVISIONS			

DRAWN: Author CHECKED: Checker
DATE: 06/28/22 SCALE: 1/8" = 1'-0"
PROJECT NUMBER: 2110000



**ELECTRICAL - 1ST
FLR PLN - AREA B**

DRAWING NUMBER: **EA2.2**



RANCHO CUCAMONGA
8163 Rochester Avenue, Suite 100
Rancho Cucamonga, CA 91730
909-987-0909 P

**NOGALES HIGH SCHOOL
NEW BUILDING & AQUATIC CENTER**
ROWLAND UNIFIED SCHOOL DISTRICT
401 NOGALES ST., LA PUENTE, CA 91744

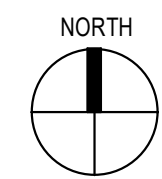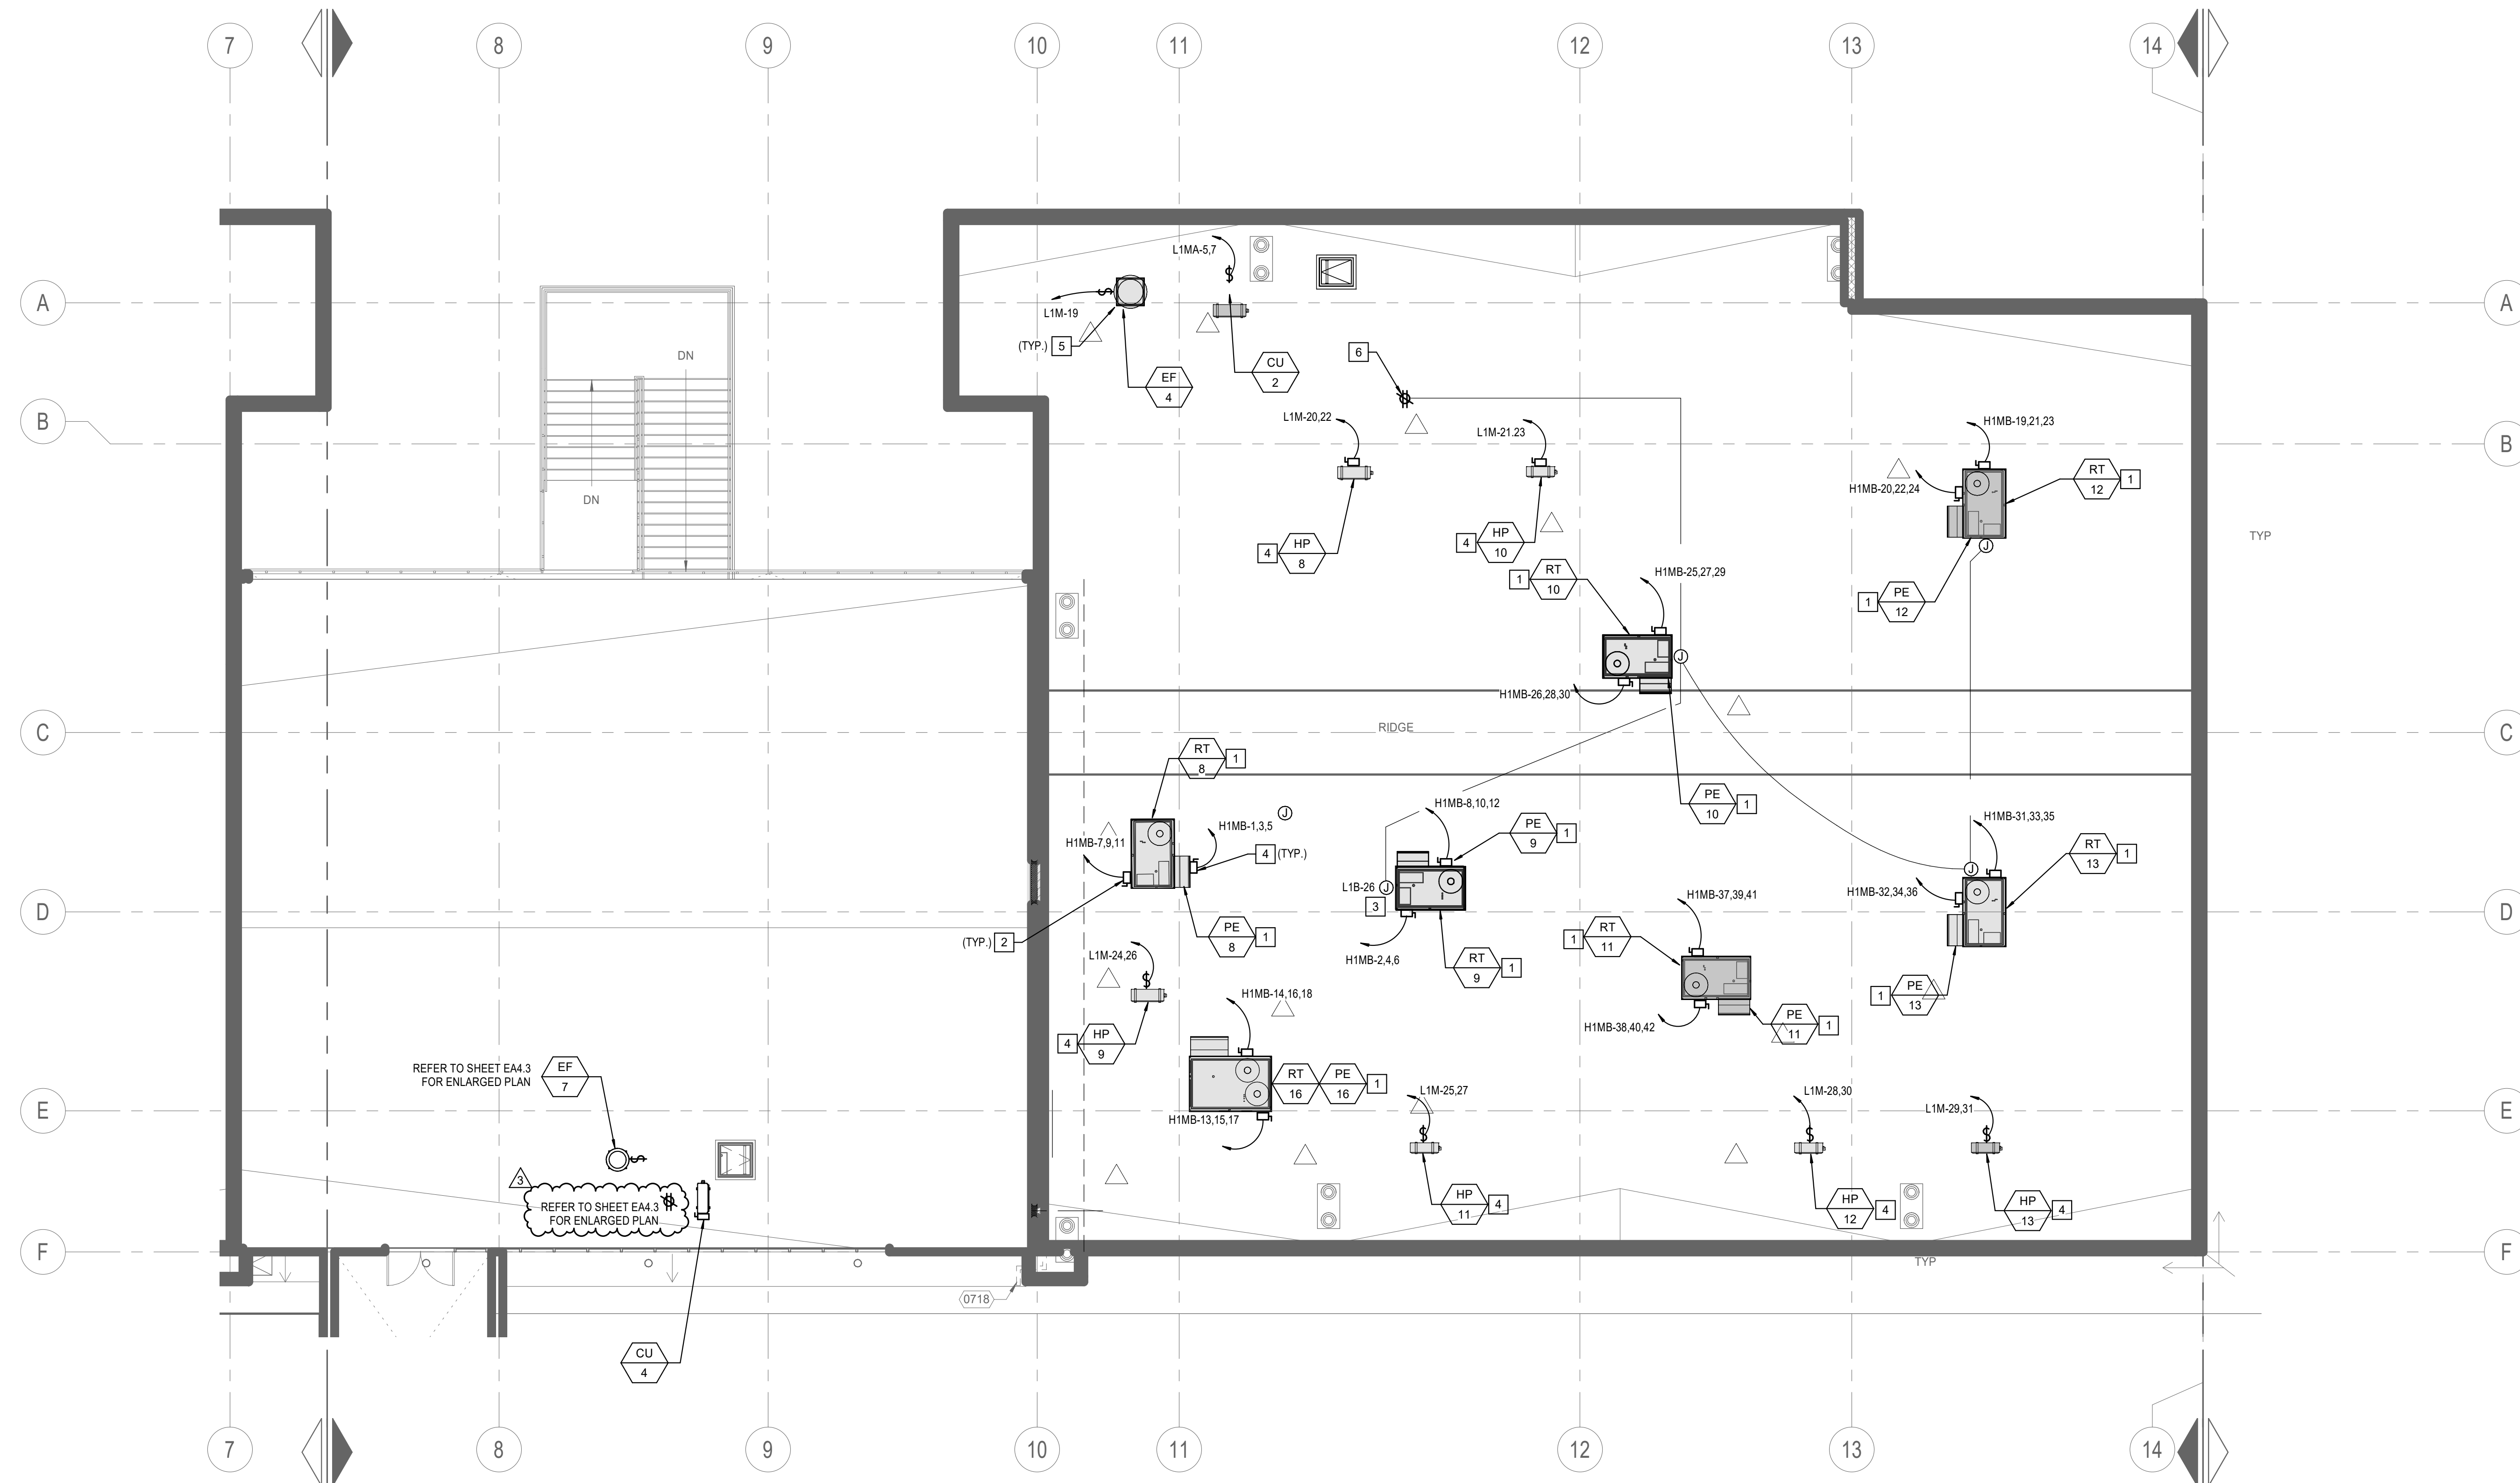

BUILDING A - ROOF PLAN - AREA B

1/8" = 1'-0"


1

KEY NOTES:

- 1 PROVIDE 480V 3PH POWER CONNECTION TO NEW MECHANICAL UNIT.
- 2 NON-FUSIBLE DISCONNECT SWITCH SHALL BE PRE-INSTALLED FROM MANUFACTURER ON THE UNITS IN A NEMA-3R ENCLOSURE. CONNECT TO CIRCUIT AS SHOWN.
- 3 PROVIDE 20'x2, 1#12G, 34°C. POWER CONNECTION TO CONVENIENCE OUTLET PROVIDED IN MECHANICAL UNIT.
- 4 PROVIDE NON-FUSIBLE DISCONNECT NEMA 3R FOR ALL POWER EXHAUST FANS AND HEAT PUMPS.
- 5 PROVIDE NEMA 3R MOTOR RATED SWITCH FOR EXHAUST FANS AND CONNECT TO CIRCUIT AS SHOWN.
- 6 PROVIDE ROOFTOP CONVENIENCE RECEPTACLE, GFCI WEATHERPROOF.

GENERAL NOTES:

- 1. REFER TO MECHANICAL DRAWINGS FOR EXACT EQUIPMENT PLACEMENT.

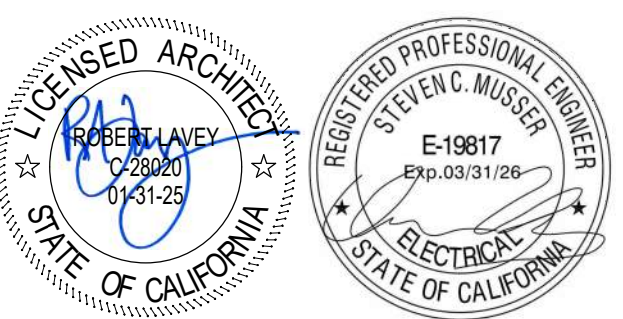

CONSULTANT



8163 Rochester Avenue, Suite 100
Rancho Cucamonga, CA 91730
909-987-0909
leafengineers.com

1	01/25/24	PBK	ADDENDUM 1
3	03/04/24		ADDENDUM 3

NO	DATE	BY	DESCRIPTION
REVISIONS			

DRAWN: Author CHECKED: Checker

DATE: 06/28/22 SCALE: 1/8" = 1'-0"

PROJECT NUMBER: 2110000


**ELECTRICAL - ROOF
PLAN - AREA B**

DRAWING NUMBER: **EA4.2**



RANCHO CUCAMONGA
8163 Rochester Avenue, Suite 100
Rancho Cucamonga, CA 91730
909-987-0909 P

**NOGALES HIGH SCHOOL
NEW BUILDING & AQUATIC CENTER**
ROWLAND UNIFIED SCHOOL DISTRICT
401 NOGALES ST, LA PUENTE, CA 91744

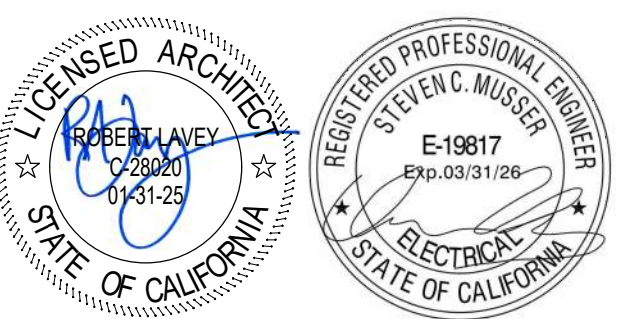




CONSULTANT
LEAF ENGINEERS
8163 Rochester Avenue, Suite 100
Rancho Cucamonga, CA 91730
909-987-0909
leafengineers.com

NO	DATE	BY	DESCRIPTION
1	01/25/24	PBK	ADDENDUM 1
3	03/04/24		ADDENDUM 3
REVISIONS			

DRAWN: Author CHECKED: Checker
DATE: 06/28/22 SCALE: As indicated
PROJECT NUMBER: 2110000

ELECTRICAL - 2ND FLOOR ROOF PLAN

DRAWING NUMBER: **EA4.3**

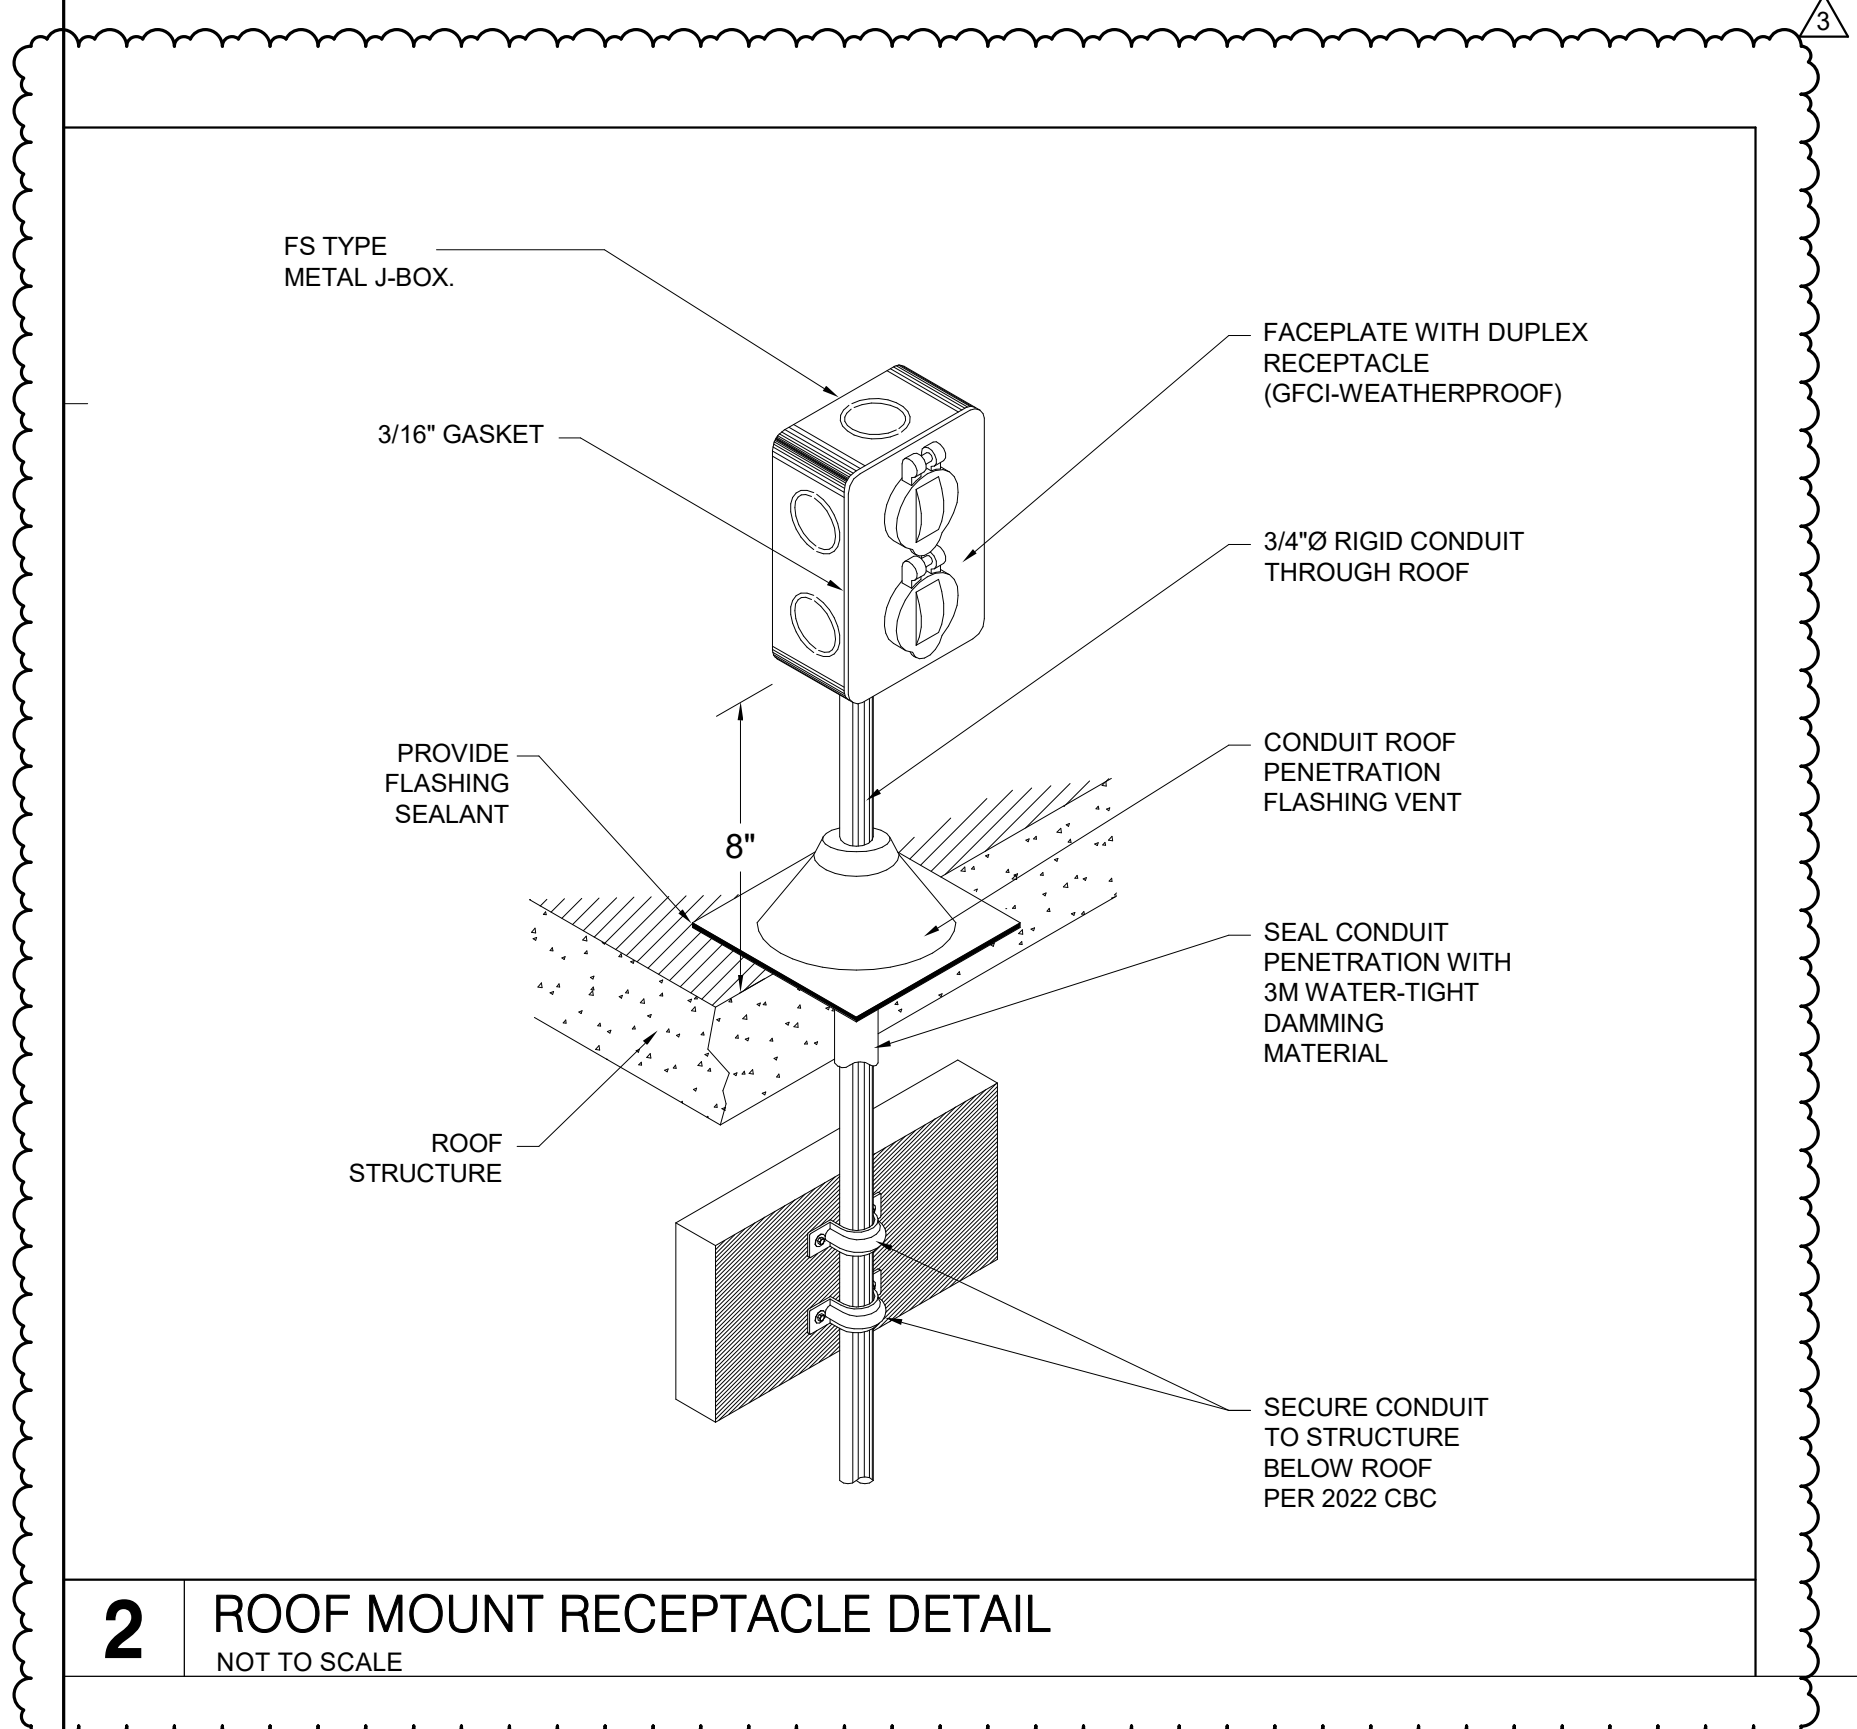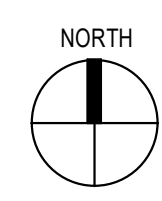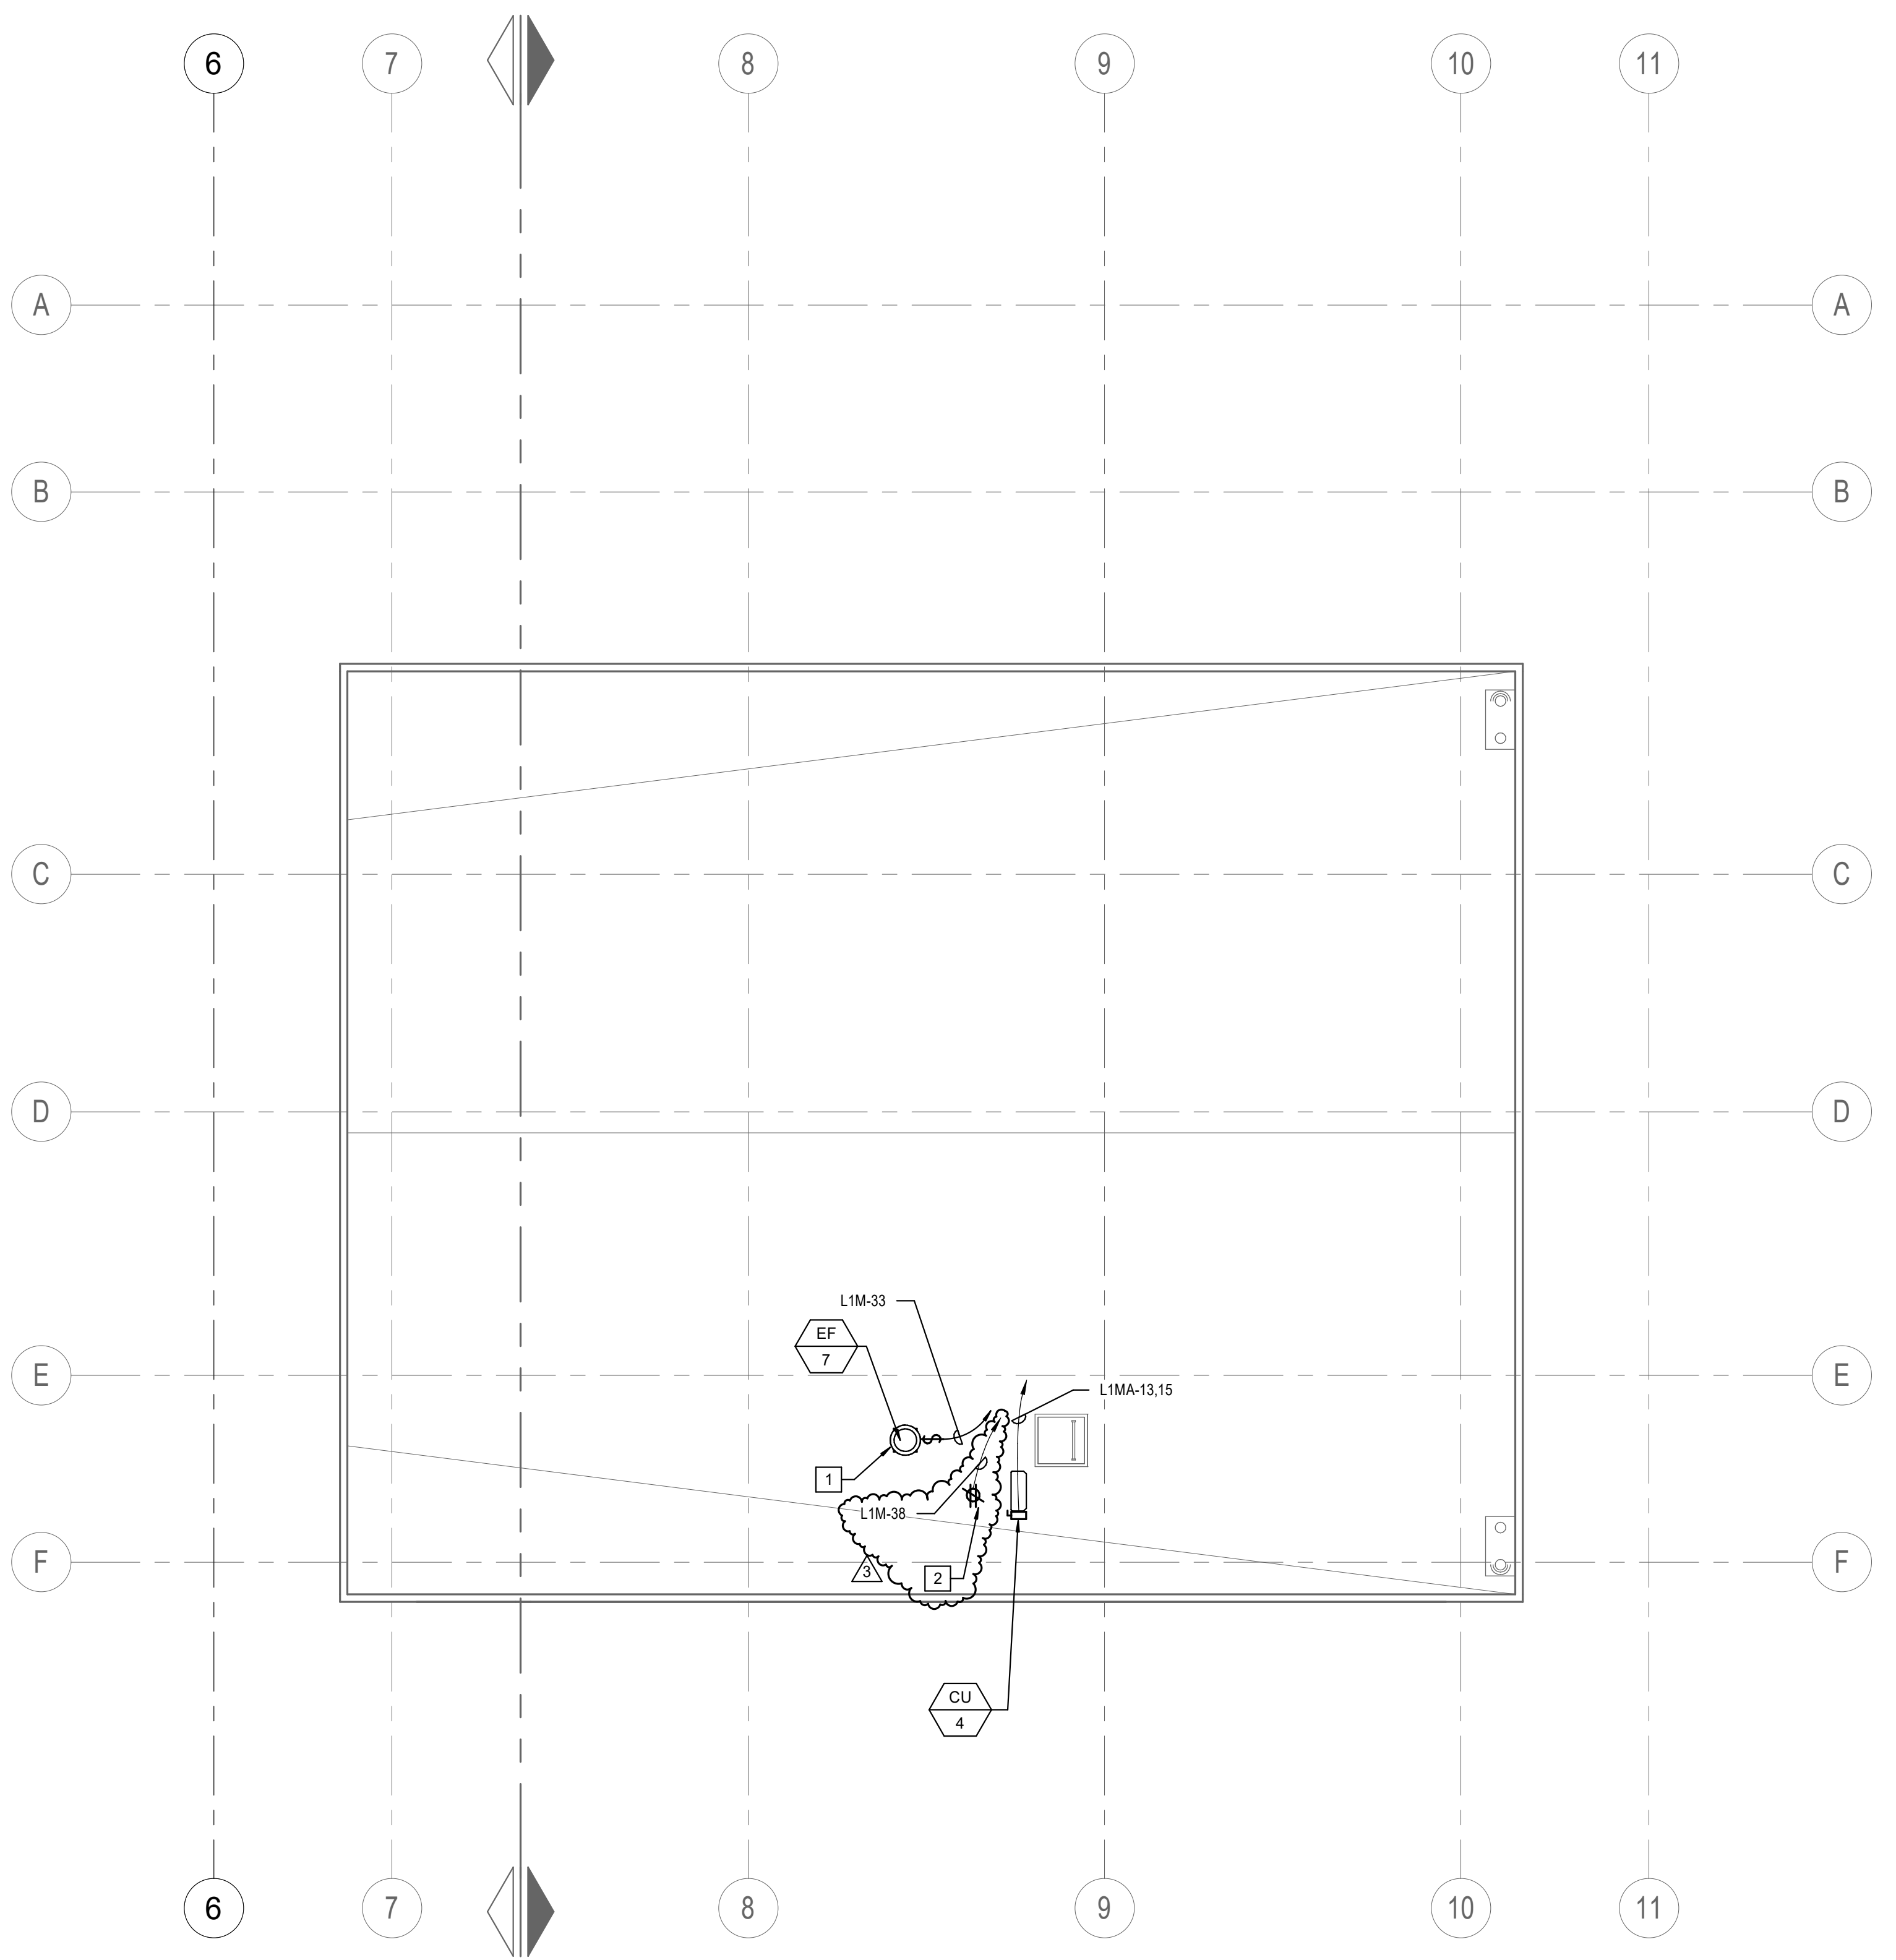

2 ROOF MOUNT RECEPTACLE DETAIL
NOT TO SCALE

BUILDING A - SECOND FLOOR ROOF PLAN 1/8" = 1'-0" 1

KEY NOTES:

- 1 PROVIDE NEMA 3R MOTOR RATED SWITCH FOR EXHAUST FANS AND CONNECT TO CIRCUIT AS SHOWN
- 2 PROVIDE AND INSTALL ROOF MOUNTED WEATHERPROOF GFCI DUPLEX RECEPTACLE. REFER TO DETAIL 2/EA4.3 FOR MOUNTING DETAIL.

GENERAL NOTES:



1. REFER TO MECHANICAL DRAWINGS FOR EXACT EQUIPMENT PLACEMENT.

18/0004 11/07/24 AE
 C:\Users\mccormack\OneDrive\Documents\21100000\EA4.3 - Detail - 2nd floor receptacle.dwg



RANCHO CUCAMONGA
8163 Rochester Avenue, Suite 100
Rancho Cucamonga, CA 91730
909-987-0909 P

**NOGALES HIGH SCHOOL
NEW BUILDING & AQUATIC CENTER**
ROWLAND UNIFIED SCHOOL DISTRICT
401 NOGALES ST., LA PUENTE, CA 91744

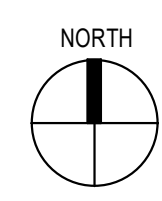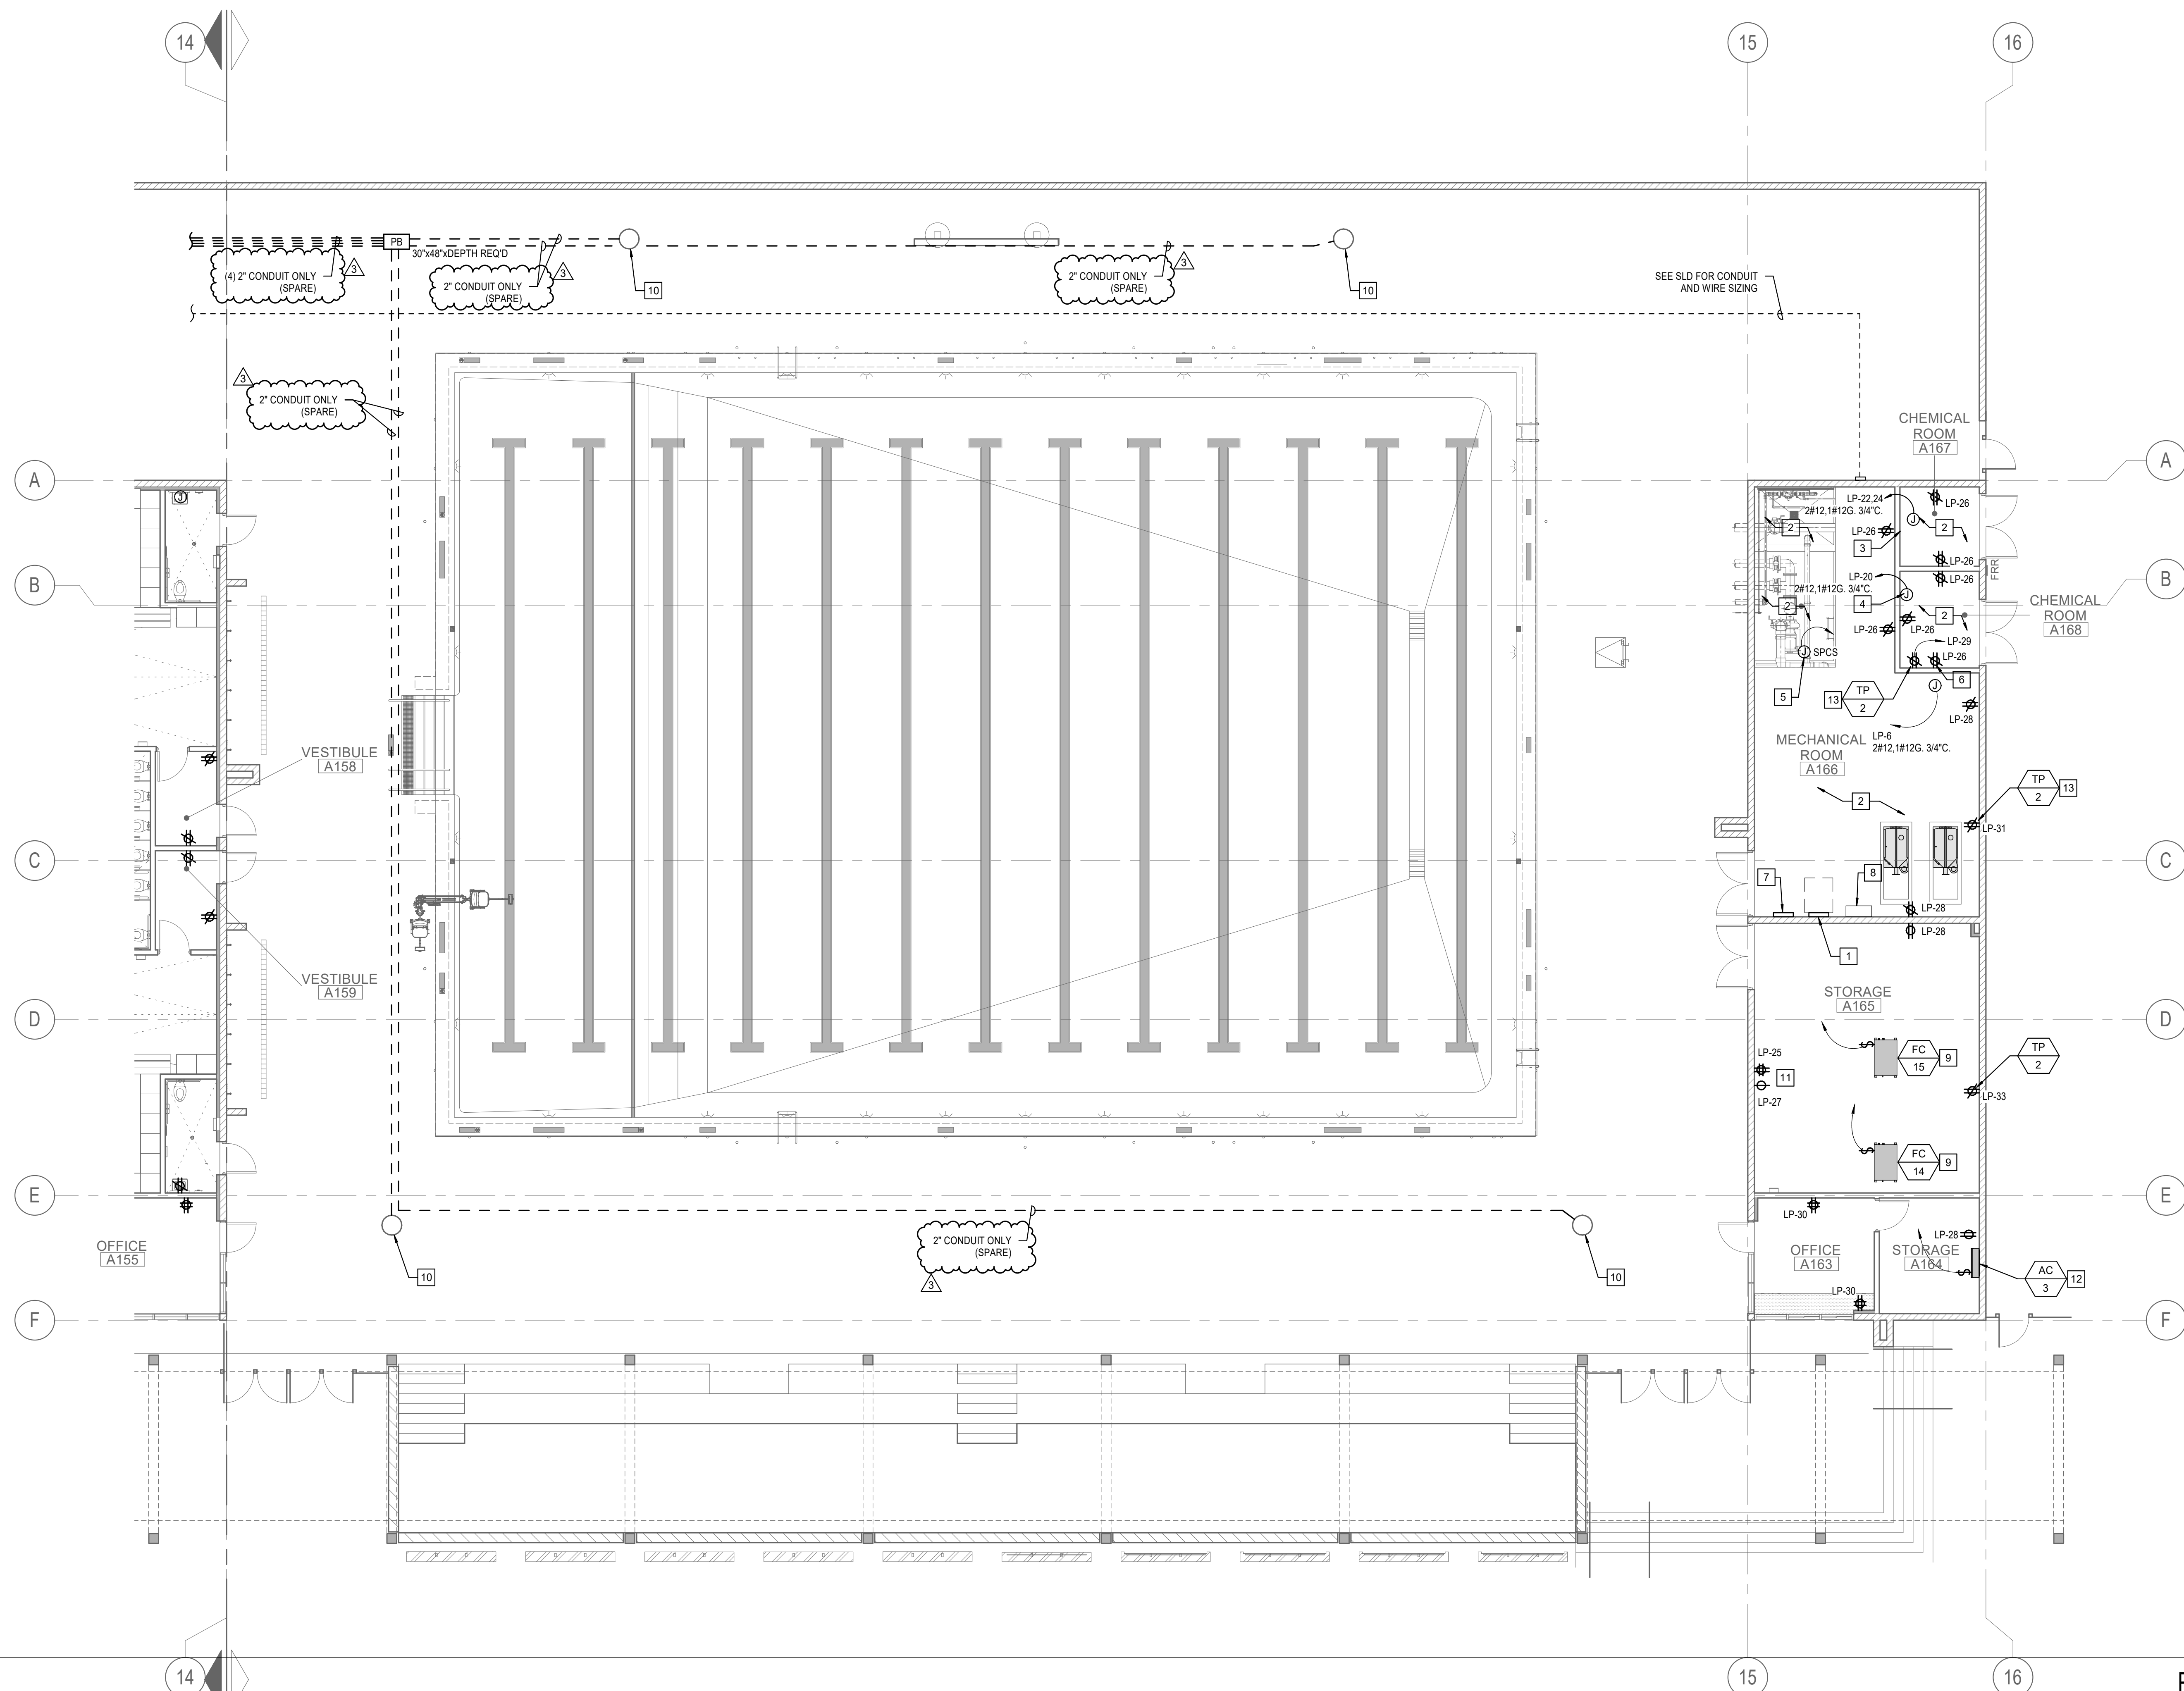


POOL FLOOR PLAN 1/8" = 1'-0" 1

KEY NOTES:

- 1 PROVIDE NEW PANEL "LP" 120/200V, 3PH, 4W-100A-3P. SEE SINGLE LINE DIAGRAM ON SHEET ES.1 FOR FURTHER DETAILS.
- 2 FOR EXACT LOCATION OF POOL EQUIPMENT LAYOUT SEE POOL CONSULTANT DRAWINGS ON SHEET MR.1 FOR FURTHER DETAILS.
- 3 PROVIDE JUNCTION BOX FOR ACID FEED PUMP. CONNECT CIRCUIT AS SHOWN. POOL CONSULTANT RECOMMENDED INSTRUCTIONS SHALL SUPERSEDE DESIGN VALUE. SEE POOL CONSULTANT DRAWINGS ON SHEET MR.1 FOR FURTHER DETAILS.
- 4 PROVIDE JUNCTION BOX FOR CHLORINE FEED PUMP. CONNECT CIRCUIT AS SHOWN. POOL CONSULTANT RECOMMENDED INSTRUCTIONS SHALL SUPERSEDE DESIGN VALUE. SEE POOL CONSULTANT DRAWINGS ON SHEET MR.1 FOR FURTHER DETAILS.
- 5 PROVIDE JUNCTION BOX FOR CIRC. PUMP. CONNECT CIRCUIT AS SHOWN. SEE NOTE 8. POOL CONSULTANT RECOMMENDED INSTRUCTIONS SHALL SUPERSEDE DESIGN VALUE. SEE POOL CONSULTANT DRAWINGS ON SHEET MR.1 FOR FURTHER DETAILS.
- 6 PROVIDE JUNCTION BOX FOR WATER CHEMISTRY CONTROLLER. CONNECT CIRCUIT AS SHOWN. POOL CONSULTANT RECOMMENDED INSTRUCTIONS SHALL SUPERSEDE DESIGN VALUE. SEE POOL CONSULTANT DRAWINGS ON SHEET MR.1 FOR FURTHER DETAILS.
- 7 PROVIDE POWER FOR LIGHTING CONTACTOR. PANEL VIA ELECTRICAL "LP" SEE POOL CONSULTANT DRAWINGS ON SHEET MR.7 FOR FURTHER DETAILS.
- 8 PROVIDE 480V, 3PH, FOR SMART PUMP CONTROL SYSTEM WHICH WILL FEED SWIMMING POOL CIRC. PUMP 25 HP. SEE POOL CONSULTANT DETAILS FOR FURTHER INFORMATION.
- 9 INDOOR FAN COIL POWER CONNECTION IS PROVIDED FROM OUTDOOR UNIT. PROVIDE 3#12, 1#12G, 3/4"C. STUB UP TO ASSOCIATED OUTDOOR HEAT PUMP UNIT. EXTEND CONDUIT AND WIRING TO ROOFTOP UNIT CIRCUITS.
- 10 APPROXIMATE FUTURE MUSCO POLE LOCATION(S). CONTRACTOR TO PROVIDE SPARE 2" CONDUIT. STUB UP AND CAP AT THE APPROXIMATE LOCATIONS SHOWN. SEE ARCHITECTURAL PLAN SHEET A2.4 FOR EXACT LOCATION.
- 11 PROVIDE QUAD AND NEMA 1E30R RECEPTACLES FOR WALL MOUNT IDF CABINET. COORDINATE MOUNTING HEIGHT WITH TECHNOLOGY INSTALLATION PRIOR TO ROUGH IN.
- 12 INDOOR AC UNIT POWER CONNECTION IS PROVIDED FROM OUTDOOR UNIT. PROVIDE LOCAL DISCONNECT SWITCH WITH 3#10, 1 #12G, 1"C. STUB OUT TO ASSOCIATED OUTDOOR CONDENSING UNIT AND ASSOCIATED CIRCUIT.
- 13 PROVIDE 120V CONNECTION TO TRAP PRIMER VALVE(S) TP-2. COORDINATE WITH PLUMBING CONTRACTOR FOR EXACT LOCATION.

GENERAL NOTES:

1. CIRCUITS AND CONNECTIONS FOR POOL EQUIPMENT ARE TO BE INSTALLED PER POOL CONSULTANT INSTRUCTIONS. SEE POOL CONSULTANT DETAILS ON SHEETS MR.1-MR.7

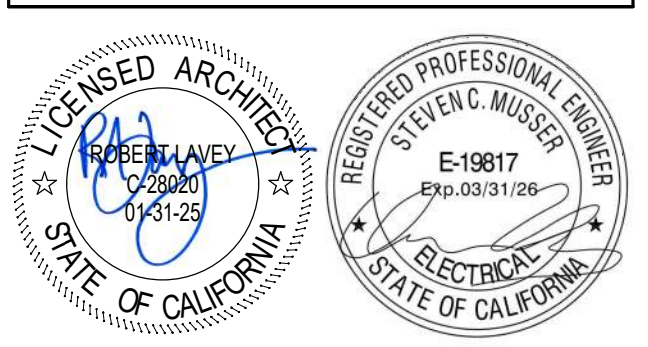

CONSULTANT
LEAF ENGINEERS
8163 Rochester Avenue, Suite 100
Rancho Cucamonga, CA 91730
909.987.0909
leafengineers.com

NO	DATE	BY	DESCRIPTION
1	01/25/24	PBK	ADDENDUM 1
2	02/19/24		ADDENDUM 2
3	03/04/24		ADDENDUM 3
REVISIONS			

DRAWN: Author CHECKED: Checker
DATE: 06/28/22 SCALE: 1/8" = 1'-0"
PROJECT NUMBER: 2110000

**ELECTRICAL - POOL
FLR PLN**


DRAWING NUMBER: **EB2.1**

18/06/2024 11:07:44 AM
 C:\Users\mccormack\OneDrive\Documents\18100000\MR.1-1\Pool_Floor_Plan_EB2.1.dwg



RANCHO CUCAMONGA
8163 Rochester Avenue, Suite 100
Rancho Cucamonga, CA 91730
909-987-0909 P

NOGALES HIGH SCHOOL
NEW BUILDING & AQUATIC CENTER
ROWLAND UNIFIED SCHOOL DISTRICT
401 NOGALES ST., LA PUENTE, CA 91744

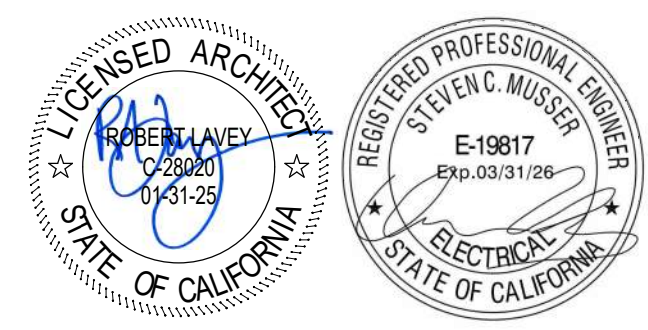

CONSULTANT
LEAF ENGINEERS
8163 Rochester Avenue, Suite 100
Rancho Cucamonga, CA 91730
909-987-0909
leafengineers.com

1	01/25/24	PBK	ADDENDUM 1
2	02/19/24		ADDENDUM 2
3	03/04/24		ADDENDUM 3

NO DATE BY DESCRIPTION
REVISIONS

DRAWN: Author CHECKED: Checker
DATE: 11/17/22 SCALE: 12" = 1'-0"
PROJECT NUMBER: 2110000

DRAWING NUMBER: **E5.2**

Job: NOGALES HS ADDITION Job No: W2110000AR AIC Rating: 4200

Mounting SURFACE Main Type: MCB (600A) Neutral: 100% Voltage: 480Y/277V-3PH 4W Main Size: 800 AMPS Equipment Ground: SINGLE

PANEL: H1DP

ALL LOADS IN VA																									
Ltg	Recept	Motor	Heat	Cool	Other	Kitchen	S/S	Description	Amp/P	Wire	Cr. No.	Ph	Cr. No.	Wire	Amp/P	Description	Ltg	Recept	Motor	Heat	Cool	Other	Kitchen	S/S	
								TRANSFORMER TH1	1	A	2					3200	RT-1 ROOF								
								PER SLD PER SLD	1	A	2					3200	ELEV. MOTOR								
									3	B	4					3200									
									5	C	6					3200									
								PANEL H1MA	7	A	8					3000	PER SLD PER SLD PANEL H1MB								
									9	B	10					3000									
									11	C	12					3000									
1466								INV-1	13	A	14					2700	PER SLD PER SLD AREA B LIGHTS								
1466									15	B	16					1000	PER SLD PER SLD 2ND FLOOR LIGHTS								
1466									17	C	18						PER SLD PER SLD POOL BLDG LIGHTS								
								AREA A LGHTS	19	A	20					1.00	PER SLD PER SLD SPARE								
								RT-14	21	B	22					0.00	PER SLD PER SLD RT-14								
5263									23	A	24					9418	PER SLD PER SLD POOL PUMP								
5263									25	B	26					9418	PER SLD PER SLD POOL PUMP								
970								PE-14	27	B	28					0.00	PER SLD PER SLD PE-14								
970									29	C	30					0.00	PER SLD PER SLD PE-14								
								OPEN	31	A	32					0.00	PER SLD PER SLD OPEN								
								OPEN	33	B	34					0.00	PER SLD PER SLD OPEN								
								OPEN	35	C	36					0.00	PER SLD PER SLD OPEN								
								OPEN	37	A	38					0.00	PER SLD PER SLD OPEN								
								OPEN	39	B	40					0.00	PER SLD PER SLD OPEN								
								OPEN	41	C	42					0.00	PER SLD PER SLD OPEN								
4398	0	18669	0	0	236640	0	0.00	TOTALS	4300	0	0	0	0	0	0	108000	0	0	0	0	0	0	0	0	0

LOAD SUMMARY

Ltg	Recept	Motor	Heat	Cool	Other	Kitchen	S/S	Description
8.7	0.0	87.5	0.0	0.0	344.6	0.0	1.0	Connected KVA
1.25	--	1.00	1.00	1.00	1.00	0.65	0.50	Design Factors
10.9	0.0	87.5	0.0	0.0	344.6	0.0	0.5	Design KVA

Phase Load

Ph	KVA
A	138.2
B	136.5
C	136.1

Panel Remarks:

Panel H1DP

Con. KVA: 411.9, 465.4, 413.5, 497.4

Date: 3/8/2024 By: Designer

Job: NOGALES HS ADDITION Job No: W2110000AR AIC Rating: 4200

Mounting SURFACE Main Type: MCB (600A) Neutral: 100% Voltage: 480Y/277V-3PH 4W Main Size: 400 AMPS Equipment Ground: SINGLE

PANEL: H1MA

ALL LOADS IN VA																									
Ltg	Recept	Motor	Heat	Cool	Other	Kitchen	S/S	Description	Amp/P	Wire	Cr. No.	Ph	Cr. No.	Wire	Amp/P	Description	Ltg	Recept	Motor	Heat	Cool	Other	Kitchen	S/S	
								RT-1 ROOF	1	A	2					3200	RT-3 ROOF								
								PER SLD PER SLD	1	A	2					3200	RT-3 ROOF								
									3	B	4					3200									
									5	C	6					3200									
								RT-4 ROOF	7	A	8					3000	RT-2 ROOF								
									9	B	10					3000	RT-2 ROOF								
									11	C	12					3000	RT-2 ROOF								
1466								RT-7 ROOF	13	A	14					625	RT-5 ROOF								
1466									15	B	16					625	RT-5 ROOF								
1466									17	C	18					625	RT-5 ROOF								
								RT-6 ROOF	19	A	20					684	PE-3 ROOF								
									21	B	22					684	PE-3 ROOF								
									23	A	24					684	PE-3 ROOF								
								PE-1 ROOF	25	B	26					684	PE-4 ROOF								
									27	C	28					684	PE-4 ROOF								
								PE-2 ROOF	29	A	30					1260	PE-5 ROOF								
									31	B	32					1260	PE-5 ROOF								
									33	C	34					1260	PE-5 ROOF								
								PE-15 ROOF	35	A	36					11911	RT-15 ROOF								
									37	B	38					11911	RT-15 ROOF								
									39	C	40					11911	RT-15 ROOF								
									41	A	42					0.00	PER SLD PER SLD								
0	0	119376	0	0	0	0	0.00	TOTALS	0	0	0	0	0	0	0	120069	0	0	0	0	0	0	0	0	

LOAD SUMMARY

Ltg	Recept	Motor	Heat	Cool	Other	Kitchen	S/S	Description
0.0	0.0	239.4	0.0	0.0	0.0	0.0	0.0	Connected KVA
1.25	--	1.00	1.00	1.00	1.00	0.65	0.50	Design Factors
0.0	0.0	239.4	0.0	0.0	0.0	0.0	0.0	Design KVA

Phase Load

Ph	KVA
A	79.8
B	79.8
C	79.8

Panel Remarks:

Panel H1MA

Con. KVA: 239.4, 288.0, 239.4, 288.0

Date: 3/8/2024 By: Designer

Job: NOGALES HS ADDITION Job No: W2110000AR AIC Rating: 4200

Mounting SURFACE Main Type: MCB (225A) Neutral: 100% Voltage: 480Y/277V-3PH 4W Main Size: 225 AMPS Equipment Ground: SINGLE

PANEL: H1MB

ALL LOADS IN VA																									
Ltg	Recept	Motor	Heat	Cool	Other	Kitchen	S/S	Description	Amp/P	Wire	Cr. No.	Ph	Cr. No.	Wire	Amp/P	Description	Ltg	Recept	Motor	Heat	Cool	Other	Kitchen	S/S	
								RT-8 ROOF TOP	1	A	2					9100	RT-9 ROOF TOP								
								PER SLD PER SLD	1	A	2					9100	RT-9 ROOF TOP								
									3	B	4					9100									
									5	C	6					9100									
								PE-8 ROOF TOP	7	A	8					1008	PE-9 ROOF TOP								
									9	B	10					1008	PE-9 ROOF TOP								
									11	C	12					1008	PE-9 ROOF TOP								
								RT-16 ROOF TOP	13	A	14					1008	PE-16 ROOF TOP								
									15	B	16					1008	PE-16 ROOF TOP								
									17	C	18					1008	PE-16 ROOF TOP								
								RT-12 ROOF TOP	19	A	20					540	PE-12 ROOF TOP								
									21	B	22					540	PE-12 ROOF TOP								
									23	C	24					540	PE-12 ROOF TOP								
								RT-10 ROOF TOP	25	A	26					540	PE-10 ROOF TOP								
									27	B	28					540	PE-10 ROOF TOP								
									29	C	30					540	PE-10 ROOF TOP								
								RT-13 ROOF TOP	31	A	32					540	PE-13 ROOF TOP								
									33	B	34					540	PE-13 ROOF TOP								
									35	C	36					540	PE-13 ROOF TOP								
								RT-11 ROOF TOP	37	A	38					540	PE-11 ROOF TOP								
									39	B	40					540	PE-11 ROOF TOP								
									41	C	42					540	PE-11 ROOF TOP								
0	0	126270	0	0	0	0	0.00	TOTALS	0	0	0	0	0	0	0	33903	0	0	0	0	0	0	0	0	

LOAD SUMMARY

Ltg	Recept	Motor	Heat	Cool	Other	Kitchen	S/S	Description
0.0	0.0	159.6	0.0	0.0	0.0	0.0	0.0	Connected KVA
1.25	--	1.00	1.00	1.00	1.00	0.65	0.50	Design Factors
0.0	0.0	159.6	0.0	0.0	0.0	0.0	0.0	



RANCHO CUCAMONGA
8163 Rochester Avenue, Suite 100
Rancho Cucamonga, CA 91730
909-987-0909 P

**NOGALES HIGH SCHOOL
NEW BUILDING & AQUATIC CENTER**
ROWLAND UNIFIED SCHOOL DISTRICT
401 NOGALES ST., LA PUENTE, CA 91744



CONSULTANT



8163 Rochester Avenue, Suite 100
Rancho Cucamonga, CA 91730
909-987-0909
leafengineers.com

1	1.25.24	PBK	ADDENDUM 1
2	2.16.24	PBK	ADDENDUM 2
3	2.23.24	PBK	ADDENDUM 3

NO	DATE	BY	DESCRIPTION
REVISIONS			



DRAWN: Art CHECKED: Checker

DATE: 06/28/22 SCALE: 1/8" = 1'-0"

PROJECT NUMBER: 2110000

**FIRE ALARM PANEL
SCHEDULES &
CALCS**

DRAWING NUMBER: **FA5.1**

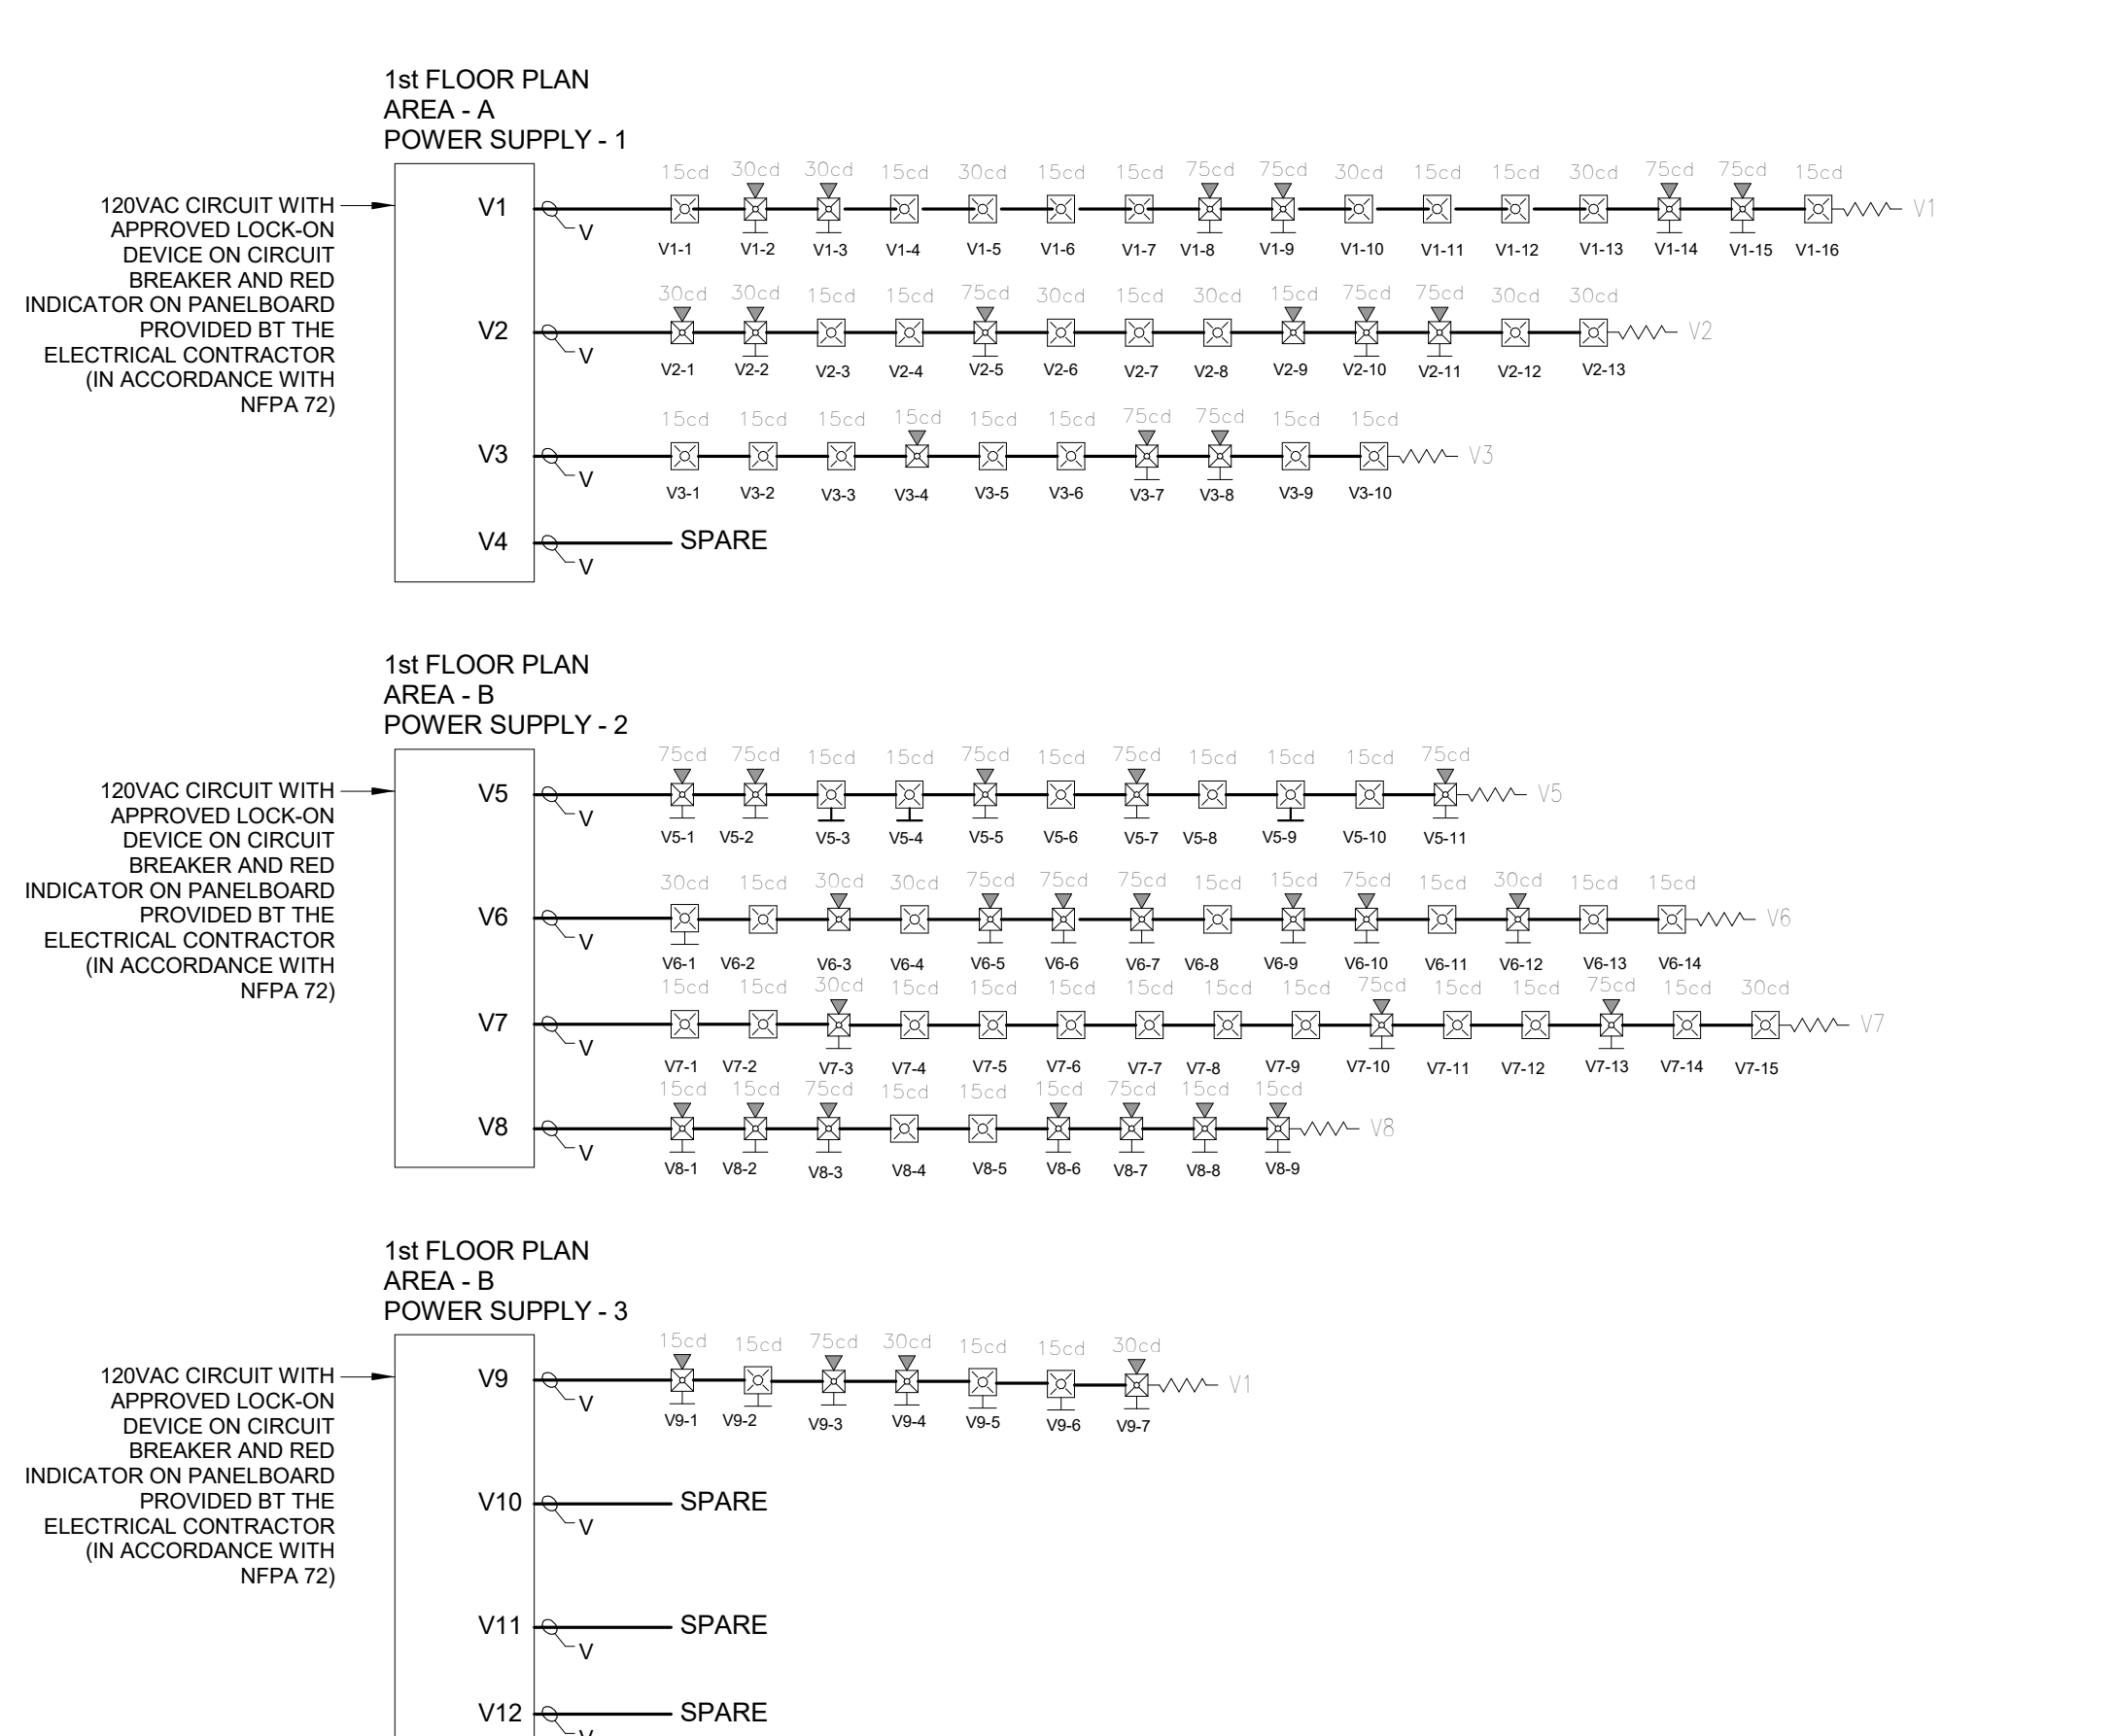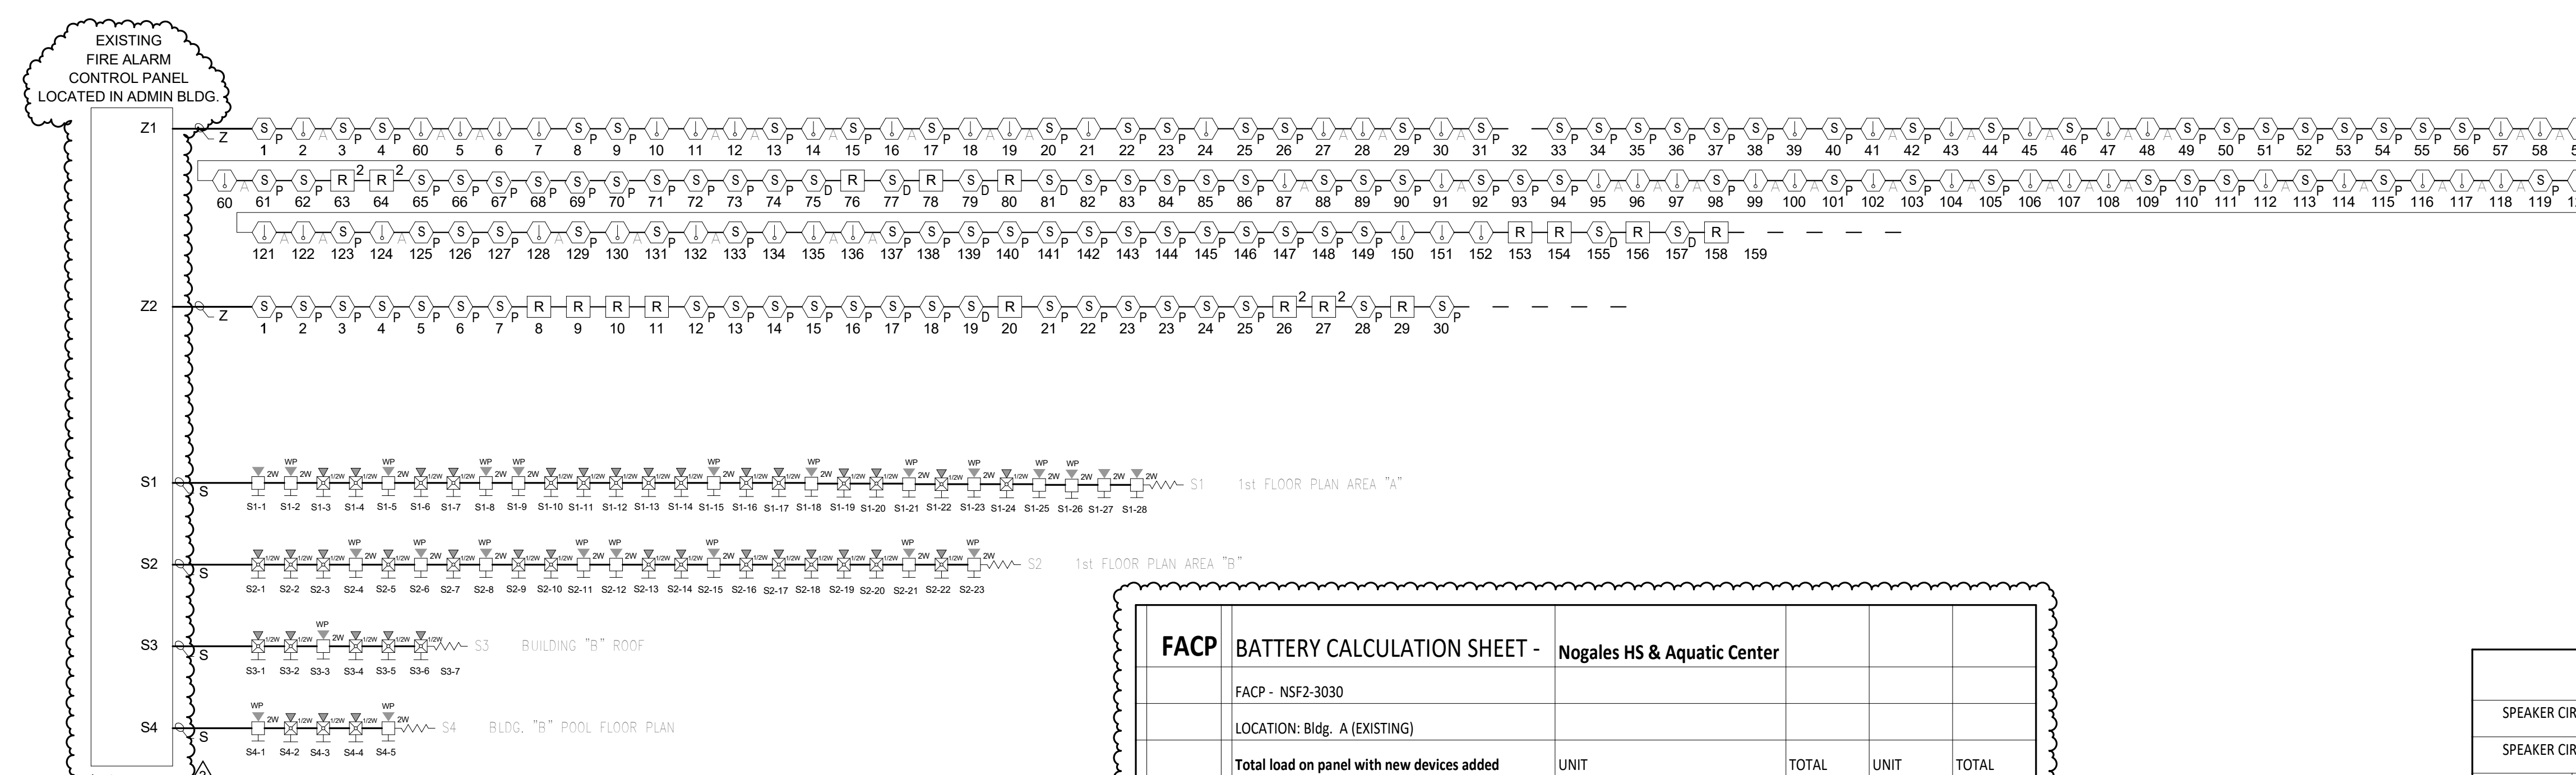

FACP BATTERY CALCULATION SHEET - Nogales HS & Aquatic Center					
FACP - NSF2-3030					
LOCATION: Bldg. A (EXISTING)					
Total load on panel with new devices added					
		UNIT	TOTAL	UNIT	TOTAL
		STANDBY	STANDBY	ALARM	ALARM
QUANTITY		CURRENT(A)	CURRENT(A)	CURRENT(A)	CURRENT(A)
1	CPU2-3030D	0.340000	0.340000	0.340000	0.340000
1	AMP-24	0.130000	0.130000	0.130000	0.130000
5	LCM-320	0.130000	0.650000	0.091000	0.455000
4	LEM-320	0.100000	0.400000	0.091000	0.364000
1	DIALER	0.040000	0.040000	0.100000	0.100000
0	2 SLC W/ DACT	0.016000	0.000000	0.105000	0.000000
1	ACPS-610	0.091300	0.091300	0.092200	0.092200
72	CONTROL RELAY	0.000260	0.018720	0.006500	0.468000
9	DUCT DETECTOR	0.000300	0.002700	0.006800	0.061200
408	SMOKE DETECTOR	0.000300	0.122400	0.006800	2.774400
360	HEAT DETECTOR	0.000300	0.108000	0.006500	2.340000
3	PULL STATION	0.000380	0.001140	0.006400	0.019200
4	DOOR HOLDER	0.020000	0.080000	0.000000	0.000000
0	CO DETECTOR SOUNDER BASE	0.050000	0.000000	0.035000	0.000000
5	MONITOR MODULE	0.000350	0.001750	0.000350	0.001750
50	RELAY MODULE	0.000000	0.000000	0.015000	0.750000
3	REMOTE LED	0.000000	0.000000	0.010000	0.030000
	SUB TOTAL		1.986		7.926
	STANDBY CURRENT x 24 Hrs. (AH)				47.664 AH
	ALARM CURRENT x 15 MINUTES (AH)				1.981 AH
	TOTAL (AH)				49.646 AH
	25% DERATING				12.411 AH
	TOTAL DEMAND (AH)				62.057 AH
	BATTERY PROVIDED	Existing Batteries			100 AH

SPEAKER CIRCUIT LOAD CALCULATION													
SPEAKER CIRCUIT DESCRIPTION		WIRE GAUGE	CIRCUIT VOLTAGE	APPLIANCES QUANTITIES / TAP VALUES				TOTAL LOAD	ESTIMATED LENGTH	ACTUAL WIRE/LOSS	MAXIMUM CKT. LENGTH	TOTAL RESISTANCE	
AMPLIFIER	CIRCUIT LOCATION	CIRCUIT NUMBER	(18, 16, 14 OR 12)	(25 OR 70 VRMS)	TAPPED AT	TAPPED AT	TAPPED AT	(WATT)	(FEET)	(DB)	(FEET)	(OHMS)	
AMP 1	Area "A"	S1	14 AWG	70		17		11	30.50	1500	-0.44	2,050	7.73
	Area "B"	S2	14 AWG	70		15		8	23.50	1000	-0.22	5,200	5.15
	Bulling "B" Pool	S3	14 AWG	70		5		0	2.50	1000	-0.02	1,600	5.15
	spare	S4	14 AWG	70		0		0	0.00	0	0.00	1,600	0.00
TOTAL								56.50					


STROBES WORST CASE VOLTAGE DROP																								
PANEL NAME	CIRCUIT NUMBER	WALL STROBE				CEILING STROBE				WALL SPEAKER/STROBE				CEILING SPEAKER/STROBE				TOTAL CURRENT (AMPS)	TOTAL DISTANCE (FEET)	TOTAL VOLTAGE DROP (%)	TOTAL DEVICES	VOLTAGE DROP	WIRE RESISTANCE	OPERATING VOLTAGE
		15cd	30cd	75cd	95	15cd	30cd	75cd	95cd	15cd	30cd	75cd	95	110	15cd	30cd	75cd							
FAPS-1	V1					6	3			2	4							1.424	500	9.81%	15	2.9192	2.05	17.48
	V2					3	4			1	3			1	1			1.255	850	14.70%	13	4.373675	2.05	16.03
	V3					7						2			1			0.840	1025	11.87%	10	3.5301	2.05	16.87
	V4																	0.000		0.00%	0	0	2.05	20.40
TOTAL		0	0	0	0	16	7	0	0	0	3	9	0	0	2	1	0	0						
FAPS-2	V5					3				3	5							1.073	575	8.50%	11	2.5295975	2.05	17.87
	V6	1				5	1			1	4							1.320	675	12.28%	14	3.6531	2.05	16.75
	V7					11	1			1	2							1.232	800	13.58%	15	4.04096	2.05	16.36
	V8					2				5	2							0.714	750	7.38%	9	2.19555	2.05	18.20
TOTAL		0	1	0	0	21	2	0	0	9	2	13	0	0	0	1	0	0						
FAPS-3	V9	3								1	2	1						0.542	350	2.61%	7	0.77777	2.05	19.62
	V10																	0.000		0.00%	0	0	2.05	20.40
	V11																	0.000		0.00%	0	0	2.05	20.40
	V12																	0.000		0.00%	0	0	2.05	20.40
TOTAL		3	0	0	0	0	0	0	0	1	2	1	0	0	0	0	0							

BATTERY CAPACITY CALCULATION SHEET					
FAPS-1					
LOCATION: Area "A"					
		Unit	Total	Unit	Total
		Standby	Standby	Alarm	Alarm
QUANTITY	Description	Current(A)	Current(A)	Current(A)	Current(A)
1	NAC TRIP	0.075	0.075	0.175	0.175
1	Amps Calculated from Strobe calc sheet	0.000	0.000	3.520	3.520
	Sub Total			0.075	3.695
	A - Battery Backup - Standby (Hour)		24		
	B - Battery Backup (minutes)		15		
	C - Allowable Error (%)		25		
	D - Total Standby Backup (Amp-Hour)		1.800		
	E - Total Alarm Backup (Amp-Hour)		0.924		
	F - Allowable Error (C x (D + E))		0.681		
	Total Amp-Hour Required (D + E + F)		3.405		
	Battery Submitted		7 Amp-Hour		

BATTERY CAPACITY CALCULATION SHEET					
FAPS-2					
LOCATION: Area "B"					
		Unit	Total	Unit	Total
		Standby	Standby	Alarm	Alarm
QUANTITY	Description	Current(A)	Current(A)	Current(A)	Current(A)
1	NAC TRIP	0.075	0.075	0.175	0.175
1	Amps Calculated from Strobe calc sheet	0.000	0.000	4.340	4.340
	Sub Total			0.075	4.515
	A - Battery Backup - Standby (Hour)		24		
	B - Battery Backup (minutes)		15		
	C - Allowable Error (%)		25		
	D - Total Standby Backup (Amp-Hour)		1.800		
	E - Total Alarm Backup (Amp-Hour)		1.129		
	F - Allowable Error (C x (D + E))		0.732		
	Total Amp-Hour Required (D + E + F)		3.661		
	Battery Submitted		7 Amp-Hour		


BATTERY CAPACITY CALCULATION SHEET					
FAPS-3					
LOCATION: AREA "B"					
		Unit	Total	Unit	Total
		Standby	Standby	Alarm	Alarm
QUANTITY	Description	Current(A)	Current(A)	Current(A)	Current(A)
1	NAC TRIP	0.075	0.075	0.175	0.175
1	Amps Calculated from Strobe calc sheet	0.000	0.000	0.542	0.542
	Sub Total			0.075	0.717
	A - Battery Backup - Standby (Hour)		24		
	B - Battery Backup (minutes)		15		
	C - Allowable Error (%)		25		
	D - Total Standby Backup (Amp-Hour)		1.800		
	E - Total Alarm Backup (Amp-Hour)		0.179		
	F - Allowable Error (C x (D + E))		0.495		
	Total Amp-Hour Required (D + E + F)		2.474		
	Battery Provided		7 Amp-Hour		

8/20/24 10:02 AM
 C:\Users\jmorris\Documents\2024\NHS - FACP - Control Panel.kwd

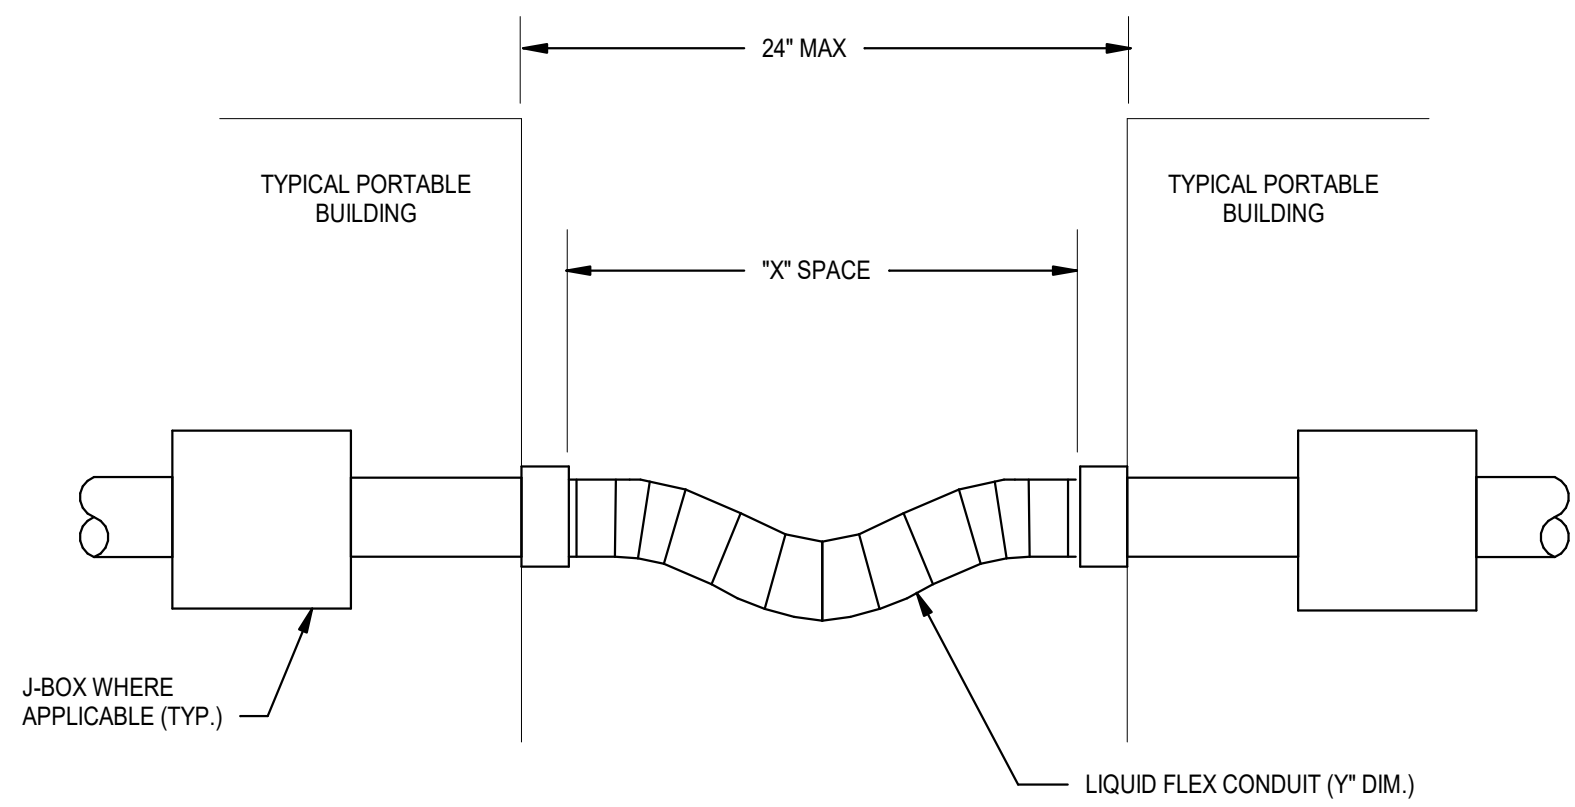


CONDUIT SIZE	X" SPACE	Y" FLEX LENGTH
3/4" - 2"	18"	+30"


10 seismic
12" = 1'-0"

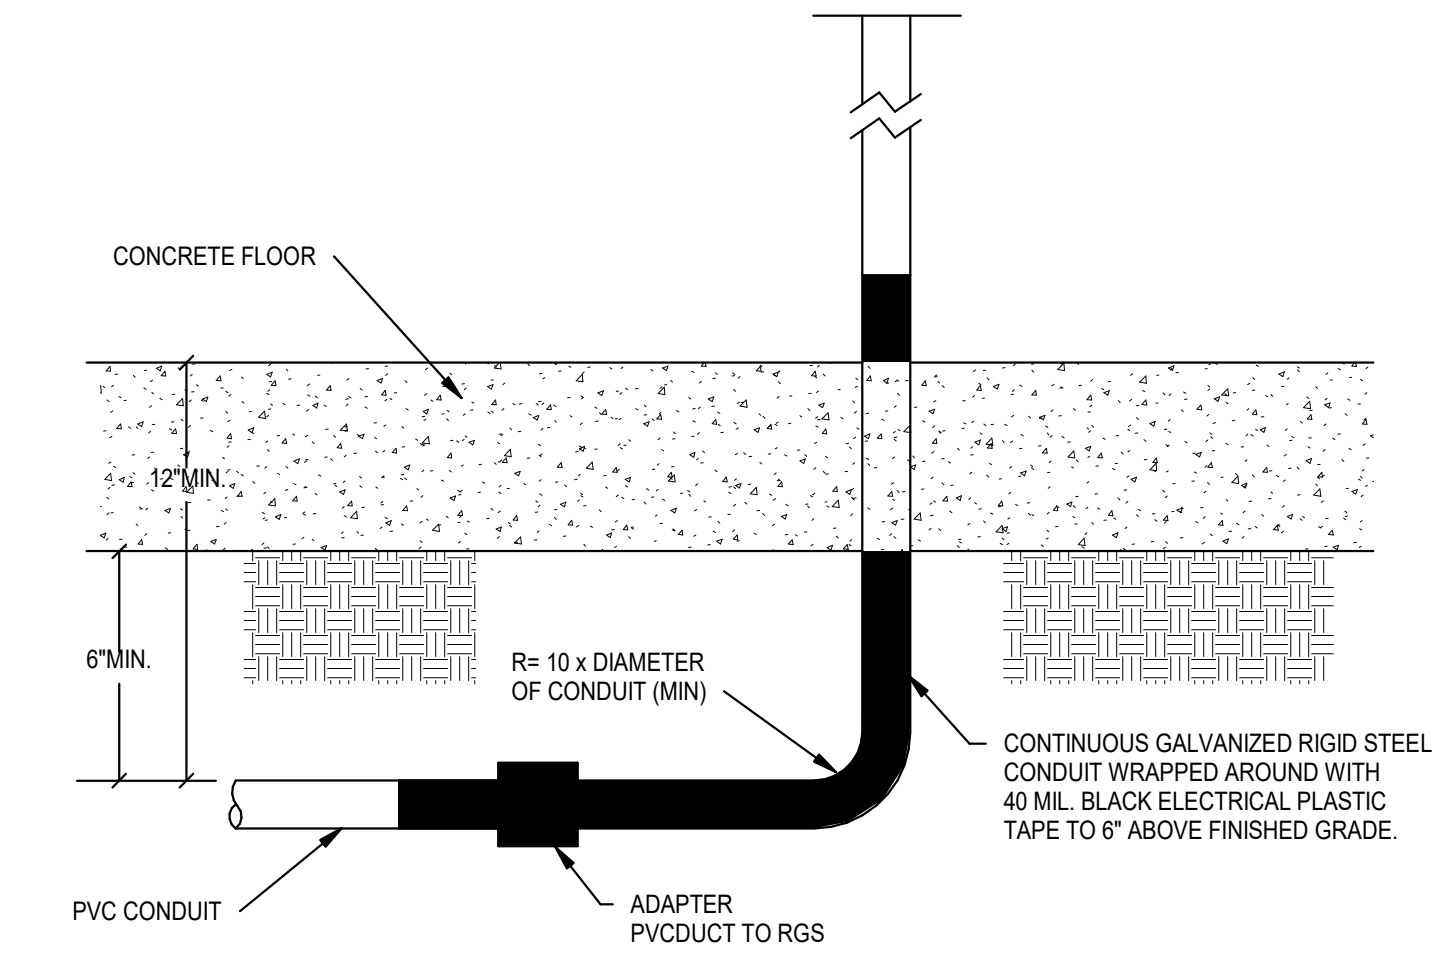

1 CONDUIT RISER DETAIL
12" = 1'-0"

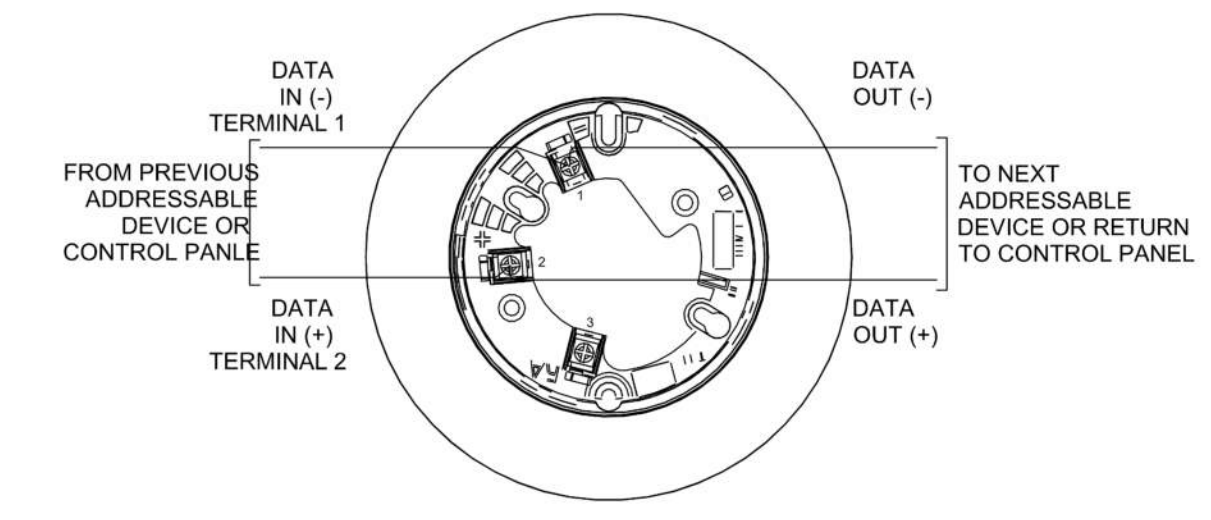


9 SMOKE/HEAT DETECTOR DETAIL (TYP.)
NOT TO SCALE

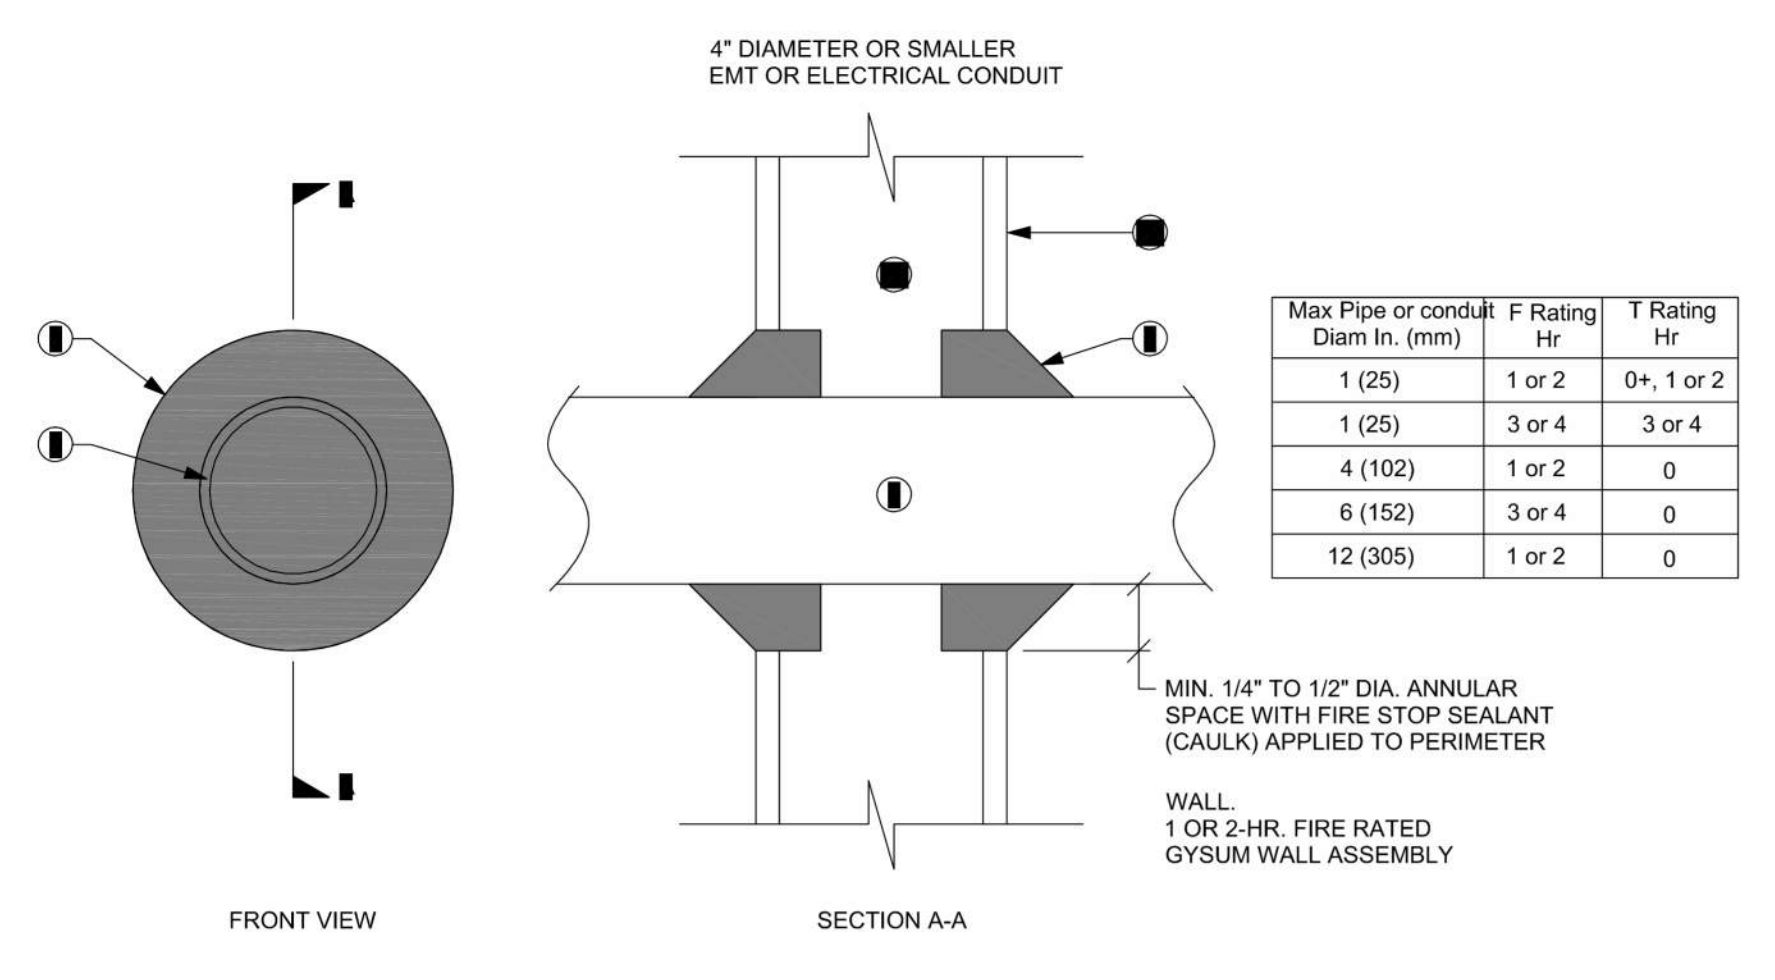


Max Pipe or conduit (diam in. (mm))	F Rating Hr	T Rating Hr
1 (25)	1 or 2	0+ 1 or 2
1 (25)	3 or 4	3 or 4
4 (102)	1 or 2	0
6 (152)	3 or 4	0
12 (305)	1 or 2	0

- DETAIL NOTES:**
- WALL CONSTRUCTION:
A. STEEL STUDS PER ARCHITECTURAL/STRUCTURAL.
B. 5/8" TYPE X GYPSUM BOARD PER ARCHITECTURAL.
 - CONDUIT SIZE PER DRAWINGS.
 - FIRE STOP SYSTEM - ONE HOUR CAULK, APPLY TO INTERFACE WITH WALL SURFACE.
- U.L. SYSTEM NO. W-1-1001
- NOTE:**
MAX. DIA. OF OPENING IS 1 1/2" ANNULAR SPACE OF MIN. 1/4" DIA. BEAD IS REQUIRED.


7 CONDUIT PENETRATION AT 1-HR FIRE RATED WALL DETAIL (TYP.)
NOT TO SCALE

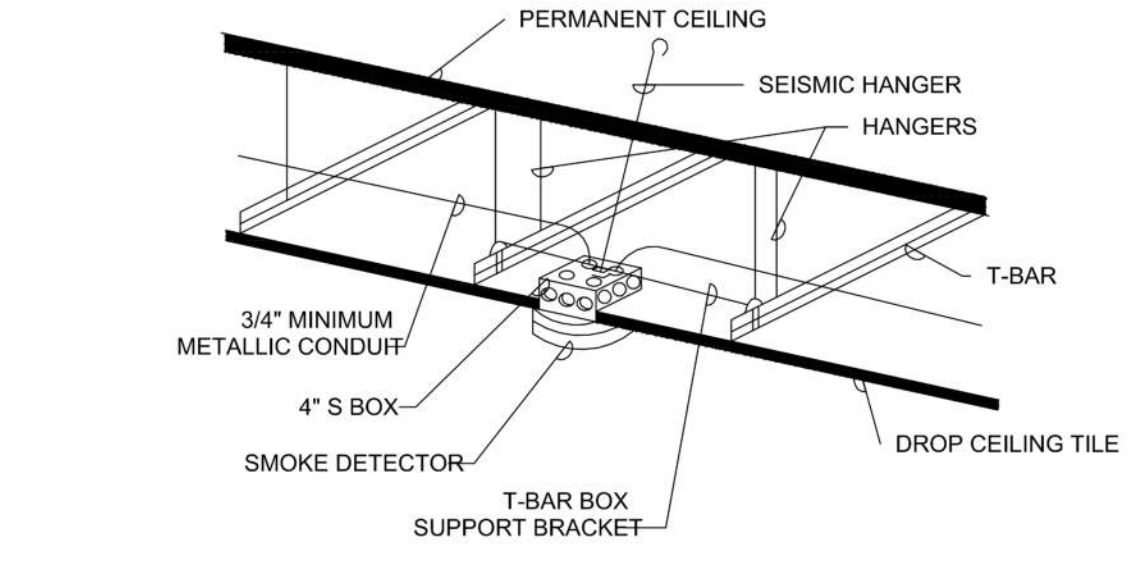


8 DROP CEILING DEVICE INSTALLATION DETAIL (TYP.)
NOT TO SCALE

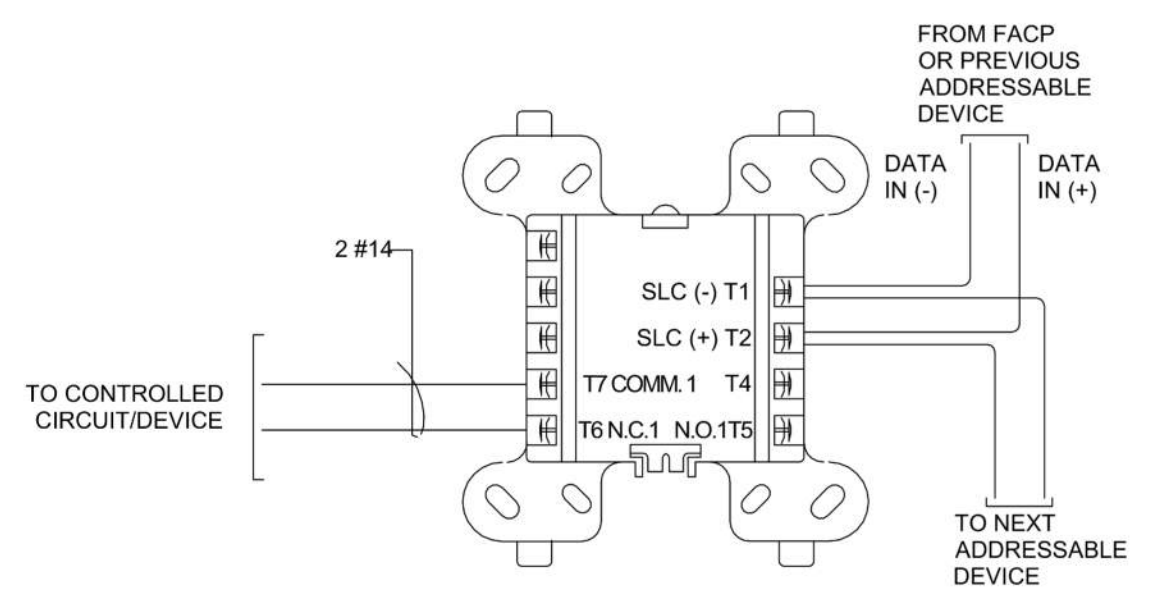

6 RELAY MODULE DETAIL (TYP.)
NOT TO SCALE

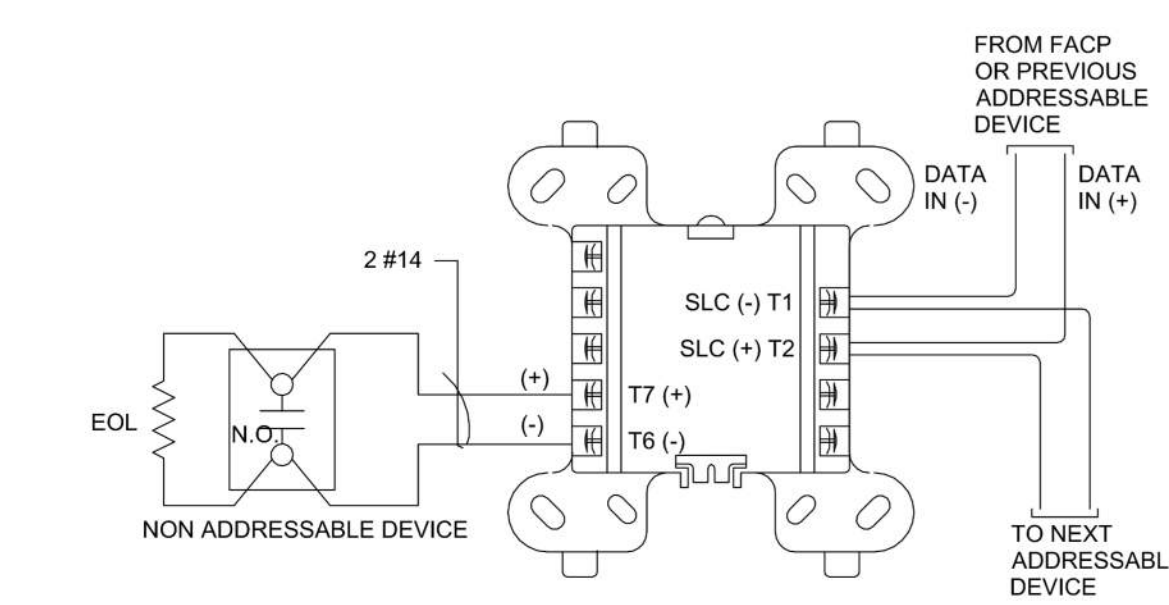

5 MONITOR MODULE DETAIL (TYP.)
NOT TO SCALE

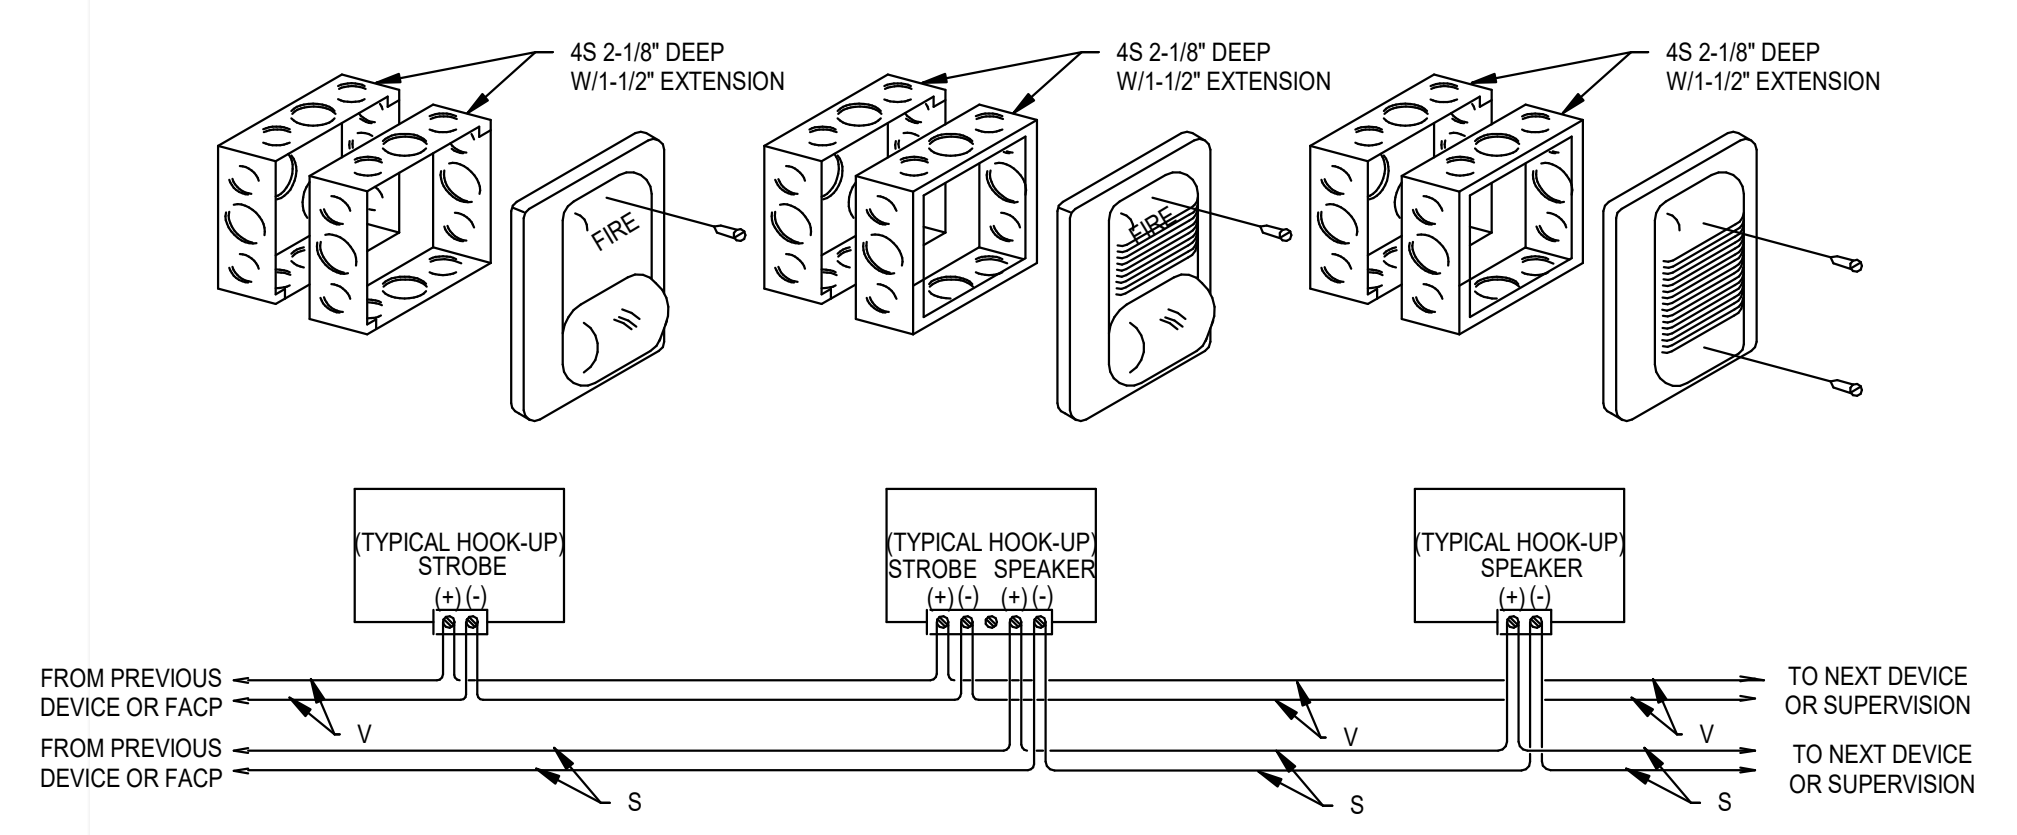


4 SPEAKER/STROBE DETAIL
12" = 1'-0"



RANCHO CUCAMONGA
8163 Rochester Avenue, Suite 100
Rancho Cucamonga, CA 91730
909-987-0909 P

**NOGALES HIGH SCHOOL
NEW BUILDING & AQUATIC CENTER**
ROWLAND UNIFIED SCHOOL DISTRICT
401 NOGALES ST., LA PUENTE, CA 91744

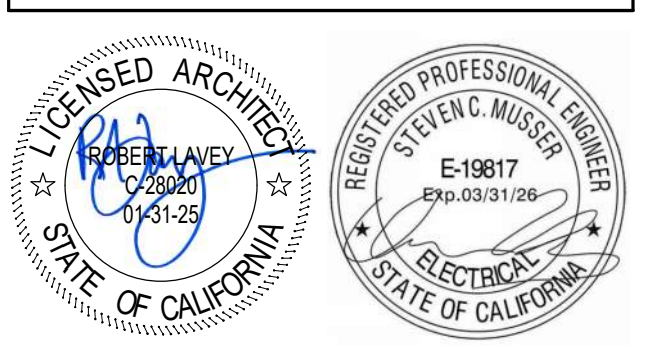

CONSULTANT
LEAF ENGINEERS
8163 Rochester Avenue, Suite 100
Rancho Cucamonga, CA 91730
909-987-0909
leafengineers.com


1	1.25.24	PBK	ADDENDUM 1
2	2.16.24	PBK	ADDENDUM 2
3	2.23.24	PBK	ADDENDUM 3

NO	DATE	BY	DESCRIPTION
REVISIONS			

DRAWN: Author CHECKED: Checker
DATE: 06/28/22 SCALE: 12" = 1'-0"
PROJECT NUMBER: 2110000

**FIRE ALARM
DETAILS**

DRAWING NUMBER: **FA6.1**

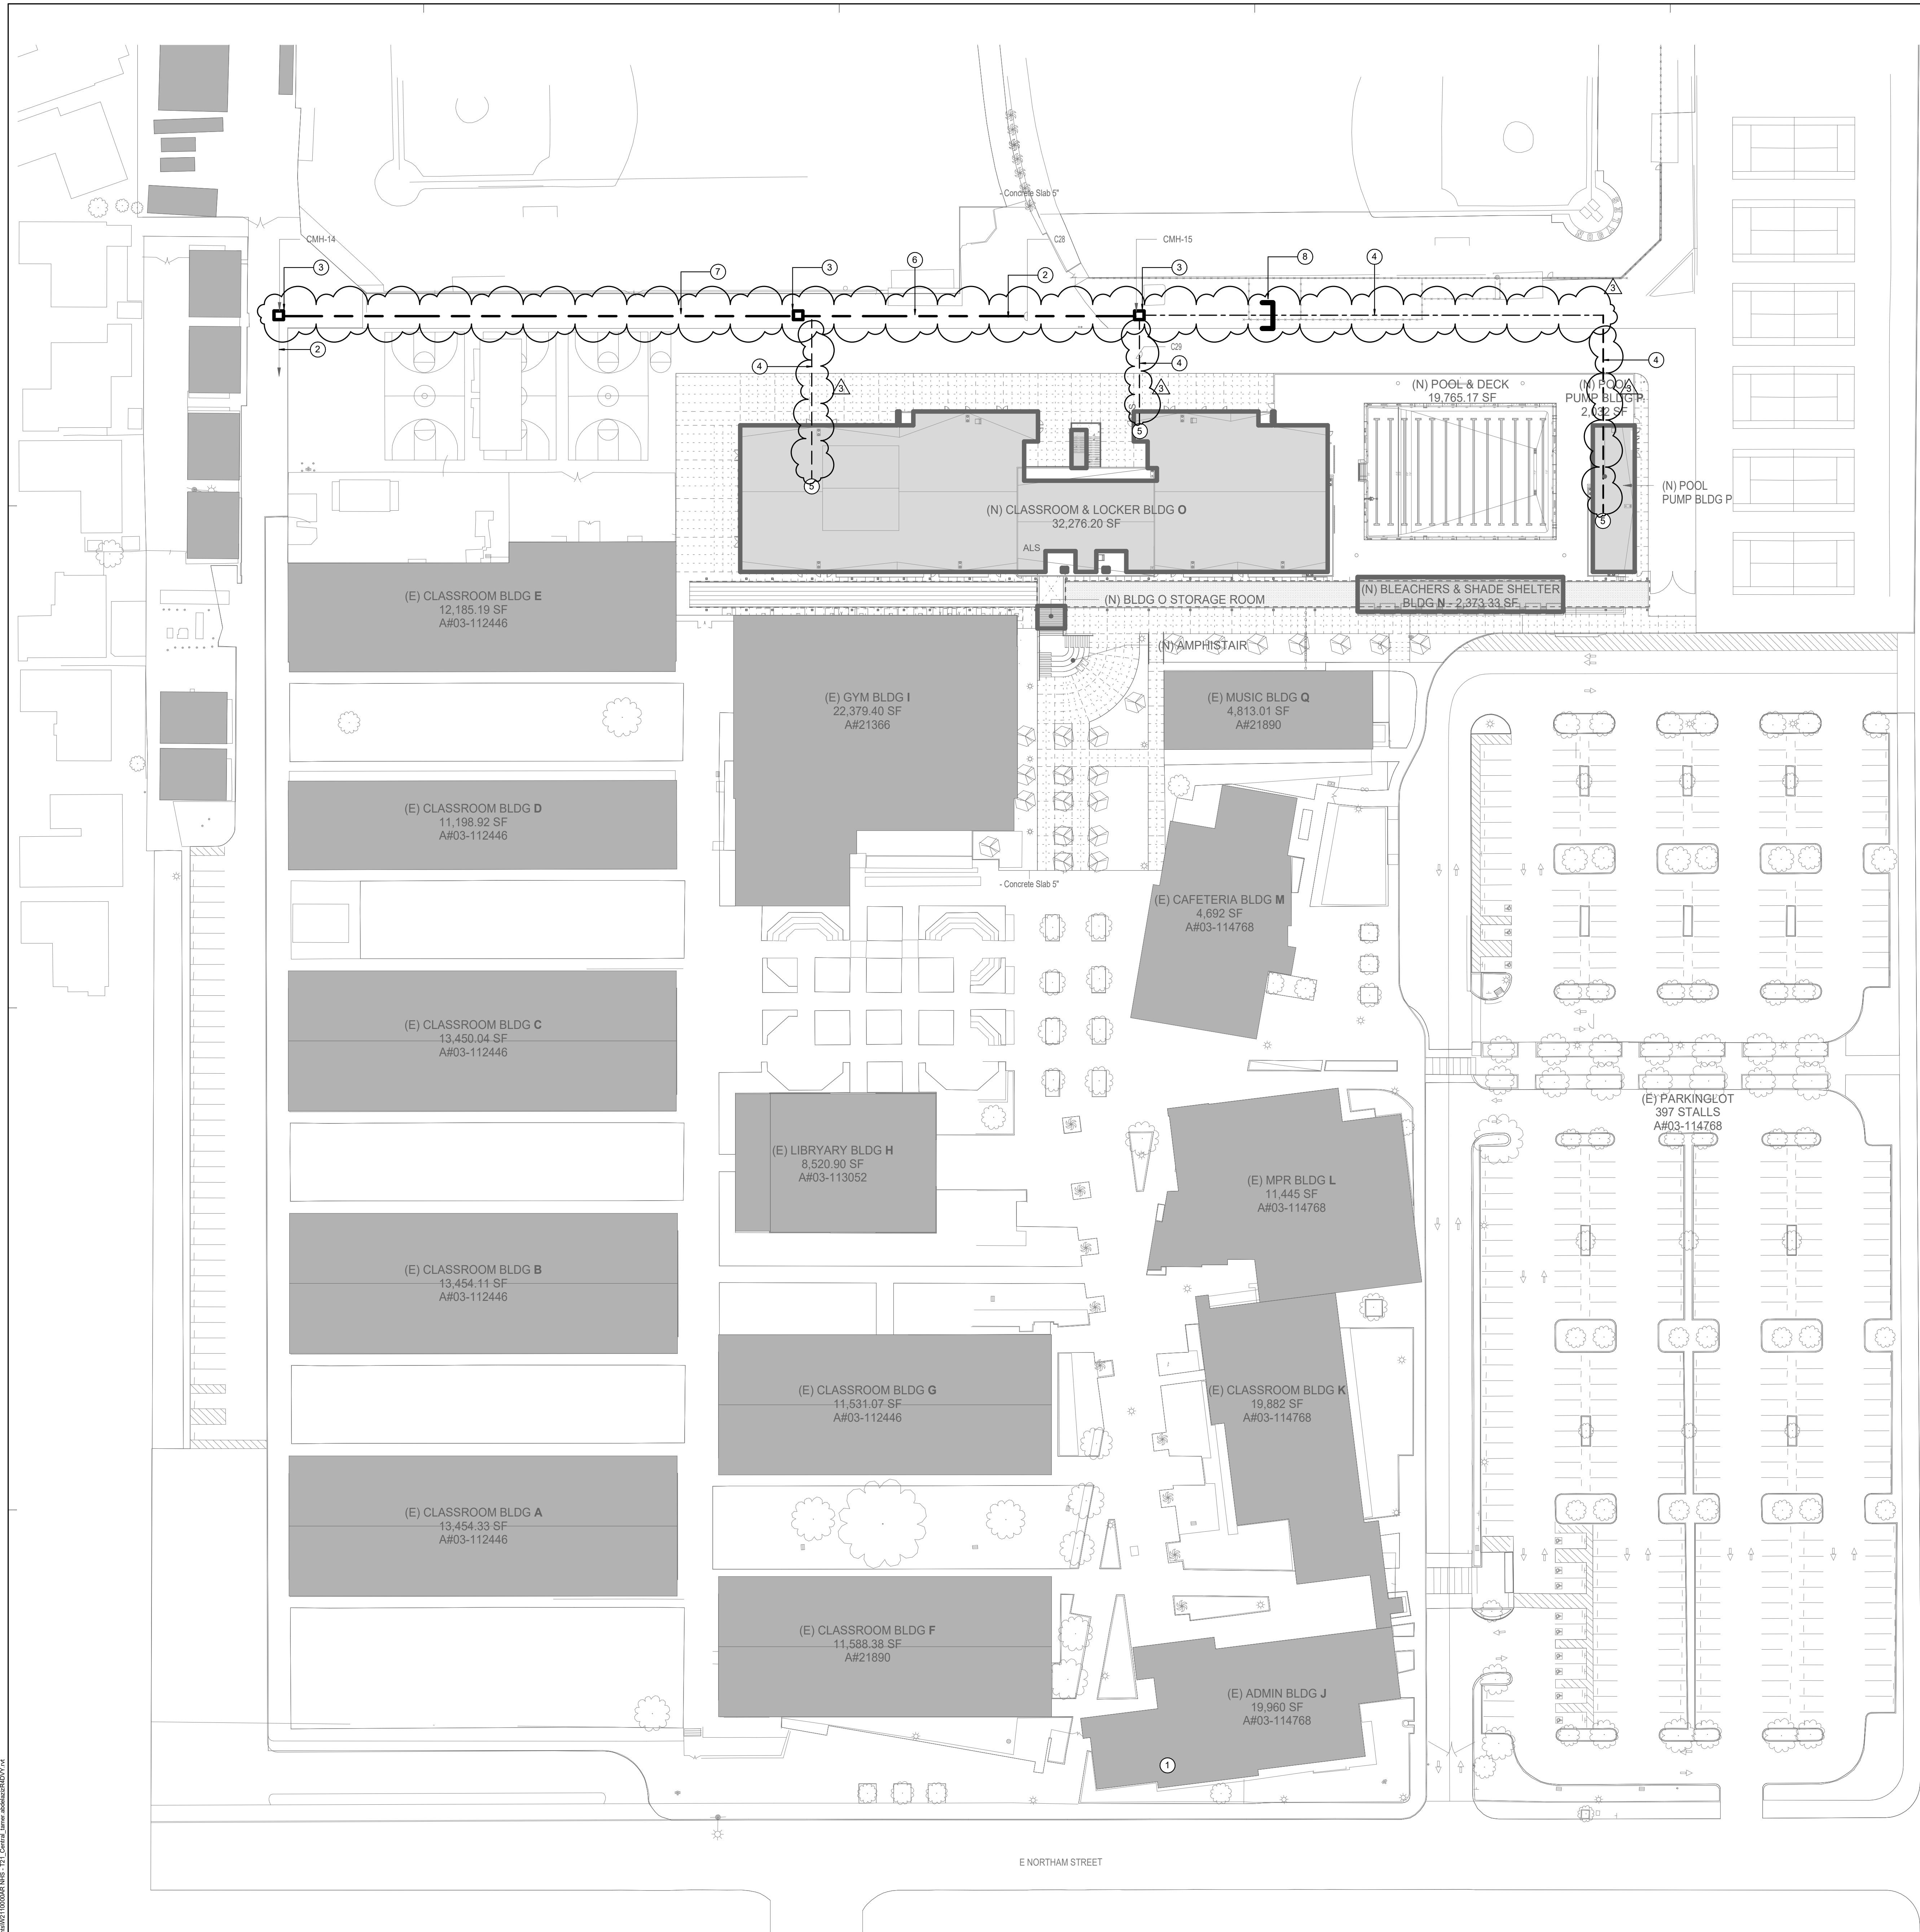


- TECHNOLOGY KEYED NOTES**
1. INDICATES THE APPROXIMATE LOCATION OF THE EXISTING MDF.
 2. INDICATES THE APPROXIMATE PATHWAY OF EXISTING UNDERGROUND CONDUIT. REFER TO RECORD DRAWING FOR CONTINUATION OF (E) UNDERGROUND CONDUITS TO THE (E) MDF LOCATION.
 3. INDICATES THE APPROXIMATE LOCATION OF A 3'X3'X3' EXISTING UNDERGROUND PULLBOX.
 4. INDICATES THE APPROXIMATE PATHWAY OF NEW UNDERGROUND 2" CONDUIT WITH 3-CELL MAXCELL INNERDUCT. CONDUIT IS TO BE RESERVED FOR NEW FIBER THAT WILL SERVE UP IDF.
 5. INDICATES THE APPROXIMATE LOCATION OF A NEW IDF. CONTRACTOR TO STUB UP AT THIS LOCATION TO SERVE NEW IDF.
 6. PROVIDE 12 STRAND SINGLE MODE FIBER, 6 STRAND MULTI MODE FIBER FROM MDF TO NEW IDF'S FIBER MUST BE DIRECT BURIAL LI. RATED 3M SERVICE LOOP AT BOTH ENDS OF TERMINATION, 25 PAIR DIRECT BURIAL COPPER FEEDER.
 7. CONTRACTOR TO REMOVE UNUSED WIRING TO THE PANEL.
 8. (E) STUB OUT - FIELD VERIFY LOCATION.



RANCHO CUCAMONGA
8163 Rochester Avenue, Suite 100
Rancho Cucamonga, CA 91730
909-987-0909 P

**NOGALES HIGH SCHOOL
NEW BUILDING & AQUATIC CENTER**
ROWLAND UNIFIED SCHOOL DISTRICT
401 NOGALES ST, LA PUENTE, CA 91744

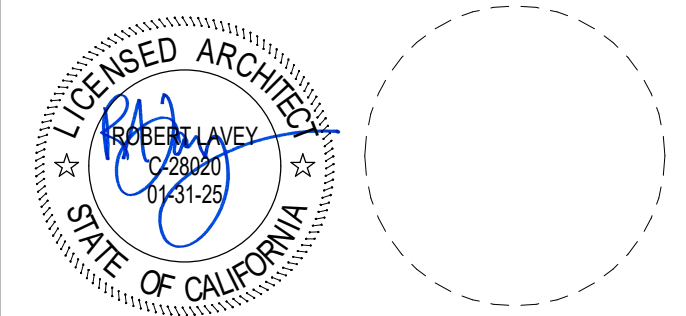

CONSULTANT
LEAF ENGINEERS
8163 Rochester Avenue, Suite 100
Rancho Cucamonga, CA 91730
909-987-0909
leafengineers.com

NO	DATE	BY	DESCRIPTION
1	Date 1		Revision 1
2	2/16/24		ADD2
3	2/11/24		ADD03
REVISIONS			

DRAWN: Author CHECKED: Checker
DATE: 06/24/22 SCALE: As indicated
PROJECT NUMBER: 2110000

**TECHNOLOGY SITE
PLN**

DRAWING NUMBER: **T1.1**

3/2/2025 1:00:29 PM C:\Users\mccorcoran\OneDrive\Documents\11000000\NHS_T1_SitePlan.dwg 400x600R2507.rvt